

WW-7  
8-30-06



West Virginia Department of Environmental Protection  
Office of Oil and Gas  
**WELL LOCATION FORM: GPS**

API: 4704901397 WELL NO.: L64

FARM NAME: Raber

RESPONSIBLE PARTY NAME: CNX Gas Company

COUNTY: Marion DISTRICT: Mannington

QUADRANGLE: Mannington

SURFACE OWNER: Brenda J Raber

ROYALTY OWNER: \_\_\_\_\_

UTM GPS NORTHING: 4383762.93

UTM GPS EASTING: 555397.40 GPS ELEVATION: 394.89 m / 1295.58 ft

The Responsible Party named above has chosen to submit GPS coordinates in lieu of preparing a new well location plat for a plugging permit or assigned API number on the above well. The Office of Oil and Gas will not accept GPS coordinates that do not meet the following requirements:

- Datum: NAD 1983, Zone: 17 North, Coordinate Units: meters, Altitude: height above mean sea level (MSL) – meters.
- Accuracy to Datum – 3.05 meters
- Data Collection Method:

Survey grade GPS \_\_\_\_\_: Post Processed Differential \_\_\_\_\_

Real-Time Differential \_\_\_\_\_

Mapping Grade GPS : Post Processed Differential

Real-Time Differential \_\_\_\_\_

- Letter size copy of the topography map showing the well location.**

I the undersigned, hereby certify this data is correct to the best of my knowledge and belief and shows all the information required by law and the regulations issued and prescribed by the Office of Oil and Gas.

Signature


Project MANAGER  
Title

12-12-19  
Date

RECEIVED  
Office of Oil and Gas

DEC 17 2019

WV Department of  
Environmental Protection

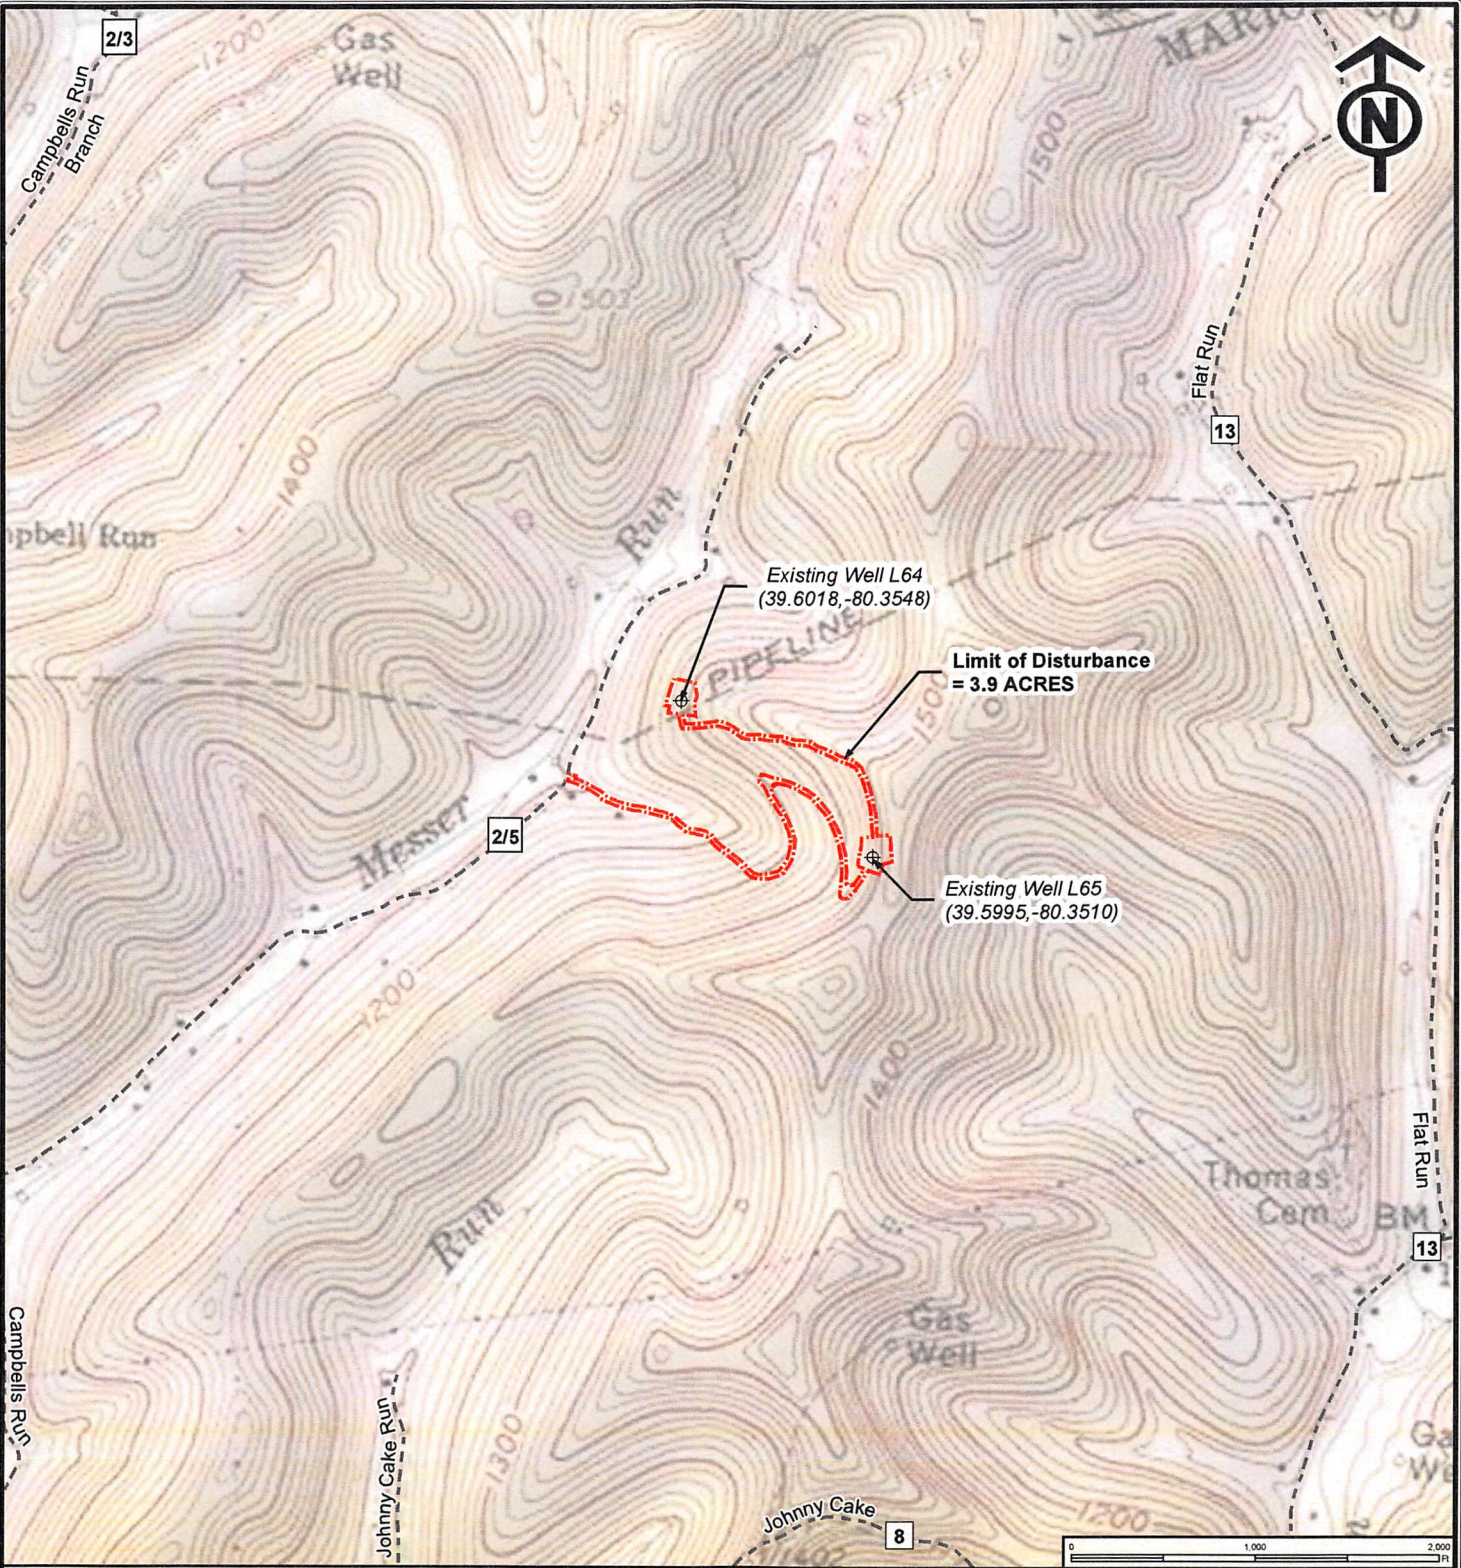

**LEGEND**

- ⊕ Existing Well
- - - - Limit of Disturbance
- - - - Roads

Prepared By:

**KEYSTONE**  
CONSULTANTS INC.  
www.keystoneconsultants.net 412-278-2100

REV	DESCRIPTION	DATE

DWN BY: GDM   APR BY: RDM   DATE: 10/2/2019

**L64, L65 Well Plugging**  
Site Location Topographic Map

Marion County, WV

DRAWING NUMBER: 001

SCALE: 1" = 1,000 feet   SHEET: 1 OF 2