

WW-7
8-30-06



West Virginia Department of Environmental Protection
Office of Oil and Gas

WELL LOCATION FORM: GPS

API: 4704901558 WELL NO.: 2D3

FARM NAME: McDowell William

RESPONSIBLE PARTY NAME: CNX Gas Company

COUNTY: Marion DISTRICT: Mannington

QUADRANGLE: Hundred

SURFACE OWNER: McDowell William E & Alice K

ROYALTY OWNER: _____

UTM GPS NORTHING: 4387142.49

UTM GPS EASTING: 553267.92 GPS ELEVATION: 428.01 m / 1404.22 ft

The Responsible Party named above has chosen to submit GPS coordinates in lieu of preparing a new well location plat for a plugging permit or assigned API number on the above well. The Office of Oil and Gas will not accept GPS coordinates that do not meet the following requirements:

1. Datum: NAD 1983, Zone: 17 North, Coordinate Units: meters, Altitude: height above mean sea level (MSL) – meters.
2. Accuracy to Datum – 3.05 meters
3. Data Collection Method:

Survey grade GPS _____ : Post Processed Differential _____

Real-Time Differential _____

Mapping Grade GPS X : Post Processed Differential X

Real-Time Differential _____

4. **Letter size copy of the topography map showing the well location.**

I the undersigned, hereby certify this data is correct to the best of my knowledge and belief and shows all the information required by law and the regulations issued and prescribed by the Office of Oil and Gas.

Raymond [Signature]
Signature


Project MANAGER
Title

2-12-2020
Date

RECEIVED
Office of Oil and Gas

FEB 13 2020

WV Department of
Environmental Protection

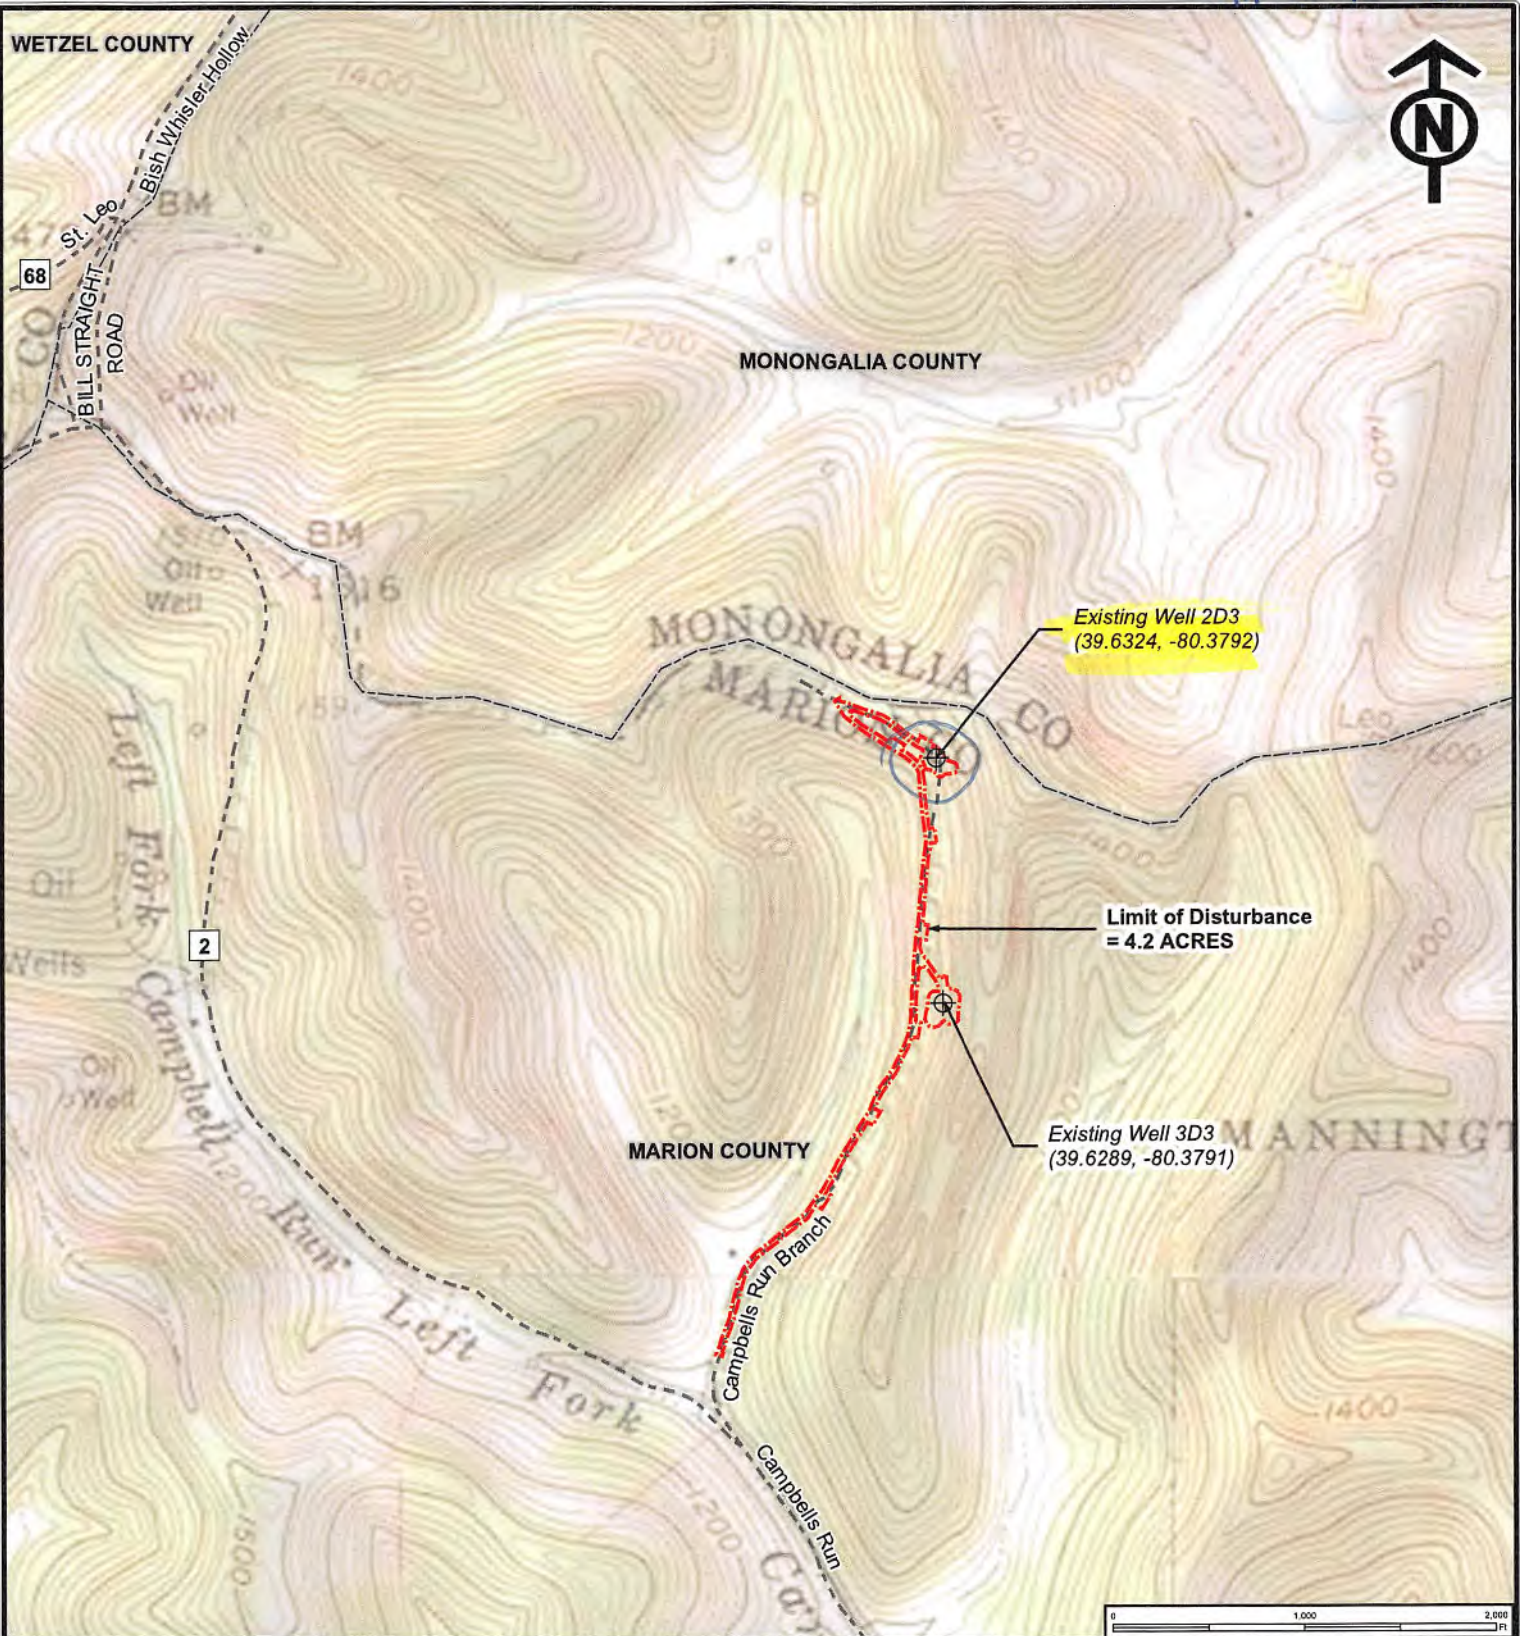


RECEIVED
 Office of Oil and Gas
 FEB 13 2020
 WV Department of
 Environmental Protection

- LEGEND**
- Existing Well
 - Limit of Disturbance
 - Road
 - County Boundary

Prepared By: **KEYSTONE CONSULTANTS INC**
 www.keystoneconsultants.net 412-278-2100

REV	DESCRIPTION	DATE

DWN BY: AMW APR BY: STK DATE: 11/13/2019



**2D3/3D3 Well Plugging
Site Location Topographic Map**

Marion County, WV

DRAWING NUMBER: 001

SCALE: 1" = 1,000 feet SHEET: 1 OF 2

BASEMAP: USGS TOPOGRAPHIC QUADRANGLE HUNDRED, WADESTOWN, GLOVER GAP, MANNINGTON, WV
 Roads: West Virginia Department of Transportation(WVDOT) <https://transportation.wv.gov>