



West Virginia Department of Environmental Protection
Office of Oil and Gas

WELL LOCATION FORM: GPS

API: 4704901664 WELL NO.: 5D1 CCR

FARM NAME: Ronald E. Gooch & Lisa A. Gooch

RESPONSIBLE PARTY NAME: CNX

COUNTY: Marion DISTRICT: Mannington

QUADRANGLE: Mannington

SURFACE OWNER: Speerhas Annette M

ROYALTY OWNER: Speerhas Annette M

UTM GPS NORTHING: 4385355.04

UTM GPS EASTING: 554845.61 GPS ELEVATION: 1213.85

The Responsible Party named above has chosen to submit GPS coordinates in lieu of preparing a new well location plat for a plugging permit or assigned API number on the above well. The Office of Oil and Gas will not accept GPS coordinates that do not meet the following requirements:

1. Datum: NAD 1983, Zone: 17 North, Coordinate Units: meters, Altitude: height above mean sea level (MSL) – meters.
2. Accuracy to Datum – 3.05 meters
3. Data Collection Method:

Survey grade GPS : Post Processed Differential _____
Real-Time Differential

Mapping Grade GPS _____ : Post Processed Differential _____
Real-Time Differential _____

4. **Letter size copy of the topography map showing the well location.**

I the undersigned, hereby certify this data is correct to the best of my knowledge and belief and shows all the information required by law and the regulations issued and prescribed by the Office of Oil and Gas.

Signature



Project manager
Title

12-3-20
Date

03/19/2021

4704901664P

22

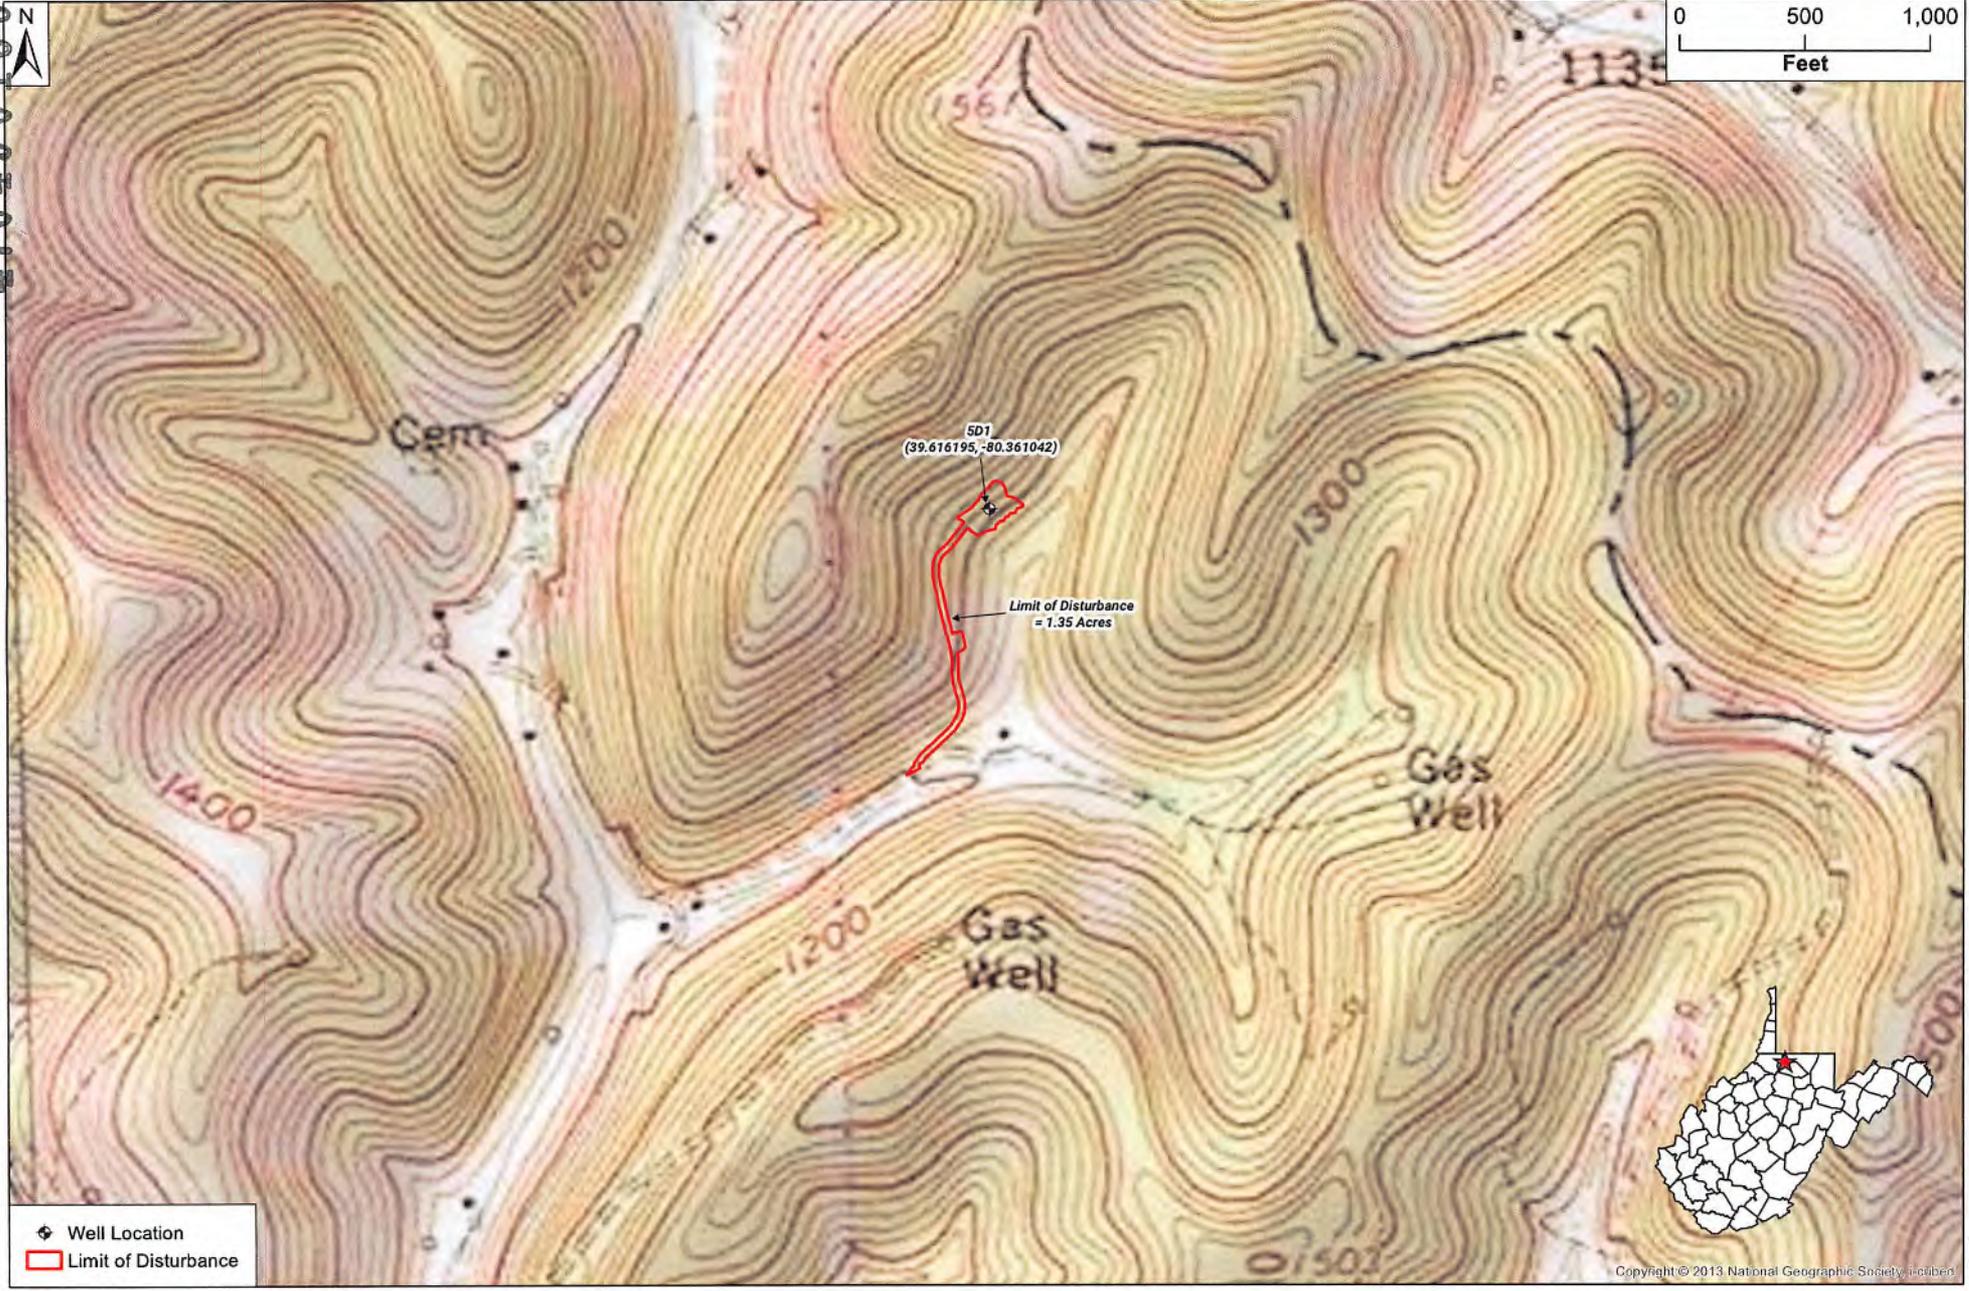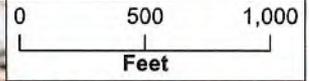

- ◆ Well Location
- Limit of Disturbance



Copyright © 2013 National Geographic Society, Inc.



5D1 CCR Well Head
Site Location Topographic Map
Marion County, West Virginia



Date: 11/19/21
By: J. Stascek