

Company **INTERSTATE PIPE & SUPPLY CO.**
 Address **Fourth and Church Sts., Marietta, Ohio.**
 Farm **Frank S. Snyder and Snyder & Metz Leases**
 Tract **Acres 133** Lease No. _____
 Well (Farm) No. **1, 2, 3 and 4** Serial No. _____
 Elevation (Spirit Level) **No. 1-1170, No. 2-1240, No. 3-1135, No. 4-** _____
 Quadrangle **Mannington** _____ 1410'
 County **Marion** District **Mannington**
 Engineer **W. H. ...**
 Engineer's Registration No. **1227**
 File No. _____ Drawing No. _____
 Date **September, 1950** Scale **1" = 500'**

STATE OF WEST VIRGINIA
 DEPARTMENT OF MINES
 OIL AND GAS DIVISION
 CHARLESTON

WELL LOCATION MAP
 MAR-677-A-#2
 FILE NO. MAR-678-A-#1
 MAR-679-A-#1-2v-4
 MAR-680-A-#3

+ Denotes location of well on United States Topographic Maps, scale 1 to 62,500, latitude and longitude lines being represented by border lines as shown.

- Denotes one inch spaces on border line of original tracing.



768

STATE OF WEST VIRGINIA
DEPARTMENT OF MINES
OIL AND GAS DIVISION

WELL RECORD

Permit No.

Ab 678-A ^{now} → 2086

Oil or Gas Well

(KIND)


Company The Interstate Pipe & Supply Company
 Address F. O. Box 518, Marietta, Ohio
 Farm Frank Snyder Acres 132
 Location (waters) Elkins Run
 Well No. 1 Elev. 1170'
 District Hamington County Marion
 The surface of tract is owned in fee by Jerry & Martha Hland
Route 1 Address Hamington, W. Va.
 Mineral rights are owned by The Chesapeake & Coastal Pipe, Trustee
Elkins Run Address Elkins Run
 Drilling commenced by Edward G. Simpson Company
 Drilling completed Box 348, Fairmont, West Virginia
 Date Shot _____ From _____ To _____
 With _____

Casing and Tubing	Used in Drilling	Left in Well	Packers
Size			
16			Kind of Packer
13			
10	309	309	Size of
8 1/4	1485	2000	
6 1/2	2110	2110	Depth set
5 3/16	2700	2700	
			Perf. top
			Perf. bottom
Liners Used			Perf. top
			Perf. bottom

Open Flow _____ /10ths Water in _____ Inch
 _____ /10ths Merc. in _____ Inch
 Volume _____ Cu. Ft.
 Rock Pressure _____ lbs. _____ hrs.
 Oil _____ bbls., 1st 24 hrs.
 Fresh water _____ feet _____ feet
 Salt water _____ feet _____ feet

CASING CEMENTED _____ SIZE _____ No. Ft. _____ Date _____
 COAL WAS ENCOUNTERED AT 995 FEET 96 INCHES
 _____ FEET _____ INCHES _____ FEET _____ INCHES
 _____ FEET _____ INCHES _____ FEET _____ INCHES

Formation	Color	Hard or Soft	Top	Bottom	Oil, Gas or Water	Depth Found	Remarks
Pittsburgh Coal			995	1003			
Little Buckard Sand			1410	1430			
Big Buckard Sand			1480	1510			
Big Sand			1600	1650			
First Salt Sand			1730	1780			
Second Salt Sand			1785	1835			
Third Salt Sand			1835	1935			
Mass Sand			2160	2255			
Little Line			2250	2255			
Small Cove			2255	2260			
Big Line			2260	2265			
Big Injan Sand			2325	2360			
Oil				2605			
Fifty Foot Sand			296	305			
Thirty Foot Sand			305	305			
Oil			305	305			
Total Depth				3060			

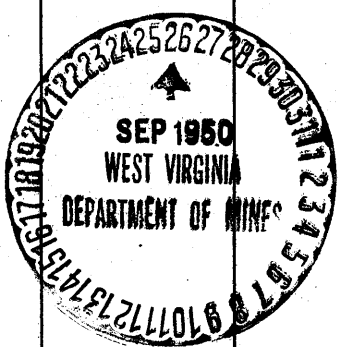

(Over)

FEB 22 1951

Formation	Color	Hard or Soft	Top	Bottom	Oil, Gas or Water	Depth Found	Remarks

Date September 13, 1950

APPROVED THE INTERSTATE PIPE & SUPPLY COMPANY, Owner

By Adolph Beren
(Title)