


AS DRILLED BHL is located on topo map 4,179 feet south of Latitude: 39° 35' 00"  
 AS DRILLED SHL is located on topo map 14,299 feet south of Latitude: 39° 37' 30"

AS DRILLED BHL is located on topo map 10,514 feet west of Longitude: 80° 22' 30"  
 AS DRILLED SHL is located on topo map 2,956 feet west of Longitude: 80° 25' 00"

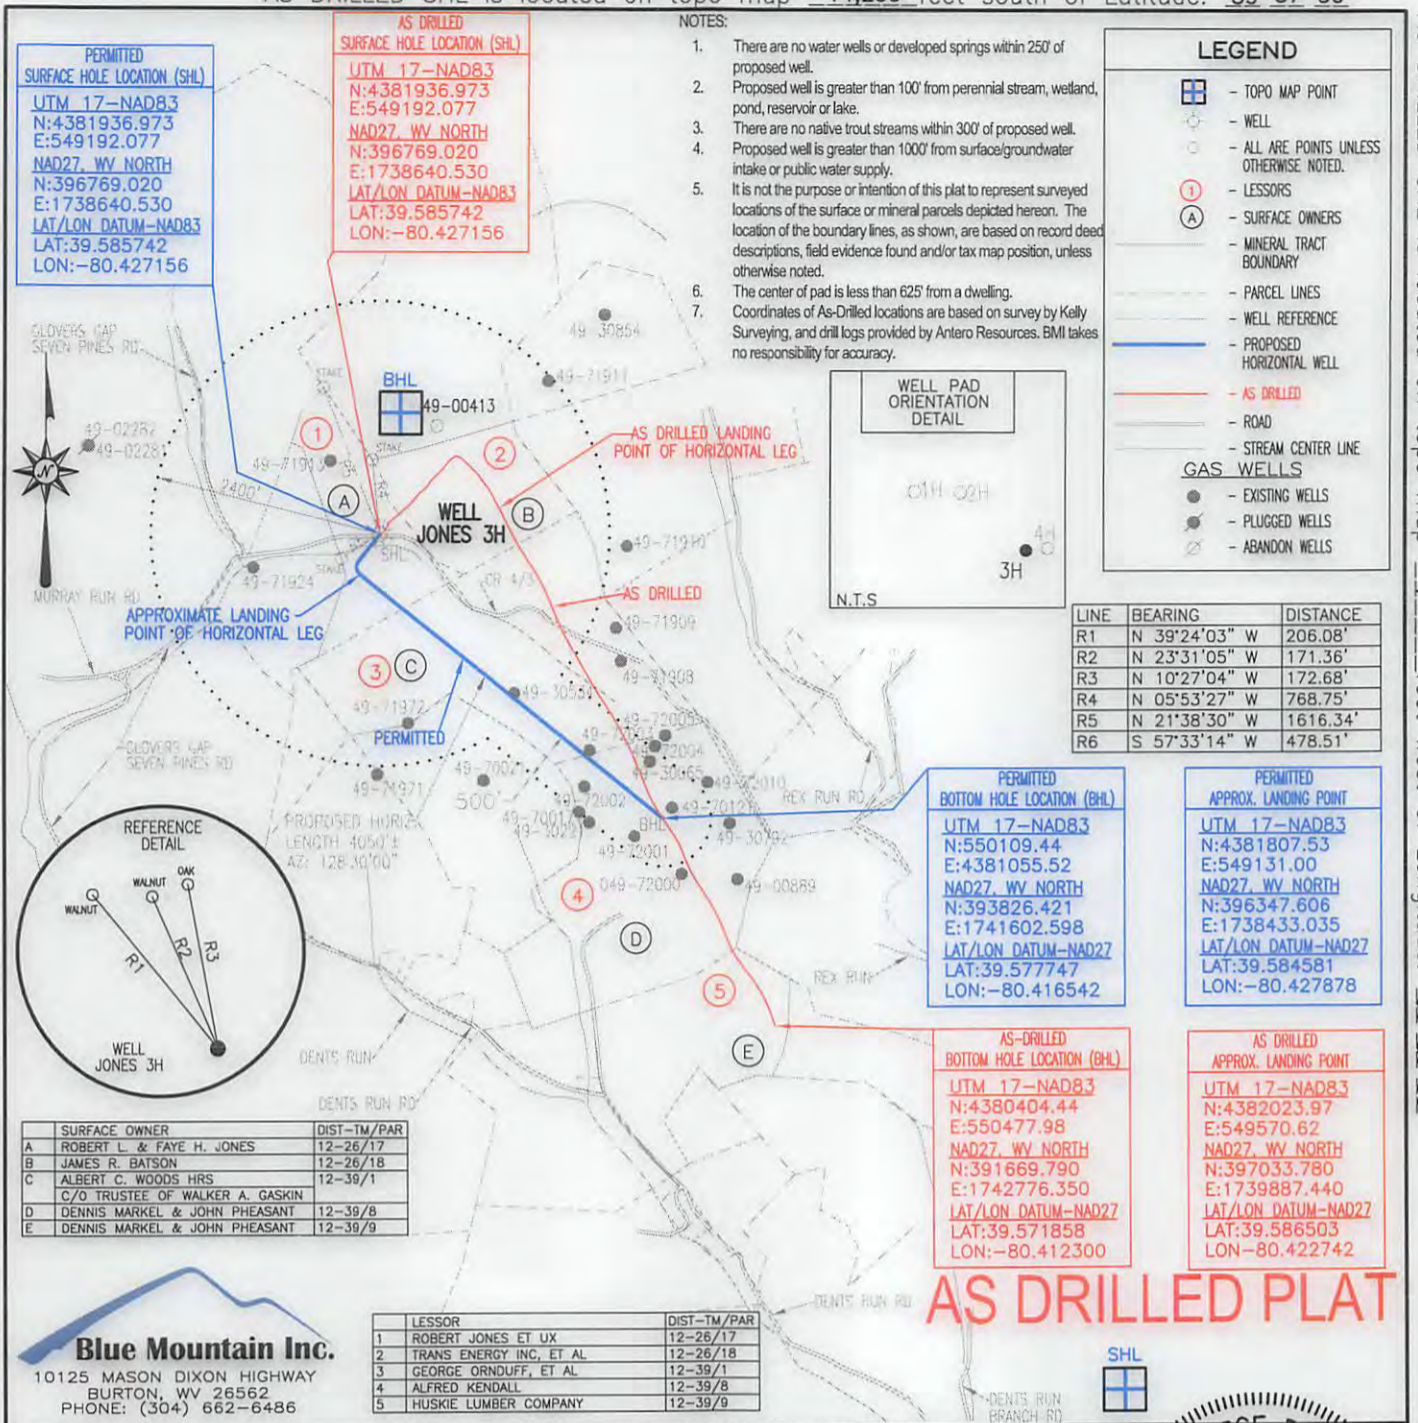


**Blue Mountain Inc.**  
 10125 MASON DIXON HIGHWAY  
 BURTON, WV 26562  
 PHONE: (304) 662-6486

**AS DRILLED PLAT**

FILE #: JONES 3H AS-DRILLED  
 DRAWING #: JONES 3H AS-DRILLED  
 SCALE: 1" = 2000'  
 MINIMUM DEGREE OF ACCURACY: 1/2500  
 PROVEN SOURCE OF ELEVATION: U.S.G.S. MONUMENT THOMAS 1498.81'

I, THE UNDERSIGNED, HEREBY CERTIFY THAT THIS PLAT IS CORRECT TO THE BEST OF MY KNOWLEDGE AND BELIEF AND SHOWS ALL THE INFORMATION REQUIRED BY LAW AND THE REGULATIONS ISSUED AND PRESCRIBED BY THE DEPARTMENT OF ENVIRONMENTAL PROTECTION.

Signed: *George D. Six*  
 R.P.E.: \_\_\_\_\_ L.L.S.: P.S. No. 2000

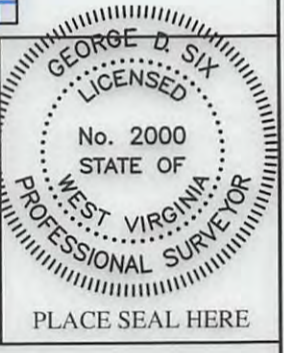

(+) DENOTES LOCATION OF WELL ON UNITED STATES TOPOGRAPHIC MAPS WVDEP

OFFICE OF OIL & GAS  
 601 57TH STREET  
 CHARLESTON, WV 25304

Well Type:  Oil  Waste Disposal  Production  Deep  
 Gas  Liquid Injection  Storage  Shallow

WATERSHED: BUFFALO CREEK ELEVATION: 1042.00'

COUNTY/DISTRICT: MARION/MANNINGTON QUADRANGLE: GLOVER GAP

SURFACE OWNER: ROBERT L. & FAYE H. JONES ACREAGE: 57±

OIL & GAS ROYALTY OWNER: ROBERT JONES ET AL ACREAGE: 394.688±

DRILL  CONVERT  DRILL DEEPER  REDRILL  FRACTURE OR STIMULATE   
 PLUG OFF OLD FORMATION  PERFORATE NEW FORMATION  PLUG & ABANDON   
 CLEAN OUT & REPLUG  OTHER CHANGE  (SPECIFY): AS-DRILLED

TARGET FORMATION: MARCELLUS ESTIMATED DEPTH: TVD: 7,900'± TMD: 11,950'±

WELL OPERATOR EQT PRODUCTION CO. INC. DESIGNATED AGENT JASON RANSON  
 Address 115 PROFESSIONAL PLACE, P.O. BOX 280 Address 115 PROFESSIONAL PLACE - P.O. BOX 280  
 City BRIDGEPORT State WV Zip Code 26330 City BRIDGEPORT State WV Zip Code 26301

08/31/2018