


West Virginia Department of Environmental Protection Office of Oil and Gas WELL LOCATION FORM: GPS

	=		
API: 47-049-02283 WELL NO.: Jo	ones 3H		
FARM NAME: Jones			
RESPONSIBLE PARTY NAME: _ E	QT Production Company		
COUNTY: Marion	DISTRICT: Ma	annington	
QUADRANGLE: Glover Gap 7.5'			
SURFACE OWNER: Jason an	d Michelle Stout		
ROYALTY OWNER: Robert Jones	, et al.		
UTM GPS NORTHING: 4381937			
UTM GPS EASTING: 549192	GPS ELEVATION	: 345 m (1133 ft)	
Mapping Grade GPS: Po	North, Coordinate Units: MSL) – meters. eters ost Processed Differential ost Processed Differential ost Processed Differential	ed API number on the nates that do not mee meters, Altitude:	e et
I the undersigned, hereby certify this data	is correct to the best of	well location.	
belief and shows all the information requi	ired by law and the regula	ny knowledge and	DF0=
prescribed by the Office of Oil and Gas.	red by law and the regula	mons issued and	RECEIVED Office of Oil and Gas
			JUL 28 2022
	5. 2092	2-4-22m	WV Department of vironmental Protection
Signature	Title	Date	Protection

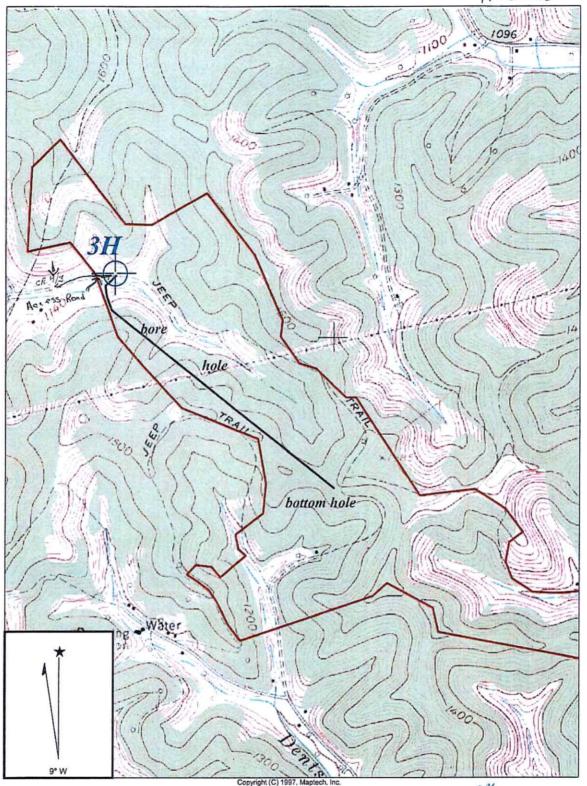

GLOVER GAP QUADRANGLE

SCALE 1" = 1000'

TRANS ENERGY, INC.

WELL: JONES 3H R. JONES, ET AL 411.355 ACRE UNIT RECEIVED Office of Oil and Gas

RECEIVED Office of Oil and Gas

JUL 28 2022

APR 0 3 2014

WV Department of Environmental Protection

WV Department of MARION COUNTY WEST VIRGINIA Protection

MANNINGTON DISTRICT

04/25/201408/19/2022