

4902379P

WW-7
8-30-06



West Virginia Department of Environmental Protection
Office of Oil and Gas
WELL LOCATION FORM: GPS

API: 47-049- WELL NO.: 3361

FARM NAME: M. A. Prichard

RESPONSIBLE PARTY NAME: Consolidation Coal Company

COUNTY: Marion DISTRICT: Mannington 4

QUADRANGLE: Mannington 457

SURFACE OWNER: Mildred H Prichard Heirs (c/o Phil Prichard)

ROYALTY OWNER: _____

UTM GPS NORTHING: 4,377,014 m

UTM GPS EASTING: 556,074 m GPS ELEVATION: 296 m (969.75' FT)

The Responsible Party named above has chosen to submit GPS coordinates in lieu of preparing a new well location plat for a plugging permit or assigned API number on the above well. The Office of Oil and Gas will not accept GPS coordinates that do not meet the following requirements:

- Datum: NAD 1983, Zone: 17 North, Coordinate Units: meters, Altitude: height above mean sea level (MSL) – meters.
- Accuracy to Datum – 3.05 meters
- Data Collection Method:

Survey grade GPS _____: Post Processed Differential _____
Real-Time Differential _____

Mapping Grade GPS X: Post Processed Differential X
Real-Time Differential _____

- Letter size copy of the topography map showing the well location.

I the undersigned, hereby certify this data is correct to the best of my knowledge and belief and shows all the information required by law and the regulations issued and prescribed by the Office of Oil and Gas.

Signature

February 9, 2015

Date

Professional Surveyor


Title

RECEIVED
Office of Oil and Gas

FEB 17 2015

WV Department of
Environmental Protection

4902379P

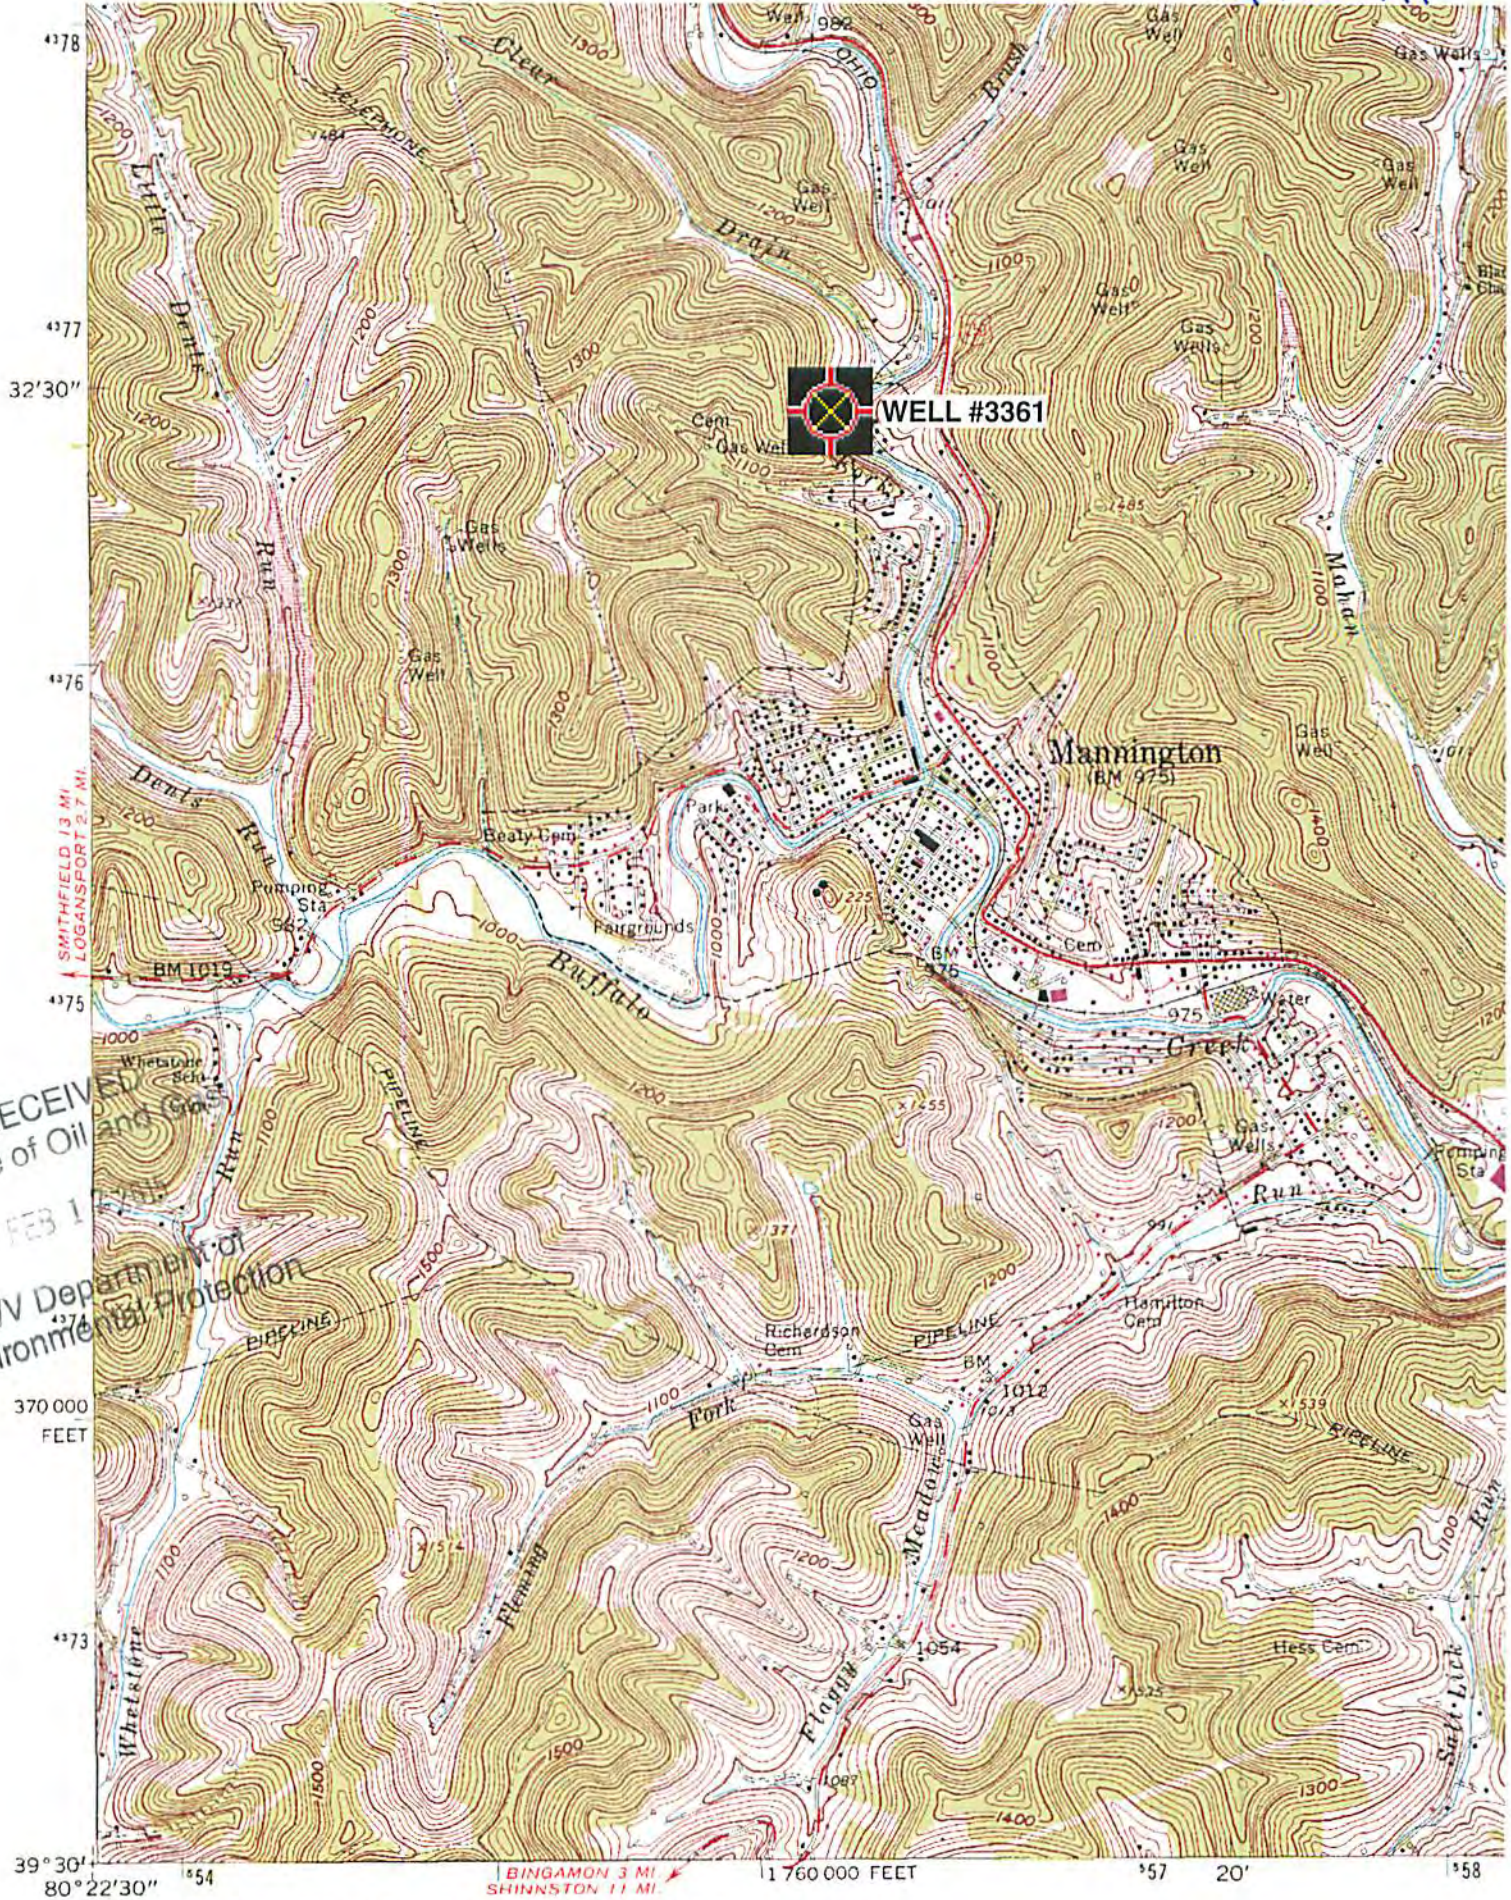

WELL #3361

Mannington
(BM 975)

4378
4377
32'30"
4376
4375
370 000
FEET
4373
39° 30'
80° 22'30"

SMITHFIELD 13 MI
LOGANSPORT 2.7 MI

RECEIVED
Office of Oil and Gas
FEB 1
WV Department of
Environmental Protection

BINGAMON 3 MI
SHINNSTON 11 MI

1 760 000 FEET

Mapped, edited, and published by the Geological Survey
Control by USGS and USC&GS

Topography by photogrammetric methods from aerial
photographs taken 1957. Field checked 1960

'Mannington; WV' Scale: 1" = 0.379Mi 610M 2,000Ft, 1 Mi = 2.640", 1 cm = 240Mt

(WALLACE)
4902379 NW

