



WELL NAME: GREEN LAKES 7H
GRANT TOWN

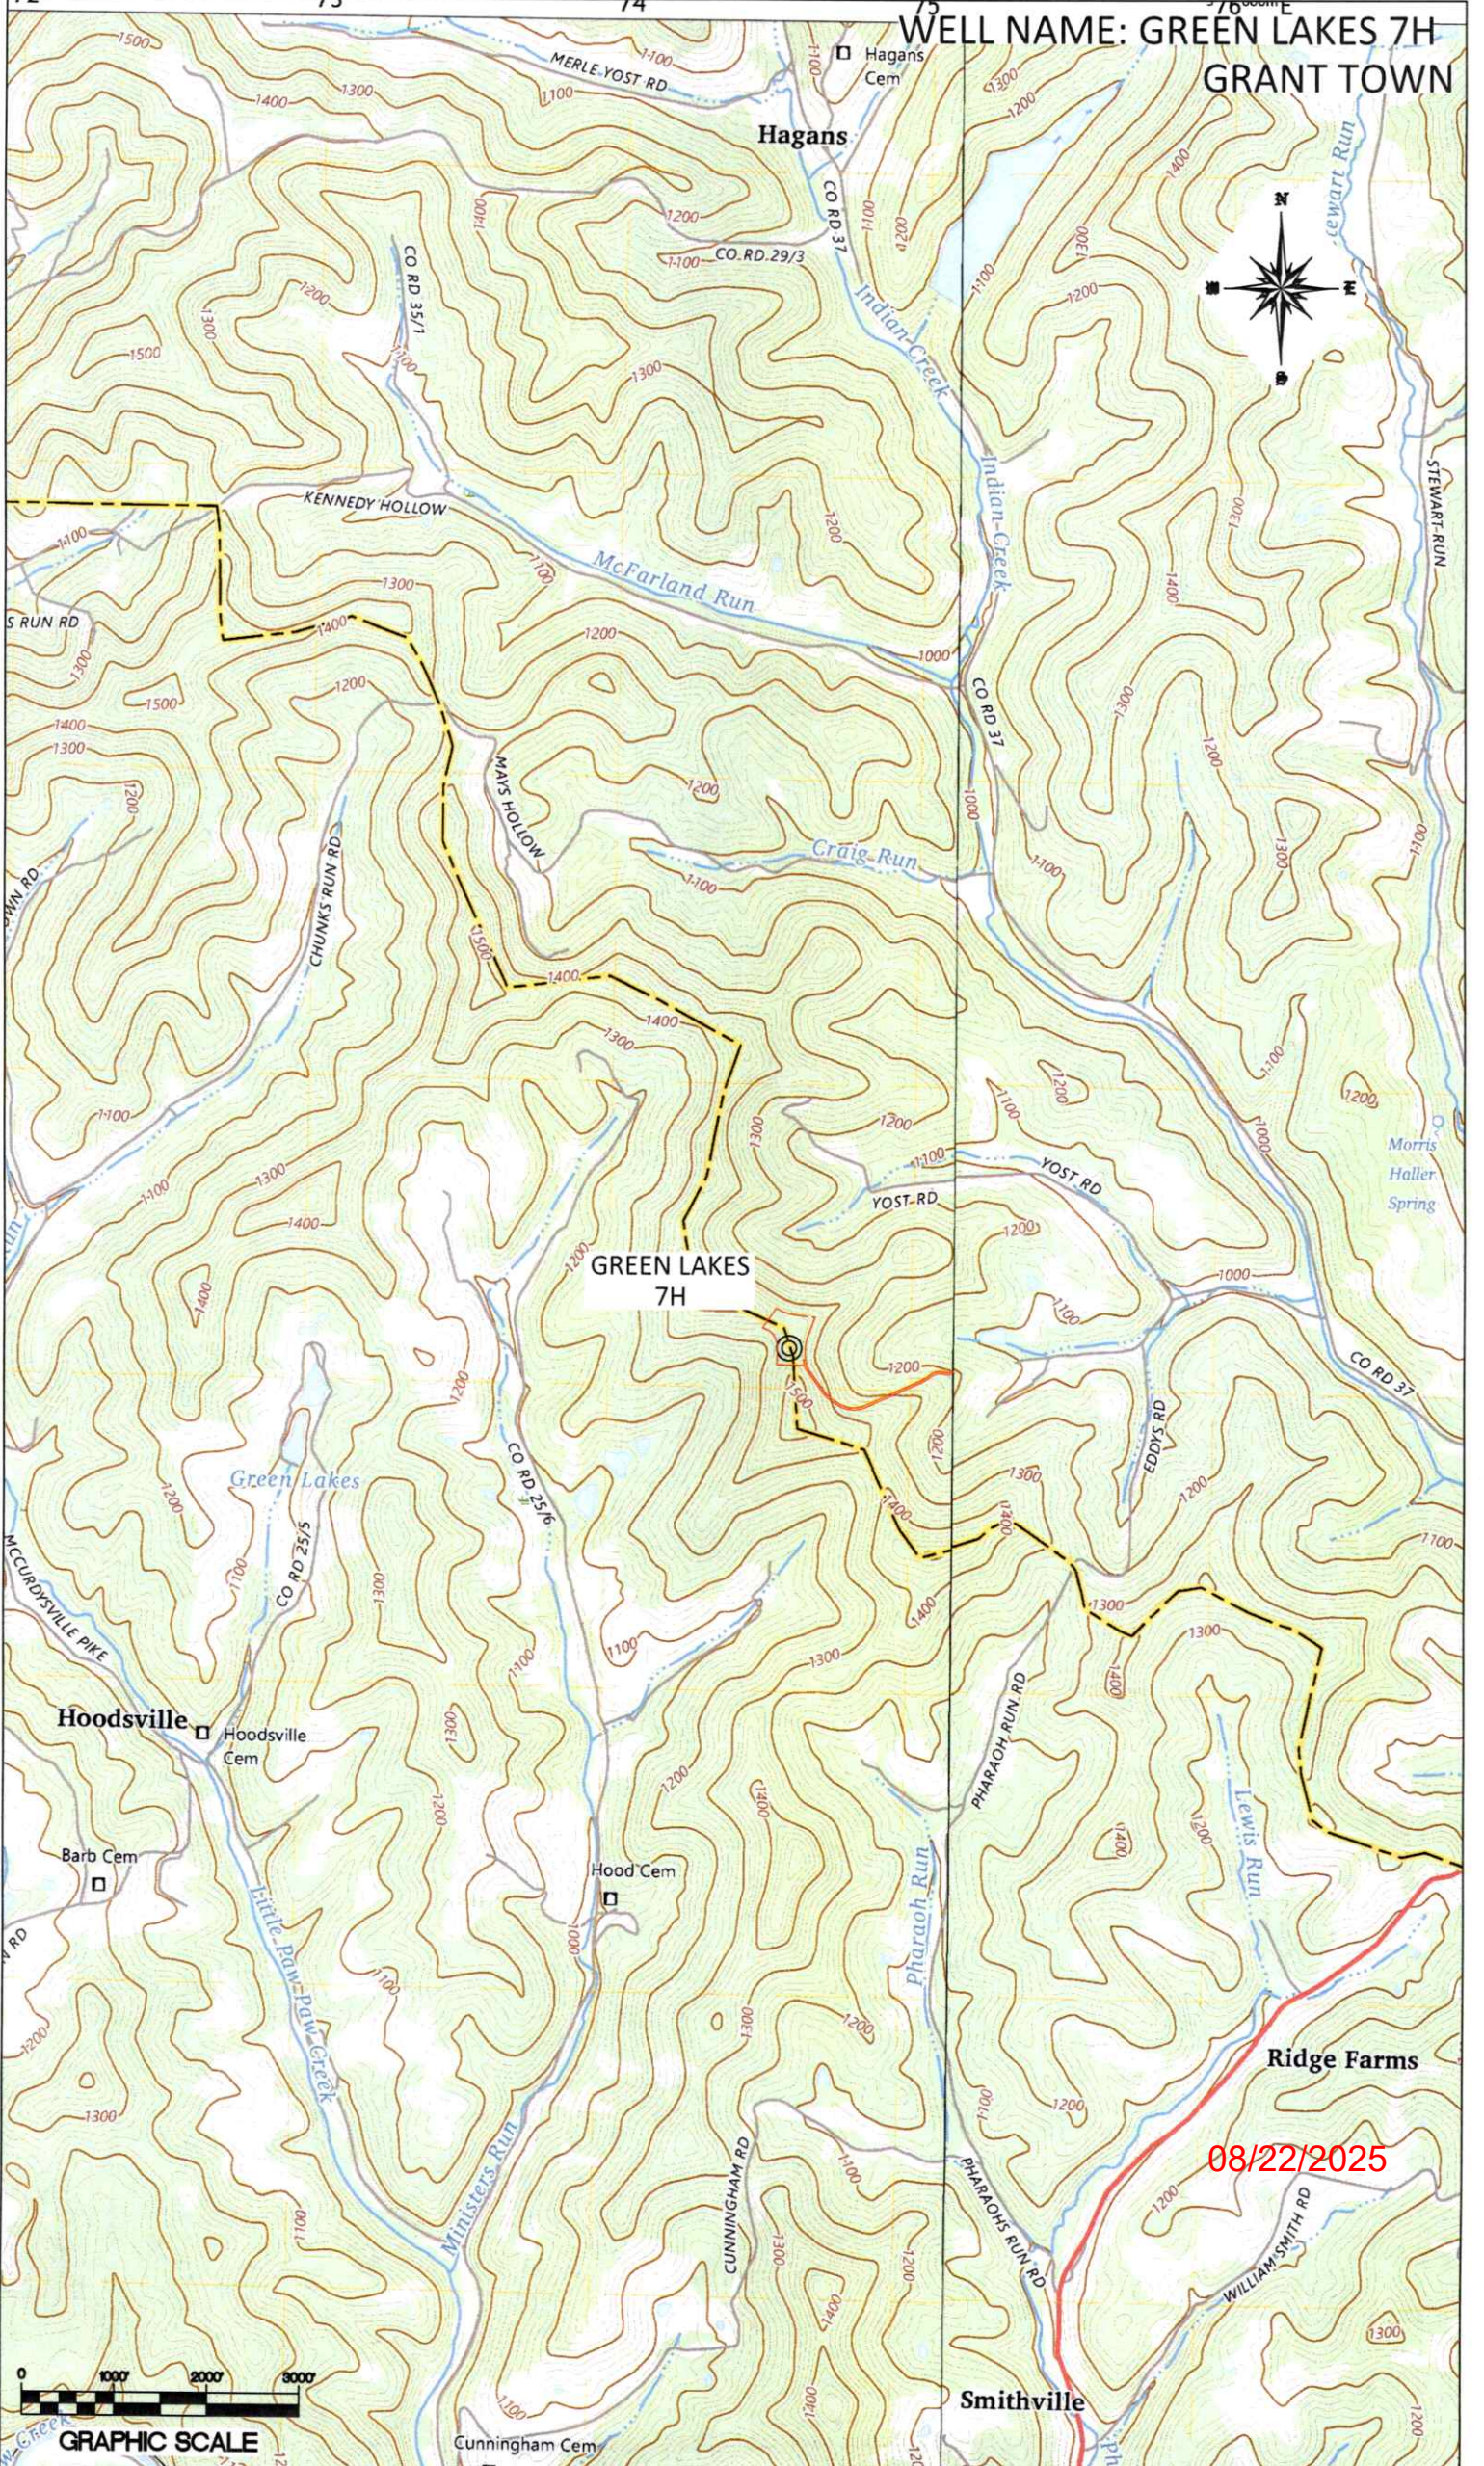

08/22/2025

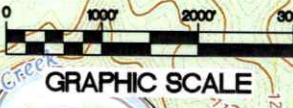

WW-7
8-30-06



West Virginia Department of Environmental Protection
Office of Oil and Gas
WELL LOCATION FORM: GPS

API: 47-049-02561 WELL NO.: 7H
FARM NAME: Green Lakes
RESPONSIBLE PARTY NAME: Hollie Medley
COUNTY: Monongalia/Marion DISTRICT: Grant/Paw Paw
QUADRANGLE: Grant Town
SURFACE OWNER: Parker A & Alice J Bell
ROYALTY OWNER: Luther E Howell and Nettie E Howell
UTM GPS NORTHING: 4382128.6
UTM GPS EASTING: 574601.7 GPS ELEVATION: 1447'

The Responsible Party named above has chosen to submit GPS coordinates in lieu of preparing a new well location plat for a plugging permit or assigned API number on the above well. The Office of Oil and Gas will not accept GPS coordinates that do not meet the following requirements:

1. Datum: NAD 1983, Zone: 17 North, Coordinate Units: meters, Altitude: height above mean sea level (MSL) – meters.
2. Accuracy to Datum – 3.05 meters
3. Data Collection Method:

Survey grade GPS ☐ : Post Processed Differential ☐

Real-Time Differential ☒

Mapping Grade GPS ☐ : Post Processed Differential ☐

Real-Time Differential ☐

4. Letter size copy of the topography map showing the well location.

I the undersigned, hereby certify this data is correct to the best of my knowledge and belief and shows all the information required by law and the regulations issued and prescribed by the Office of Oil and Gas.

Hollie Medley
Signature

Regulatory Manager
Title


8-6-25
Date

RECEIVED
Office of Oil and Gas

AUG 08 2025

For Signature
Environmental Protection


08/22/2025

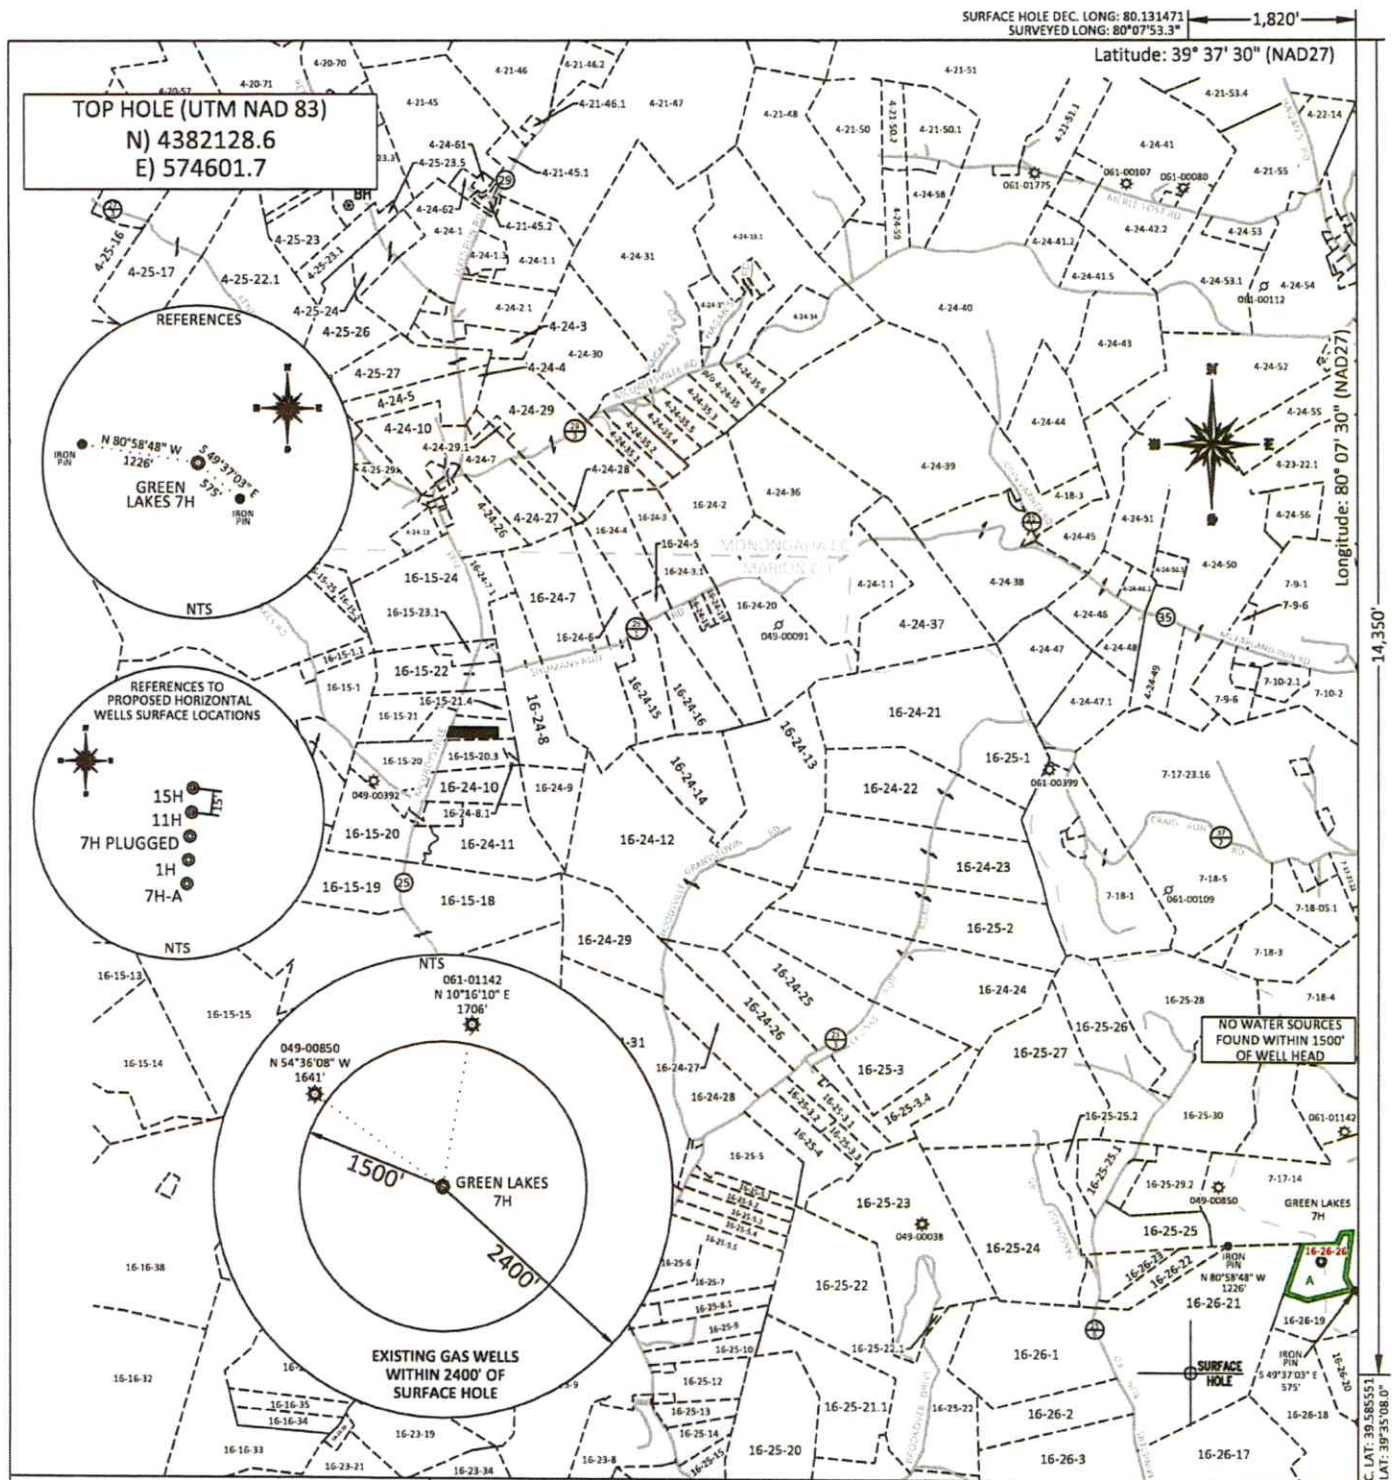

FILE #: NNE20
DRAWING #: 4136
SCALE: PLAT: 1" = 2400'
TICK: 1" = 2000'
MINIMUM DEGREE OF ACCURACY: 1/200
PROVEN SOURCE OF ELEVATION: SUBMETER MAPPING GRADE GPS

I, THE UNDERSIGNED, HEREBY CERTIFY THAT THIS PLAT IS CORRECT TO THE BEST OF MY KNOWLEDGE AND BELIEF AND SHOWS ALL THE INFORMATION REQUIRED BY LAW AND THE REGULATIONS ISSUED AND PRESCRIBED BY THE DEPARTMENT OF ENVIRONMENTAL PROTECTION.

Signed: *[Signature]*
L.L.S. #2124 : Ernest J. Benchek III

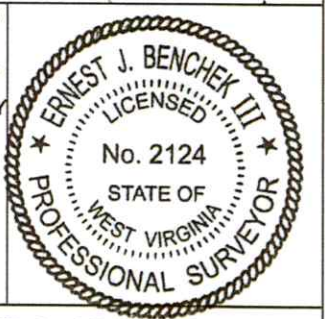

(+) DENOTES LOCATION OF WELL ON UNITED STATES TOPOGRAPHIC MAPS
WVDEP
OFFICE OF OIL & GAS
601 57TH STREET
CHARLESTON, WV 25304
Well Type: ☐ Oil ☐ Waste Disposal ☐ Production ☐ Deep
☒ Gas ☐ Liquid Injection ☐ Storage ☒ Shallow
WATERSHED: Upper Monongahela River
COUNTY/DISTRICT: MONONGALIA CO., GRANT DISTRICT / MARION CO., PAW PAW DISTRICT
SURFACE OWNER: PARKER A & ALICE J BELL
OIL & GAS ROYALTY OWNER: Luther E. Howell and Nettie E. Howell
LEASE NUMBERS:

DATE: AUGUST 6, 2025
OPERATOR'S WELL #: GREEN LAKES 7H
API WELL #: 47 49 02561
STATE COUNTY PERMIT
CURRENT ELEVATION: 1,472.0'
PROPOSED ELEVATION: 1,447.60'
QUADRANGLE: GRANT TOWN
ACREAGE: 12.97 +/-
ACREAGE: 12.97 +/-

DRILL ☐ CONVERT ☐ DRILL DEEPER ☐ REDRILL ☐ FRACTURE OR STIMULATE ☐
PLUG OFF FORMATION ☐ PERFORATE NEW FORMATION ☐ PLUG & ABANDON ☒
CLEAN OUT & REPLUG ☐ OTHER CHANGE ☐ (SPECIFY):
TARGET FORMATION: MARCELLUS
WELL OPERATOR: MARION NATURAL ENERGY LLC
ADDRESS: 707 VIRGINIA STREET EAST, SUITE 1200
CITY: CHARLESTON STATE: WV ZIP CODE: 25301
ESTIMATED DEPTH: TVD: 997'
DESIGNATED AGENT: L. Brett Loflin
ADDRESS: 707 VIRGINIA STREET EAST, SUITE 1200
CITY: CHARLESTON STATE: WV ZIP CODE: 25301

08/22/2025