



4704902597

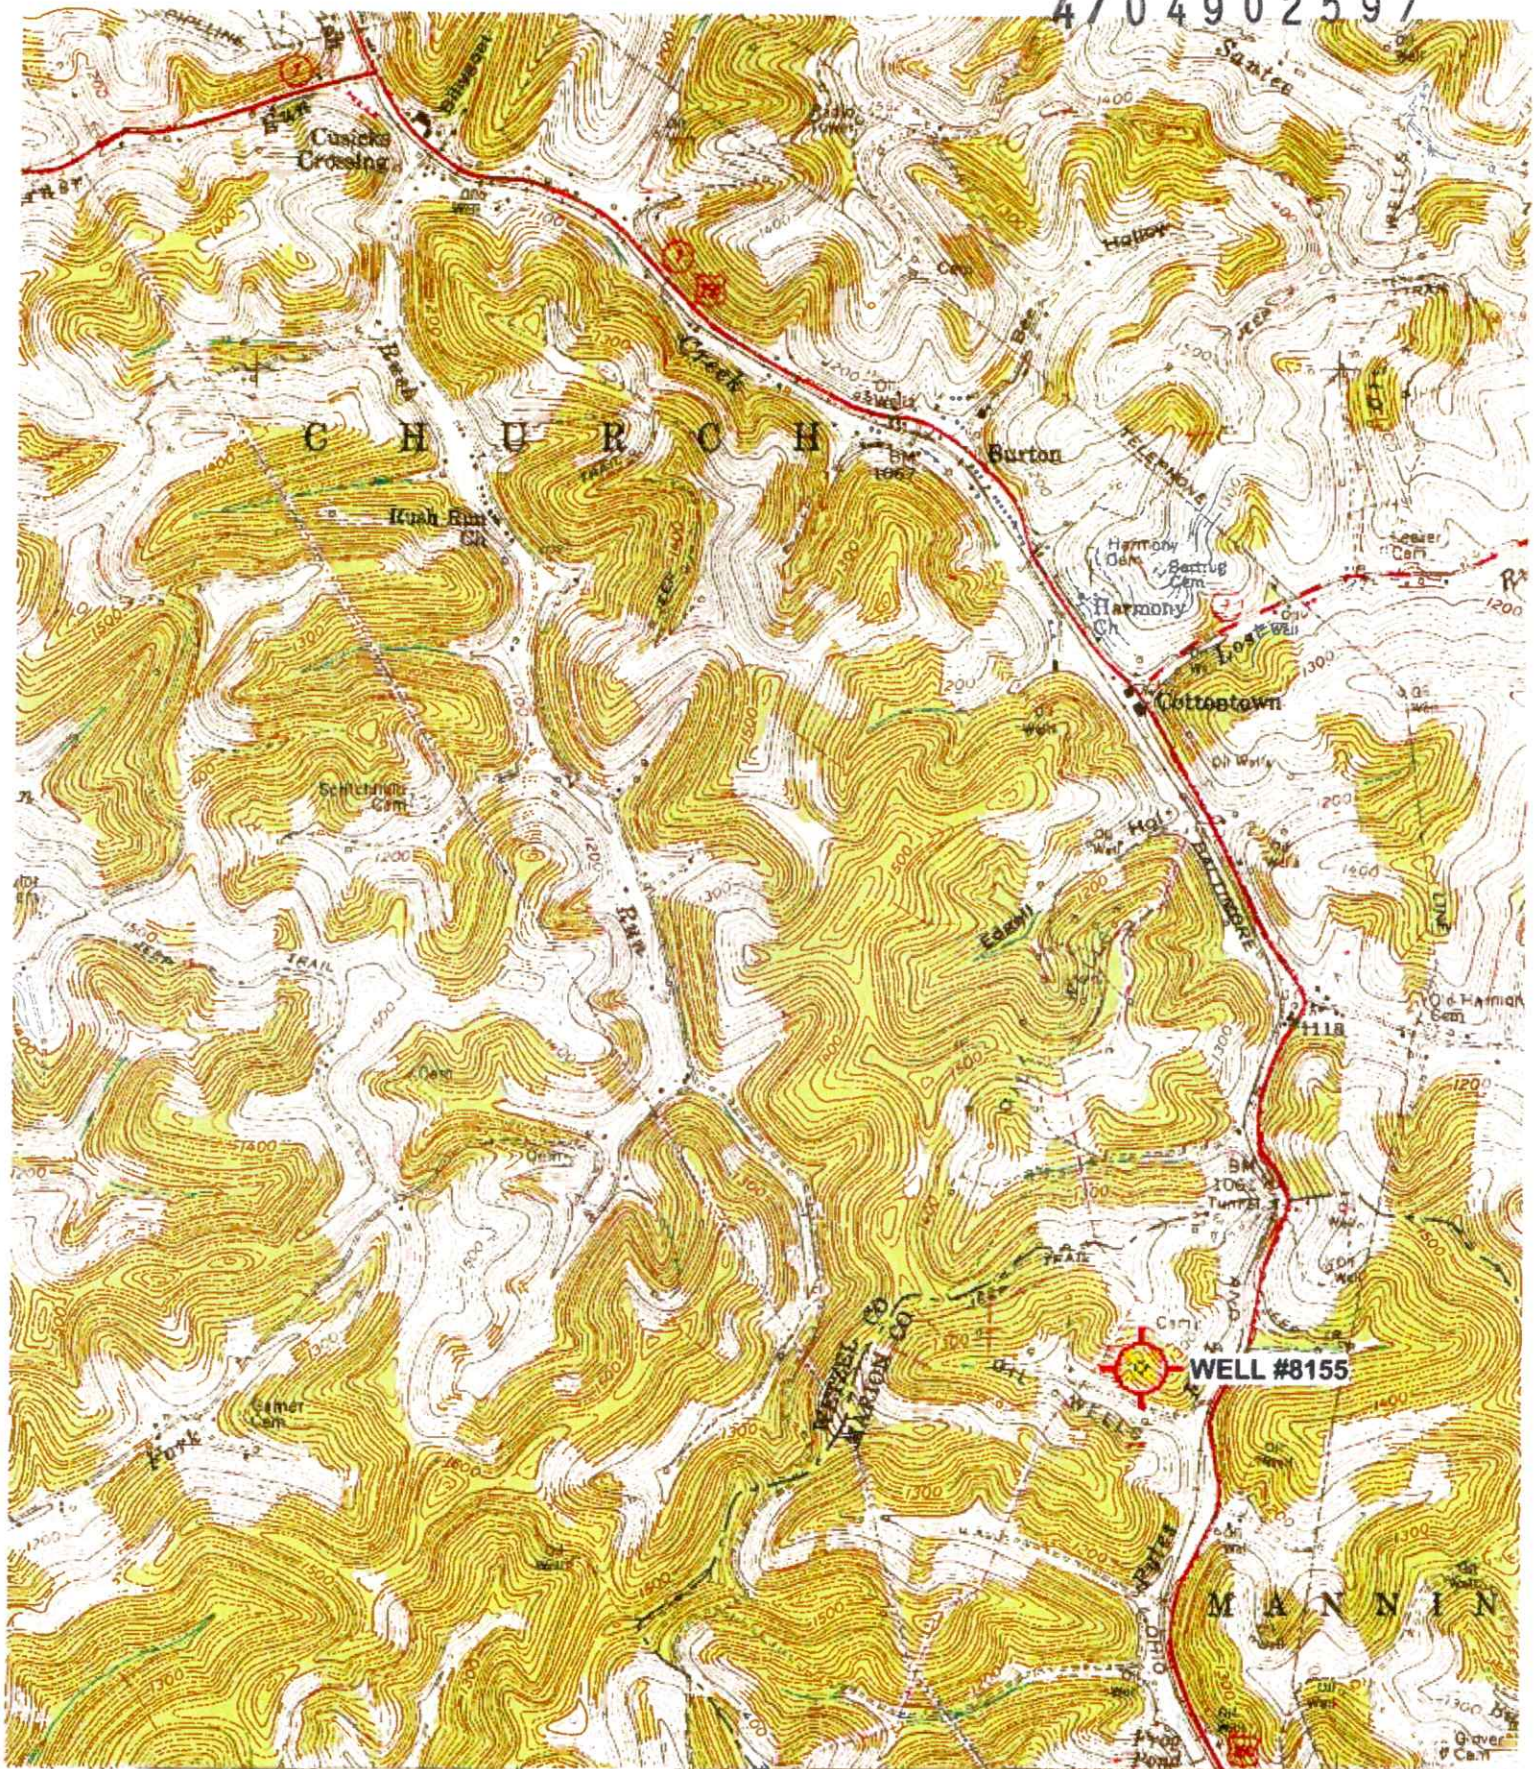

46 27'30" 47 48 (GLOVER GAP) 49 25' 1250 00

SCALE 1:24 000

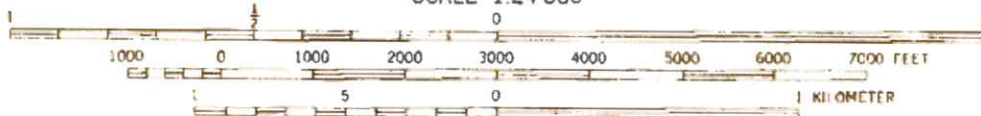


"Hundred: W/P/PA" Scale: 1" = 0.370Mi 610M: 2.00E: 1 Mi = 2.640" 1 cm = 240M: 1/2" = 20 FEET

RECEIVED
Office of Oil and Gas

AUG 25 2025

08/29/2025
Department of
Environmental Protection

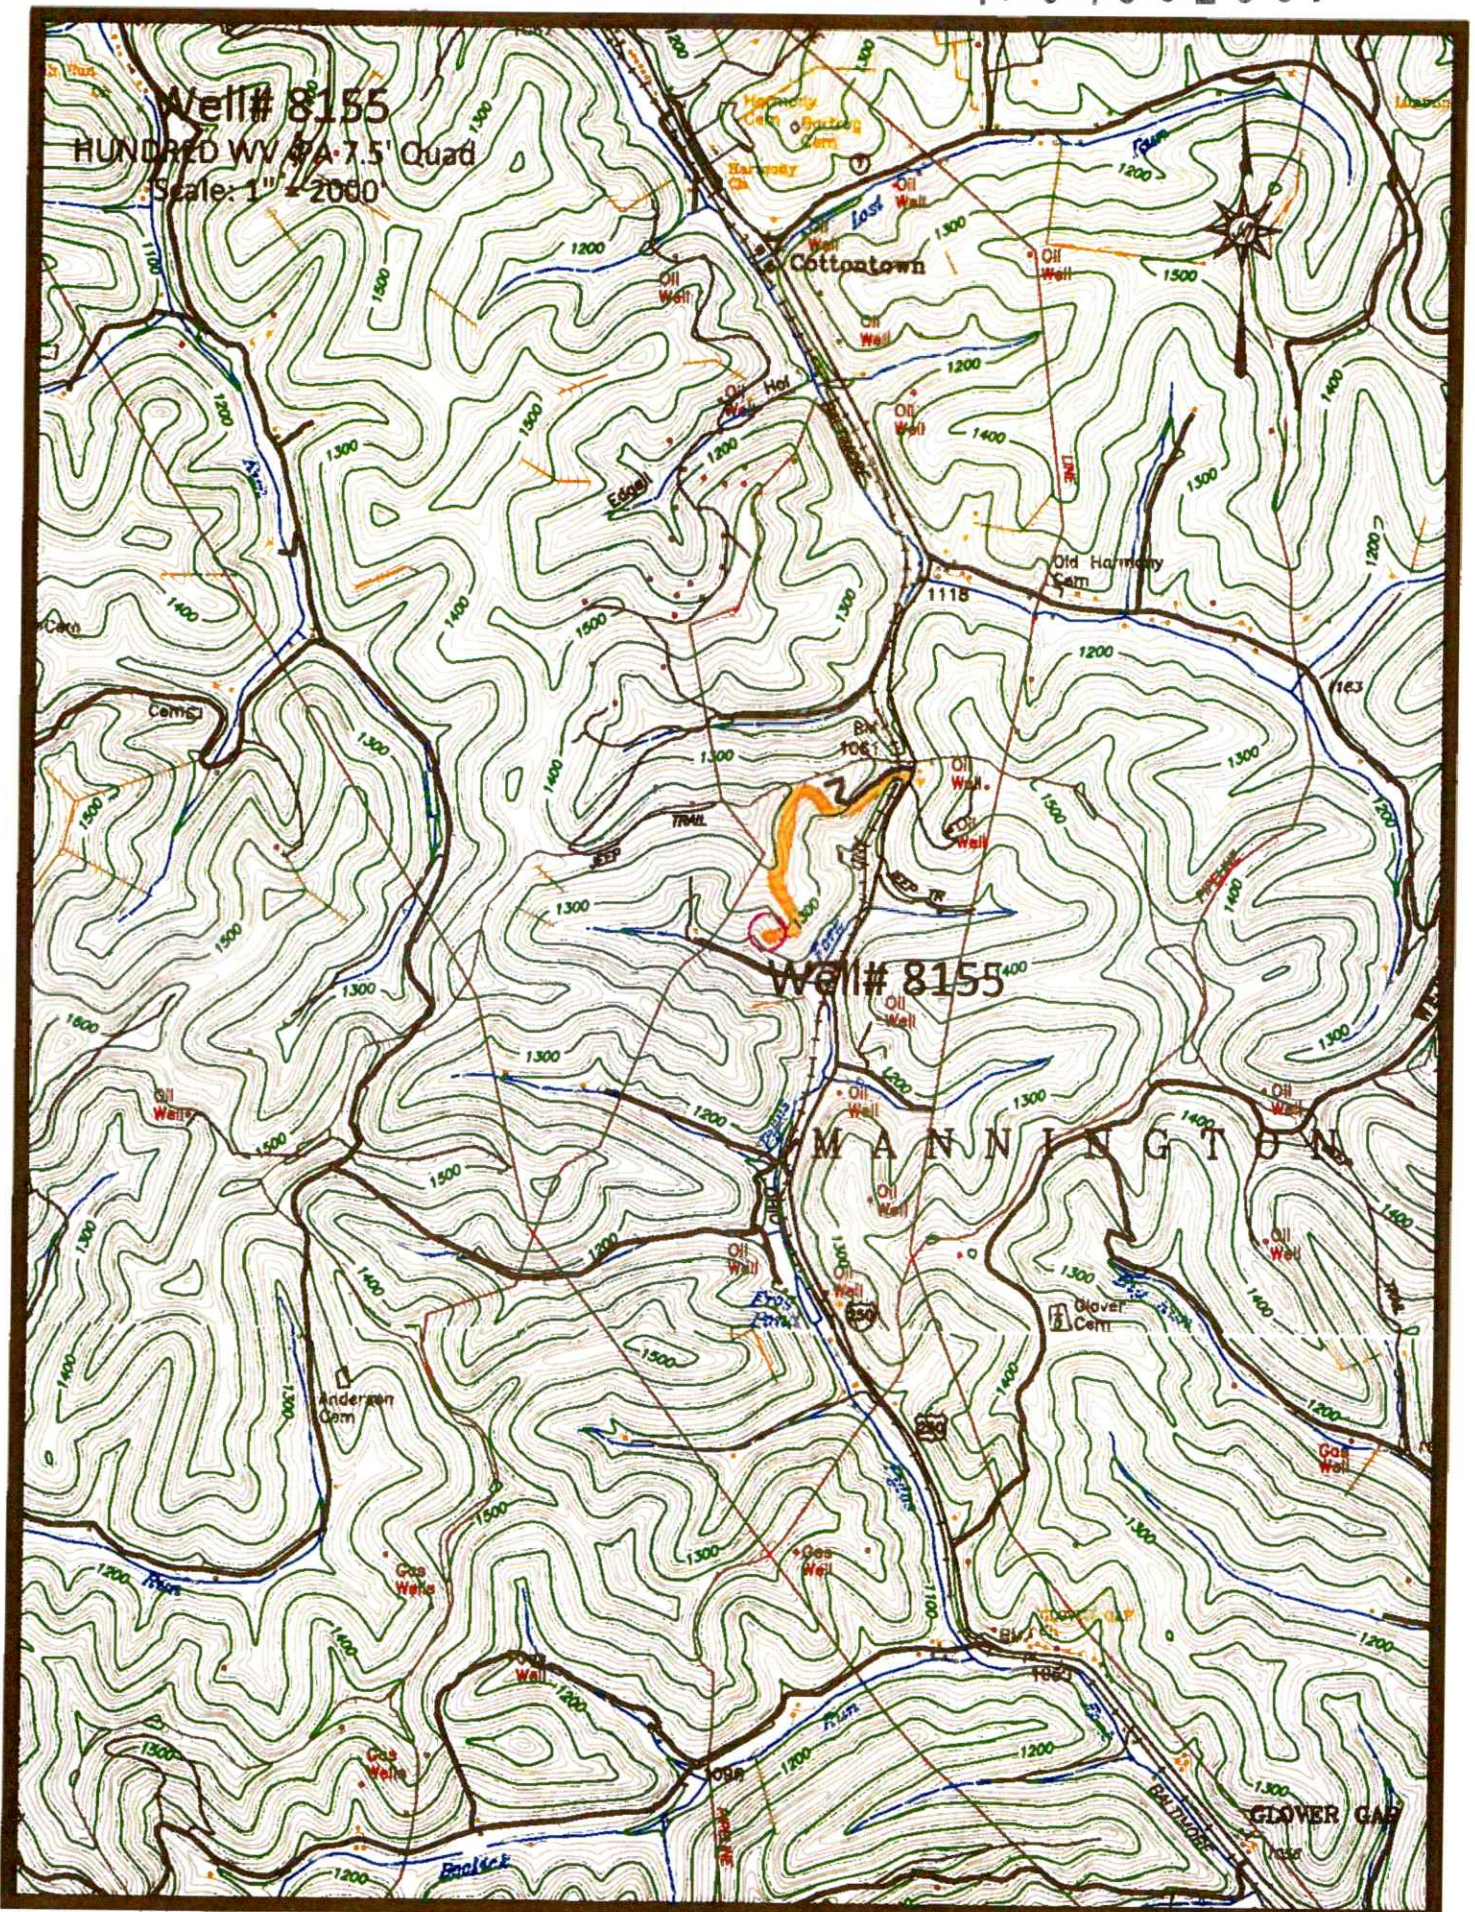

Well# 8155
HUNDRED WY 7.5' Quad
Scale: 1" = 2000'

Well# 8155

MANNING

GLOVER GAS

Access Road

08/29/2025

4704902597

Well# 8155

HUNDRED WV, PA 7.5' Quad

Scale: 1" = 500'

BM

1061

1300

TRAIL

JEEP

AND

JEEP

Well# 8155

Oil Well

RECEIVED
Office of Oil and Gas

AUG 25 202

WV Department of
Environmental Protection

Oil Well

1200

Pyles

MA

Arroga Road

08/29/2025



08/29/2025

This aerial map displays a collection of land parcels, each identified by a unique alphanumeric label. The parcels are outlined with dashed white lines. The labels include:

- 103-31051, 103-71361, 103-71360, 103-31006, 103-31003, 103-01622
- 103-70335, 103-01503, 103-01733, 103-30536
- 049-70197, 049-00004, 049-00004
- 049-70106, 049-00587, 049-00679
- 049-70493, 049-70494, 049-70495, 049-70496, 049-70490, 049-70491, 049-70492
- 049-00572, 049-00724, 049-00725, 049-00813, 049-00573
- 049-00323, 049-00640, 049-30472, 049-30463

Several symbols are placed on the map, including red star-like markers, a green star-like marker, and a yellow star-like marker. The word "Mannington" is written in a stylized font across the center of the map. The background is an aerial photograph showing the terrain and vegetation.

4704902597

WW-7
8-30-06

West Virginia Department of Environmental Protection
Office of Oil and Gas

WELL LOCATION FORM: GPS

API: 47-049-70493 WELL NO.: 8155
 FARM NAME: WM. TROY
 RESPONSIBLE PARTY NAME: WEST VIRGINIA LAND RESOURCES INC.
 COUNTY: MARION DISTRICT: MANNINGTON
 QUADRANGLE: HUNDRED WV, PA
 SURFACE OWNER: MARION COUNTY COAL RESOURCES INC.
 ROYALTY OWNER: _____
 UTM GPS NORTHING: 4,387,630 m
 UTM GPS EASTING: 549,436 m GPS ELEVATION: 383 m

The Responsible Party named above has chosen to submit GPS coordinates in lieu of preparing a new well location plat for a plugging permit or assigned API number on the above well. The Office of Oil and Gas will not accept GPS coordinates that do not meet the following requirements:


1. Datum: NAD 1983, Zone: 17 North, Coordinate Units: meters, Altitude: height above mean sea level (MSL) - meters.
2. Accuracy to Datum - 3.05 meters
3. Data Collection Method:

Survey grade GPS ☒ : Post Processed Differential _____
 Real-Time Differential ☒

Mapping Grade GPS _____ : Post Processed Differential _____
 Real-Time Differential _____

4. **Letter size copy of the topography map showing the well location.**

I the undersigned, hereby certify this data is correct to the best of my knowledge and belief and shows all the information required by law and the regulations issued and prescribed by the Office of Oil and Gas.

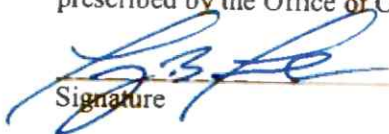
Signature

PS 2002

Title

MAY 28, 2025

Date

RECEIVED
Office of Oil and Gas

AUG 25 2025

WV Department of
Environmental Protection

08/29/2025