

LATITUDE 39 35

LONGITUDE 80 15

2.34 S
0.83 W

7'5 OGIS topo location

7.5' loc _____ 15' loc _____
(calc.) _____

Company _____

Farm JOHN BLACKSHERE 2

Quad MANNINGTON


County MARION

District LINCOLN

WELL LOCATION MAP

File No. 30009

THE LOCATION OF WELL NO. 20 (TO BE ABANDONED) OF THE
M.W.P.S. CO., OF FAIRMONT W.VA ON THE
JOHN BLACKSHEE HRS. TRACT, CONSISTING OF 253.4 ACRES
LOCATED IN LINCOLN DISTRICT MARION COUNTY

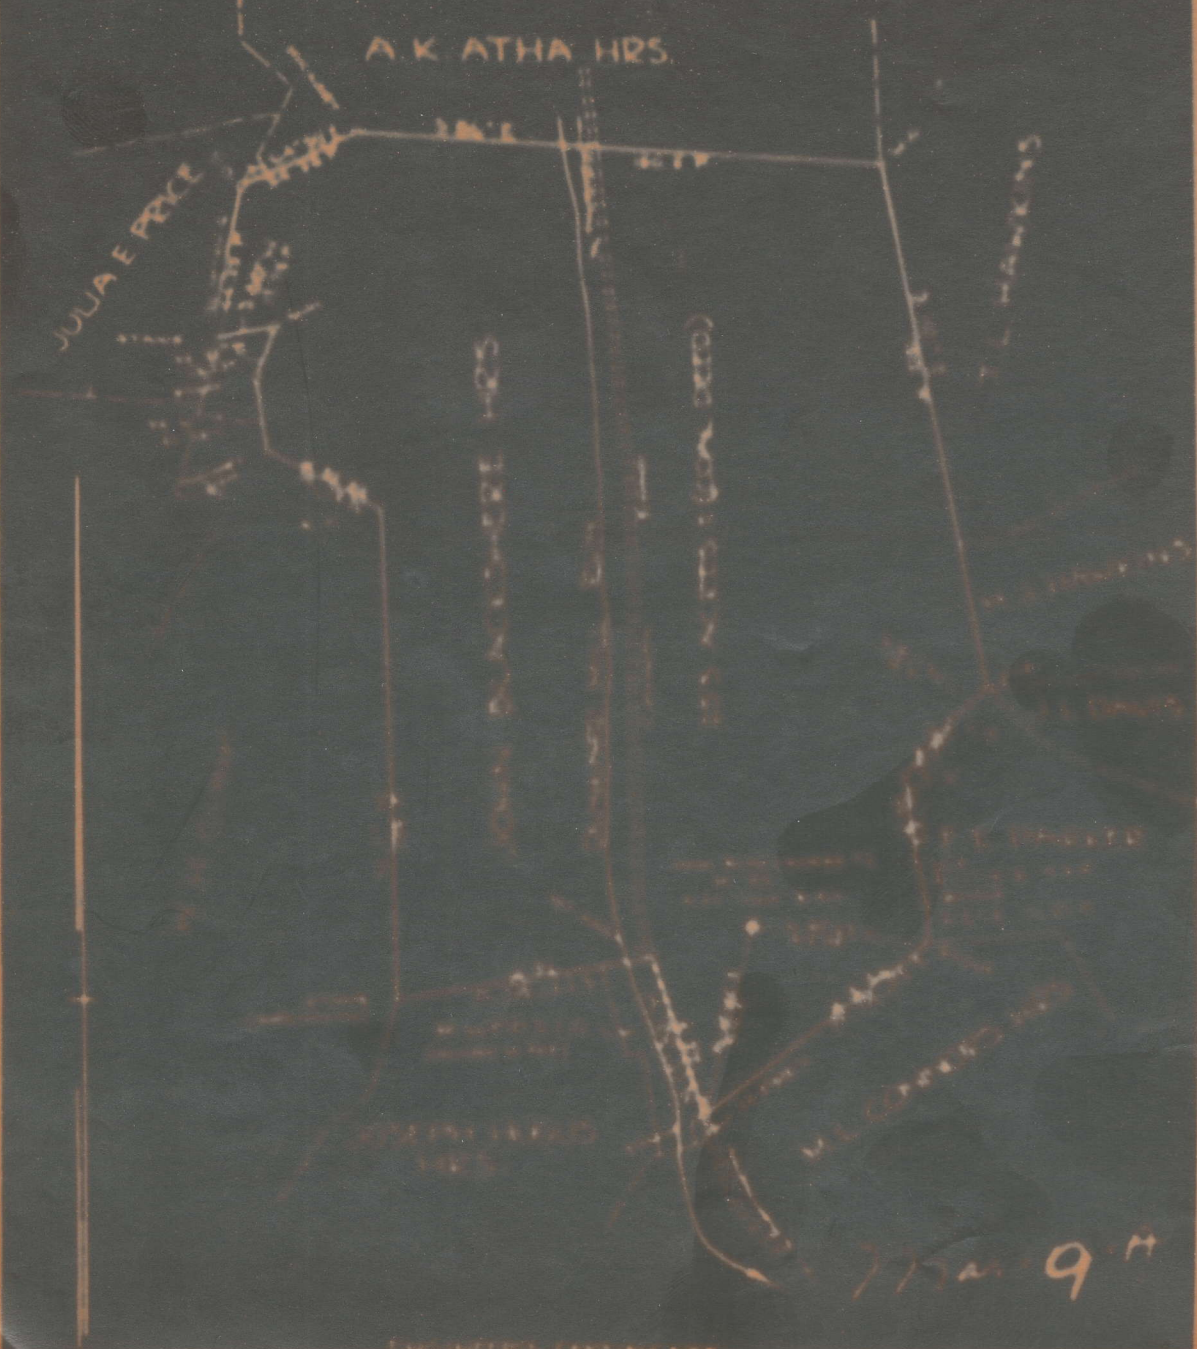

RICHARD MILL RUN

7/24/94

77 ac - 9-A see
Back

MONONGAHELA WEST PENN PUBLIC SERVICE CO.

GAS DEPT

WELL RECORD

Map No. _____

Well No. 20

Well #2 Drilled on John Blackshere Farm of 253 Acres situate in
Lincoln Dist. ~~of~~ Marion County—State W. Va. Lease No. 191
RIG **WELL**

Commented _____ Completed _____ Contractor _____ Work Order No. _____	Location Made _____ Commenced Drilling _____ Completed " <u>December 26, 1907</u> Contractor _____ Drillers _____
--	---

ROCK FORMATION	TOP	BOTTOM	REMARKS	PRESSURE AND VOLUME
Conductor				1 Minute Lbs.
Mapletown Coal	380			2 " "
Pittsburgh Coal	495			3 " "
Little Dunkard				4 " "
Gas Sand				5 " "
1st Salt Sand)	1806	1455	Water-1430'	10 " "
2nd Salt Sand)				15 " "
Marion Sand				30 " "
Little Lime				1 Hour "
Pencil Cave				24 " <u>700# (Est.)</u> "
Big Lime	1755	1824	(1925') Rock	" "
Big Injun	1824	1984	Gas show	Size of Tubing Inch
Berea				Size of Casing "
Gants Sand				Vol. by Water
20 ft. Sand	2408	2458		" " Mercury
20 Ft. Sand				" " Pressure
Gordon Stray				Open Flow <u>1,222,000</u> 2222
Gordon Sand	2713	2768		CONNECTED TO MAIN LINE
4th Sand	No 4th sand		Gas 2857'	
5th Sand	2866	2885	2867-2875	Length of Line Feet
Bayard Sand				Size of Line Inch
Elizabeth				DISCONNECTED FROM LINE
Speechley				
Bradford				Notified Lessor
				Abandoned
* Producing Sand				Repacked
				With Feet Tubing


Total Depth 2904 Feet at \$ _____ per Foot \$ _____

CASING RECORD

	SIZE	CHARGED		PUT IN WELL		PULLED		LEFT IN WELL		TRANSFERRED		LEFT AT WELL	
		Feet	Inches	Feet	Inches	Feet	Inches	Feet	Inches	Feet	Inches	Feet	Inches
Casing	10"			510		510							
"	8 1/2"			1414		1294			120- (6 joints and left-hand nipple left in)				
"	6-5/8"			1755				1755					
"	5-3/16"			2713				2713	(Rubber packer on bottom)				

Latitude 39° 35'

Longitude 80° 15'

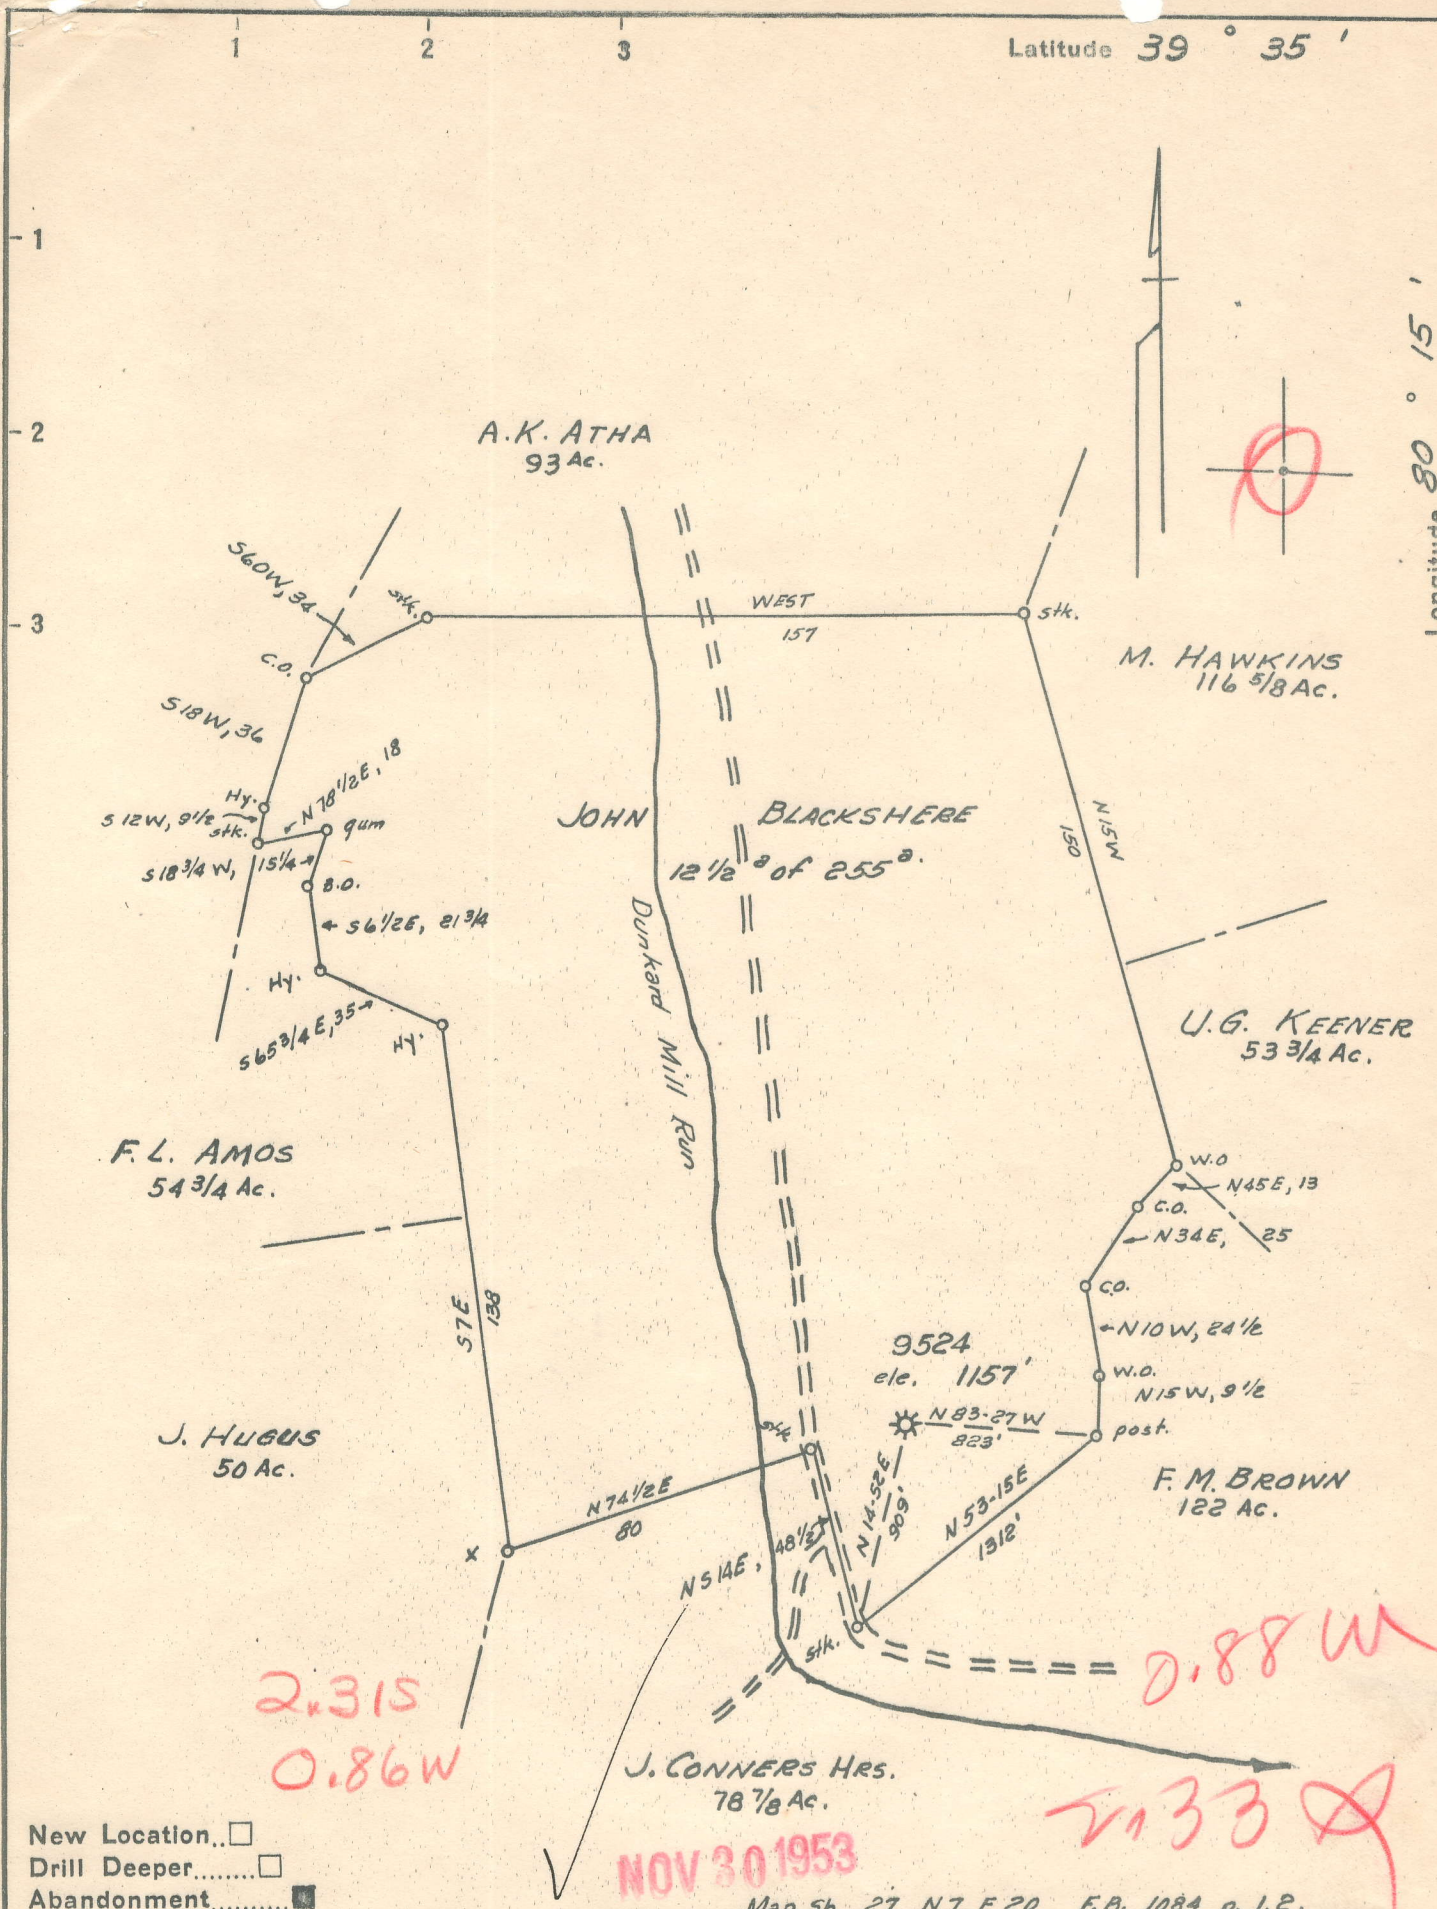

New Location...
 Drill Deeper.....
 Abandonment.....

NOV 30 1953

Map Sh. 27 N7, E20 F.B. 1084 p. 1, 2.

Company HOPE NATURAL GAS CO.
 Address CLARKSBURG, W.VA.
 Farm JOHN BLACKSHERE
 Tract 12 1/2 Acres 255° Lease No. 61827
 Well (Farm) No. _____ Serial No. 9524
 Elevation (Spirit Level) 1157'
 Quadrangle MANNINGTON
 County MARION District LINCOLN
 Engineer Guy H Bradley
 Engineer's Registration No. 2425
 File No. _____ Drawing No. _____
 Date Nov 5, 1953 Scale 1"=50p.

STATE OF WEST VIRGINIA
 DEPARTMENT OF MINES
 OIL AND GAS DIVISION
 CHARLESTON

WELL LOCATION MAP
 FILE NO. MAR-796-A

+ Denotes location of well on United States Topographic Maps, scale 1 to 62,500, latitude and longitude lines being represented by border lines as shown.

- Denotes one inch spaces on border line of original tracing.

JOHN BLACKSHERE 9524 Map of ... MAR 796 A



STATE OF WEST VIRGINIA
DEPARTMENT OF MINES
OIL AND GAS DIVISION

WELL RECORD

Permit No. 796-A Oil or Gas Well Gas (KIND)

Company Hope Natural Gas Company
Address 445 West Main St. Clarksburg, W. Va.
Farm Zans V. Blackshere Acres 253
Location (waters) _____
Well No. 9524 Elev. 1157'
District Lincoln County Marion
The surface of tract is owned in fee by _____
Address _____
Mineral rights are owned by _____
Address _____
Drilling commenced _____
Drilling completed Dec. 26, 1907
Date Shot _____ From _____ To _____
With _____
Open Flow /10ths Water in _____ Inch
/10ths Merc. in _____ Inch
Volume _____ Cu. Ft.
Rock Pressure _____ lbs. _____ hrs.
Oil None recorded bbls., 1st 24 hrs.
Fresh water No record feet _____ feet
Salt water No record feet 1430 feet

Casing and Tubing	Used in Drilling	Left in Well	Packers
Size			Kind of Packer
16			
13			
10	510	Pulled	Size of
8 1/4	120	120	
6 3/8	1755	1755	Depth set
5 3/16	2713	2713	
3			Perf. top
2			Perf. bottom
Liners Used			Perf. top
			Perf. bottom

CASING CEMENTED _____ SIZE _____ No. Ft. _____ Date _____
No record of any cementing
COAL WAS ENCOUNTERED AT 380 FEET 48 INCHES
495 FEET 84 INCHES FEET INCHES
FEET INCHES FEET INCHES

Formation	Color	Hard or Soft	Top	Bottom	Oil, Gas or Water	Depth Found	Remarks
Mapletown Coal			380	384			
Pittsburgh Coal			495	502			
SALT SAND			1305	1455	Water	1430	
Big Lime			1755	1824			
BIG INJUN			1824	1984	Gas	1925	
Fifty Foot			2408	2458			
Gordon Sand			2713	2768			
5th sand			2866	2885	Gas	2857-75	

Total Depth 2904'

