


LATITUDE 39 35

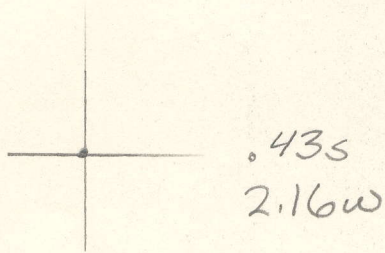

LONGITUDE 80 25

7'5 OGIS topo location

7.5' loc \_\_\_\_\_ 15' loc \_\_\_\_\_  
 \_\_\_\_\_ (calc.) \_\_\_\_\_

Company \_\_\_\_\_ 1506 \_\_\_\_\_

Farm J. L. HAMILTON

Quad GLOVER GAP

County MARION

District MANNINGTON

WELL LOCATION MAP

File No. 30092

Plat of Well Nos. 354, 355, 356, 358, 365, 366, 367, 368, 1506 & Hope 3788 of the  
 Hope Construction & Refining Co., & Hope Natural Gas Co. Clarkburg, W. Va., on the  
 James Campbell, E. L. Cole & J. L. Hamilton Farm consisting of Acres  
 Mannington District Marion County, W. Va.

Campbell	100a
Cole	93a
Hamilton	126a
"	35a



- LEGEND
- Location
  - Oil Well
  - ⊗ Aband.
  - ⊕ Gas Well
  - ⊙ Aband.
  - ⊖ Dry Hole
- Field Book No. 871-52-34  
 Scale 1" = 40' P.M.S.  
 4/19/34

Mannington District, Marion County, W. Va.

By Hope Construction & Refining Co., 445 W. Main St.,  
Clarksburg, W. Va.

On 161½ acres, surface owned by J. L. Hamilton Heirs (Alice Hamilton), Route 6, Mannington, W. Va.; owner of mineral rights, unknown.

Elevation, 1085' L.

8½" casing, 1390'; 6-5/8", 1851'; 5-3/16" liner, 175'.

Coal was encountered at 822 and 908-916'.

Abandonment reported to Dept. of Mines April 12, 1934.

Well was shot at 2073-2086'.

Salt water at 1720-1855'.

Oil well.

MAR-92-A

	Top.	Bottom.	Thickness.
Coal	822	-	No record
Pittsburgh Coal	908	-	No record (App. 8')
Little Dunkard Sand	1225	- 1245	20
Big Dunkard Sand	1385	- 1455	70
Gas Sand	1570	- 1625	55
First Salt Sand (water, 1720')	1708	- 1760	52
Second Salt Sand (water, 1855')	1825	-	No record
Maxton Sand (oil, 2061-2064-2086; gas, 2059')	2051	-	No record
Big Lime	2121	- 2200	79
Big Injun Sand (oil, 2270-2276')	2200		
Total depth			2295