


LATITUDE 39 32 30

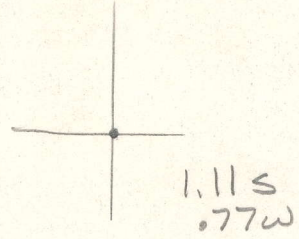

LONGITUDE 80 17 30

7.5 OGIS topo location

7.5' loc _____ 15' loc _____
 _____ (calc.) _____

Company _____

Farm FESTUS DOWNS 5

Elev. 1178 - on plat
30640

Quad MANNINGTON


County MARION

District LINCOLN

WELL LOCATION MAP

File No. 36126

in Lincoln District, Marion County, West Virginia.

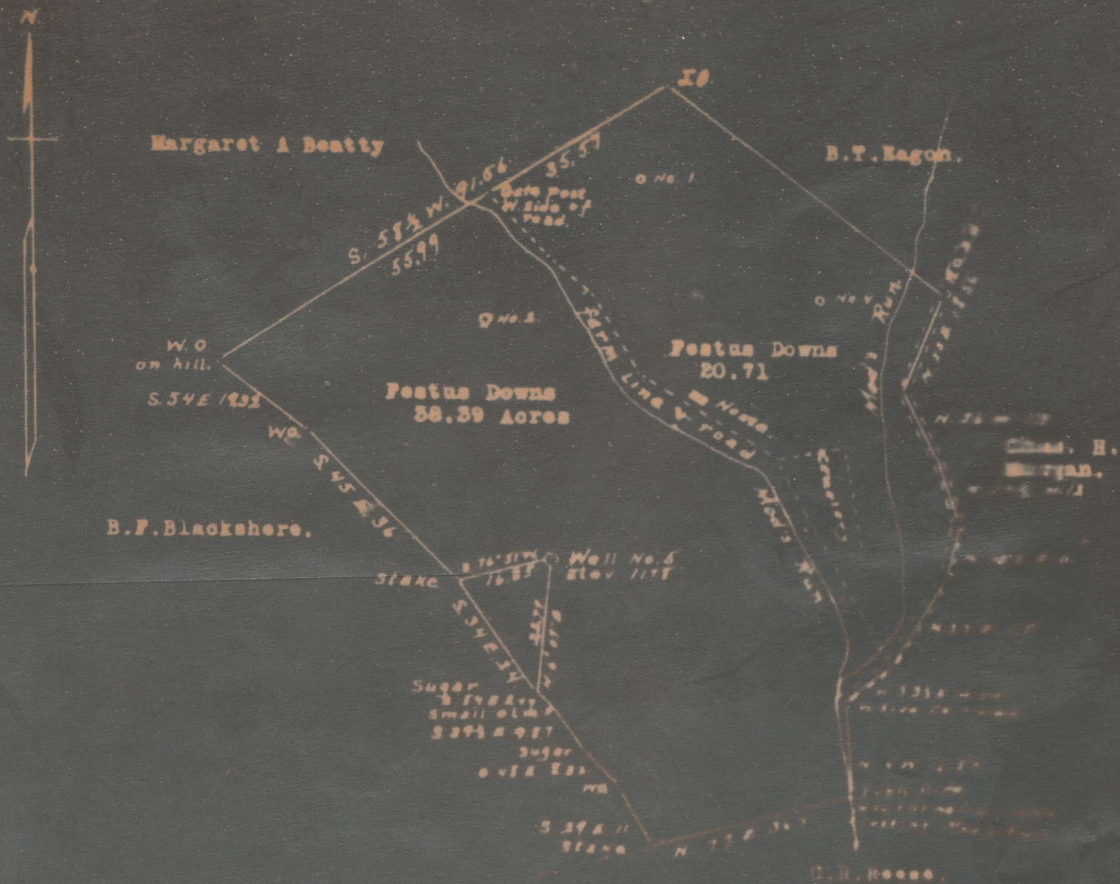

ENGINEER'S CERTIFICATE.

I, the undersigned hereby certify that this map is correct and shows all the information to the best of my knowledge and belief, required by the oil and gas section of the Mining Laws of West Virginia.

A. L. Beatty
Engineer
Fairview, W. Va.

Acknowledged before me a Notary Public, in and for Monongalia County, West Virginia, this the _____ day of December, 1938
My commission expires

July 7, 1940

Osney W. Morgan
Notary Public

11) 10) 126

Name	Color	Character	Oil, Gas or Water	Top	Bottom	Thickness	Total Depth	Remarks
Maple town Coal	462							
Pittsburgh Coal	502			7 "				
Salt Sand.	1040 - 1020							
Big Lime	160 - 135							
Big Injun + Sand. Bayard.	1950 - 2090							

Wells used in district
 Foster Downs #4
 Wilson #2
 BF Blockhouse #15

shot
 Well was not shot at _____ feet; well was shot at _____ feet.

oil
 Fresh water at _____ feet; oil water at _____ feet.

producing
 Well was _____ lbs.

dry

 Date

 Approved

 Owner

NOTE: All bottom layer "one" must be noted as indicated above and all top-cuts and oil and gas sands must be recorded under their proper geological names in the district as well as any local names commonly used in the district for each strata.

Rachel Coal and Coke Co.

Rachel, W. Va.

Victor E. Tennant

Fairview, W. Va.

Aug. 21

19 39

Lincoln

District

Marion

County

Well No. 6

Pectus Downs

Farm

AFFIDAVIT TO BE MADE IN TRIPLICATE. ONE COPY TO BE MAILED BY REGISTERED MAIL TO THE DEPARTMENT. ONE COPY TO BE RETAINED BY THE WELL OPERATOR AND THE THIRD COPY (AND EXTRA COPIES IF REQUIRED) TO BE MAILED TO EACH COAL OPERATOR ABOVE NAMED AT THEIR RESPECTIVE ADDRESSES.

AFFIDAVIT

STATE OF WEST VIRGINIA,

COUNTY OF Marion

VS:

Victor E. Tennant

and B. R. Mahay

being first duly sworn according to law depose and say that they are experienced in the work of plugging and filling oil and gas wells and were employed by Victor E. Tennant, well operator, and participated in the work of plugging and filling the above well, that said work was commenced on the 20th day of November, 1939, and that the well was plugged and filled in the following manner:

Manner in which sand was plugged:

Wood plug driven at 2010, cement to 1990. Clay to 1900, wood plug and cement to 1885. Clay to 1810 and cement to 1795. Clay 1855 wood plug to 1880. The 6" casing could not be pulled and was left in hole intact. Filled with clay solid to 700', wood plug and cement to to 610' using 24 sacks of cement. The 6" casing was left open from this point at the request of the Seal Company to be as a vent for possible gas leakage.

Manner in which coal was plugged:

Description of monument:

See letter 10/29
Describing monument
in above well
Filed Nov-63

(THIS ABOVE DESCRIPTION MUST BE IN DETAIL AND IN ACCORDANCE WITH THE PROVISIONS OF SECTION 10, ARTICLE 4, CHAPTER 22 OF THE CODE)

and that the work of plugging and filling said well was completed on the 22 day of June, 19 39

And further deponents saith not.



Sworn to and subscribed before me this 22 day of August, 1939

Commission expires:

Victor E. Tennant
B. R. Mahay
T. N. Wilson, N.P.
Notary Public