


LATITUDE 39 40

LONGITUDE 80 22 30

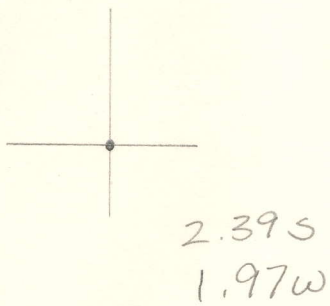

7'5 OGIS topo location

7.5' loc _____ 15' loc _____
 _____ (calc.) _____

Company _____

Farm REBECCA GLOVER 1

Quad HUNDRED

County MARION

District MANNINGTON

WELL LOCATION MAP

File No. 30148

WEST VIRGINIA DEPARTMENT OF MINES

OIL AND GAS DIVISION

PRELIMINARY DATA SHEET NO. 1

File No. _____ Well No. 1

Funk & Hull. Company of Hundred, W. Va.

#1 well on the Rebecca Glover. Farm

containing 154.5 acres. Location _____

Mannington District, in Marion Marion County, West Virginia

The surface of the above tract is owned in fee by Rebecca Glover.

of Hundred, W. Va. address, and the mineral rights are owned by

Funk & Hull. of Hundred, W. Va.

The oil and gas privileges are held under lease by the above named company, and this well is drilled under permit No. _____ issued by the West Virginia Department of Mines, Oil and Gas Division

_____ 198 _____

Elevation of surface at top of well, _____ Spirit Barometric

The number of feet of the different sized casings used in the well.

_____ feet _____ size. Wood conductor.

215' feet 10" size, csg. _____ feet _____ sized cap.

1705' feet 8 1/2" size, csg. _____ feet _____ sized cap

2637' feet 6-5/8" size, csg. _____ feet _____ sized cap

2794' 5-3/16" packer of _____ size, set at _____

_____ packer of _____ size, set at _____

_____ in casing perforated at _____ feet to _____ feet

_____ in casing perforated at _____ feet to _____ feet

Coal was encountered at _____ feet, thick near _____ inches, and at _____

feet; thickness _____ inches; and at _____ feet; thickness _____ inches.

_____ feet; thickness _____ inches; and at _____ feet; thickness _____ inches.

Liners were used as follows: (Give details) _____
