


0 1 2 3 LATITUDE 39° 30'

1 2 3 LONGITUDE 80° 15'

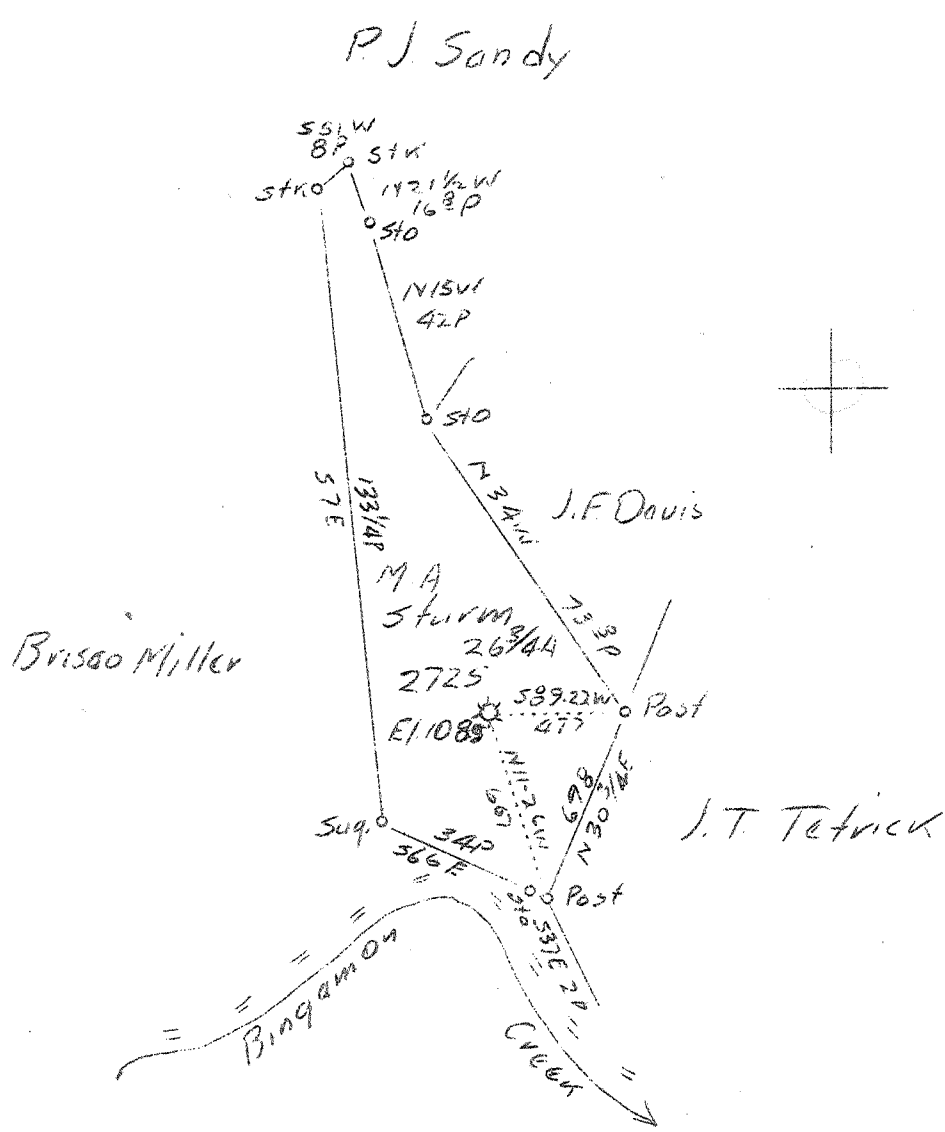

1.82 W
 4.42 S
 4.36 S
 1.80 W

Abcl

FB 568 Pg 13

Company Hope Natural Gas Co.	STATE OF WEST VIRGINIA Department of Mines OIL AND GAS DIVISION CHARLESTON
Address Clarksburg, W.Va.	
Farm Malissa A. Sturm	WELL LOCATION MAP File No. <u>MAR-177A</u>
Tract Acres 26 ³ / ₄ Lease No. 21216	
Well (Farm) No. 1 Serial No. 2725	+ Denotes location of well on United States Topographic Maps, scale 1 to 62,500, latitude and longitude lines being represented by border lines as shown.
Elevation (Spirit Level) 1089	
Quadrangle Clarksburg (N.E.)	— Denotes one inch spaces on border line of original tracing.
County Marion District Mannington	
Engineer J.W. Clark	
Engineer's Registration No. 744	
File No. _____ Drawing No. _____	
Date Sept. 23, 1937 Scale 1"=40 Poles	