


LATITUDE 39° 30'

LONGITUDE 80° 15'

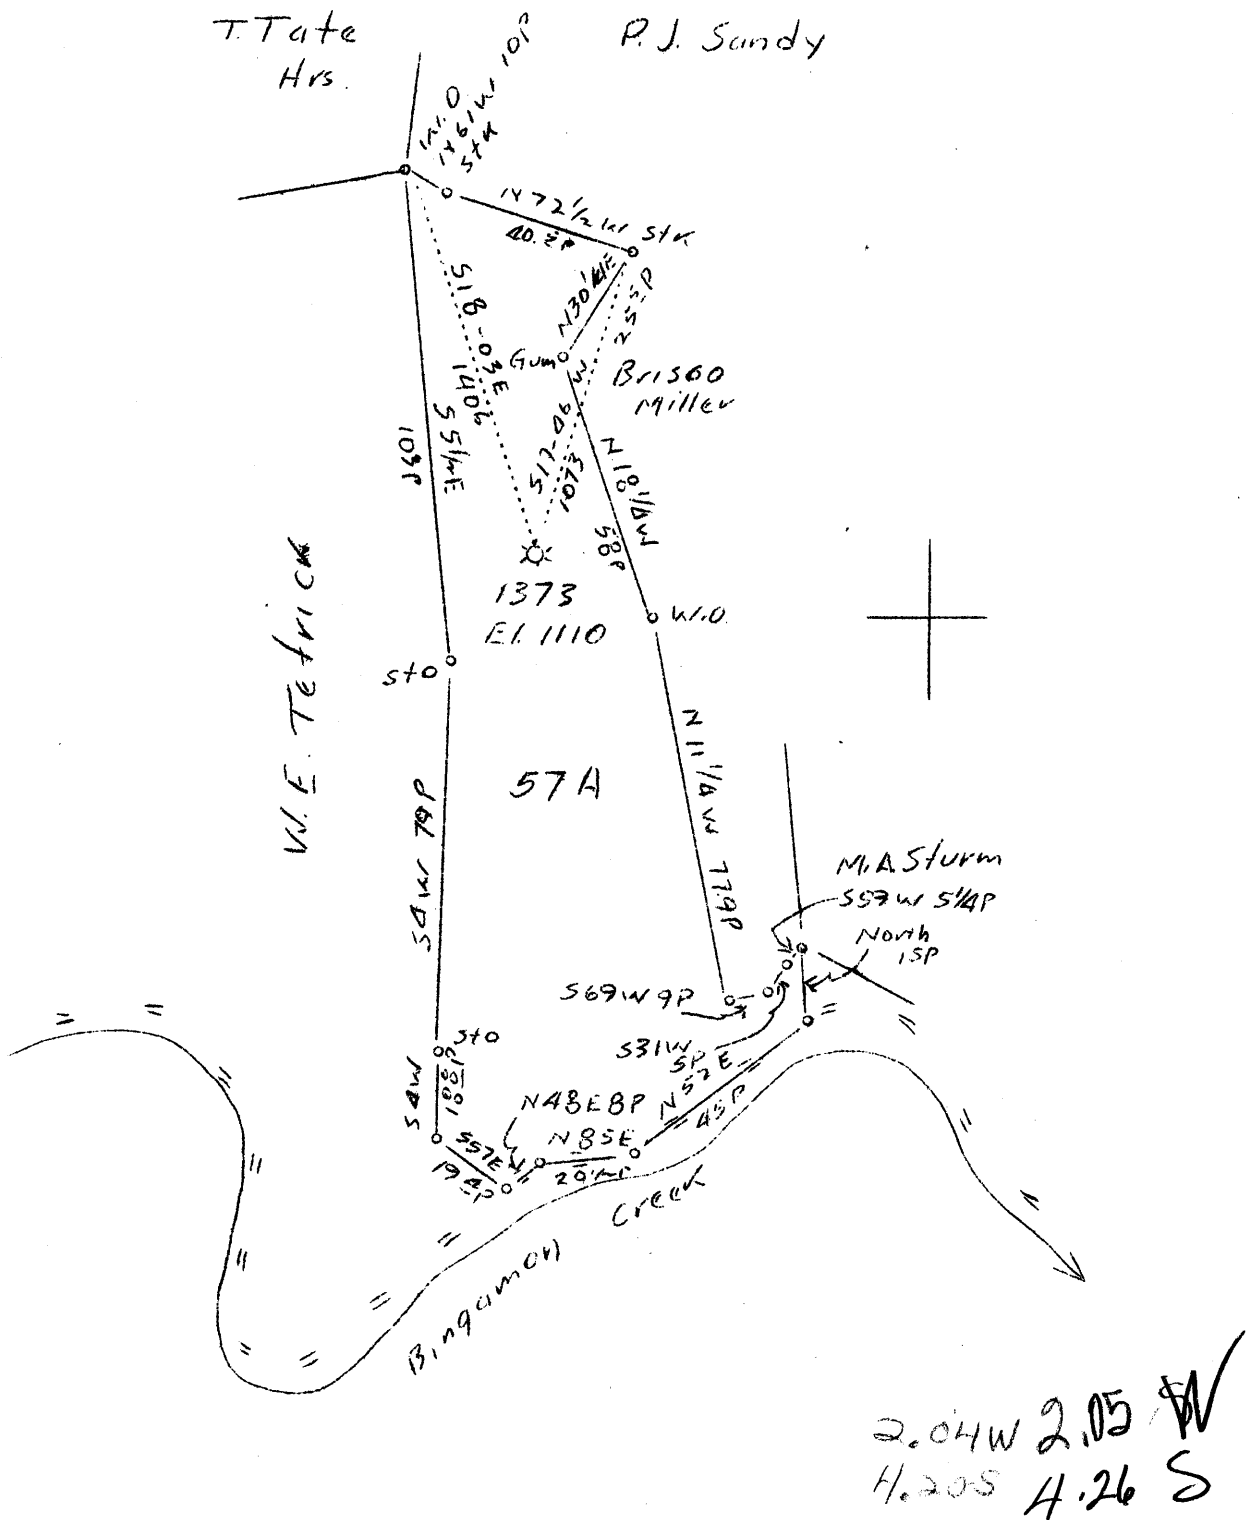

Abd.

F.B 568 Pg 12-15

|                             |                             |
|-----------------------------|-----------------------------|
| Company                     | Hope Nat. Gas Co.           |
| Address                     | Clarksburg, W.Va.           |
| Farm                        | E.E. McDaniel               |
| Tract                       | 1 Acres 57 Lease No. 1891   |
| Well (Farm) No.             | 1 Serial No. 1373           |
| Elevation (Spirit Level)    | 1110                        |
| Quadrangle                  | Clarksburg <b>NE</b>        |
| County                      | Marion District Lincoln     |
| Engineer                    | W.M. Bowers                 |
| Engineer's Registration No. | 900                         |
| File No.                    | Drawing No.                 |
| Date                        | Mar. 2, 1938 Scale 1"-40 P. |

STATE OF WEST VIRGINIA  
 Department of Mines  
 OIL AND GAS DIVISION  
 CHARLESTON

WELL LOCATION MAP

File No. MAR-184A

+ Denotes location of well on United States Topographic Maps, scale 1 to 62,500, latitude and longitude lines being represented by border lines as shown.

— Denotes one inch spaces on border line of original tracing.