


LATITUDE 39 37 30

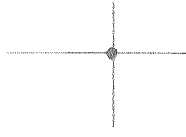

.65s

1.09s

LONGITUDE 80 22 30

7'5 OGIS topo location

7.5' loc _____ 15' loc _____
(calc.) _____

Company _____ (557)

Farm DANIEL FREELAND 7

Quad GLOVER GAP

County MARION

District MANNINGTON


WELL LOCATION MAP

File No. 30185

Spots too
far south
for 15°
latitude
degree
given

LATITUDE 39° 40'

LONGITUDE 80° 20'

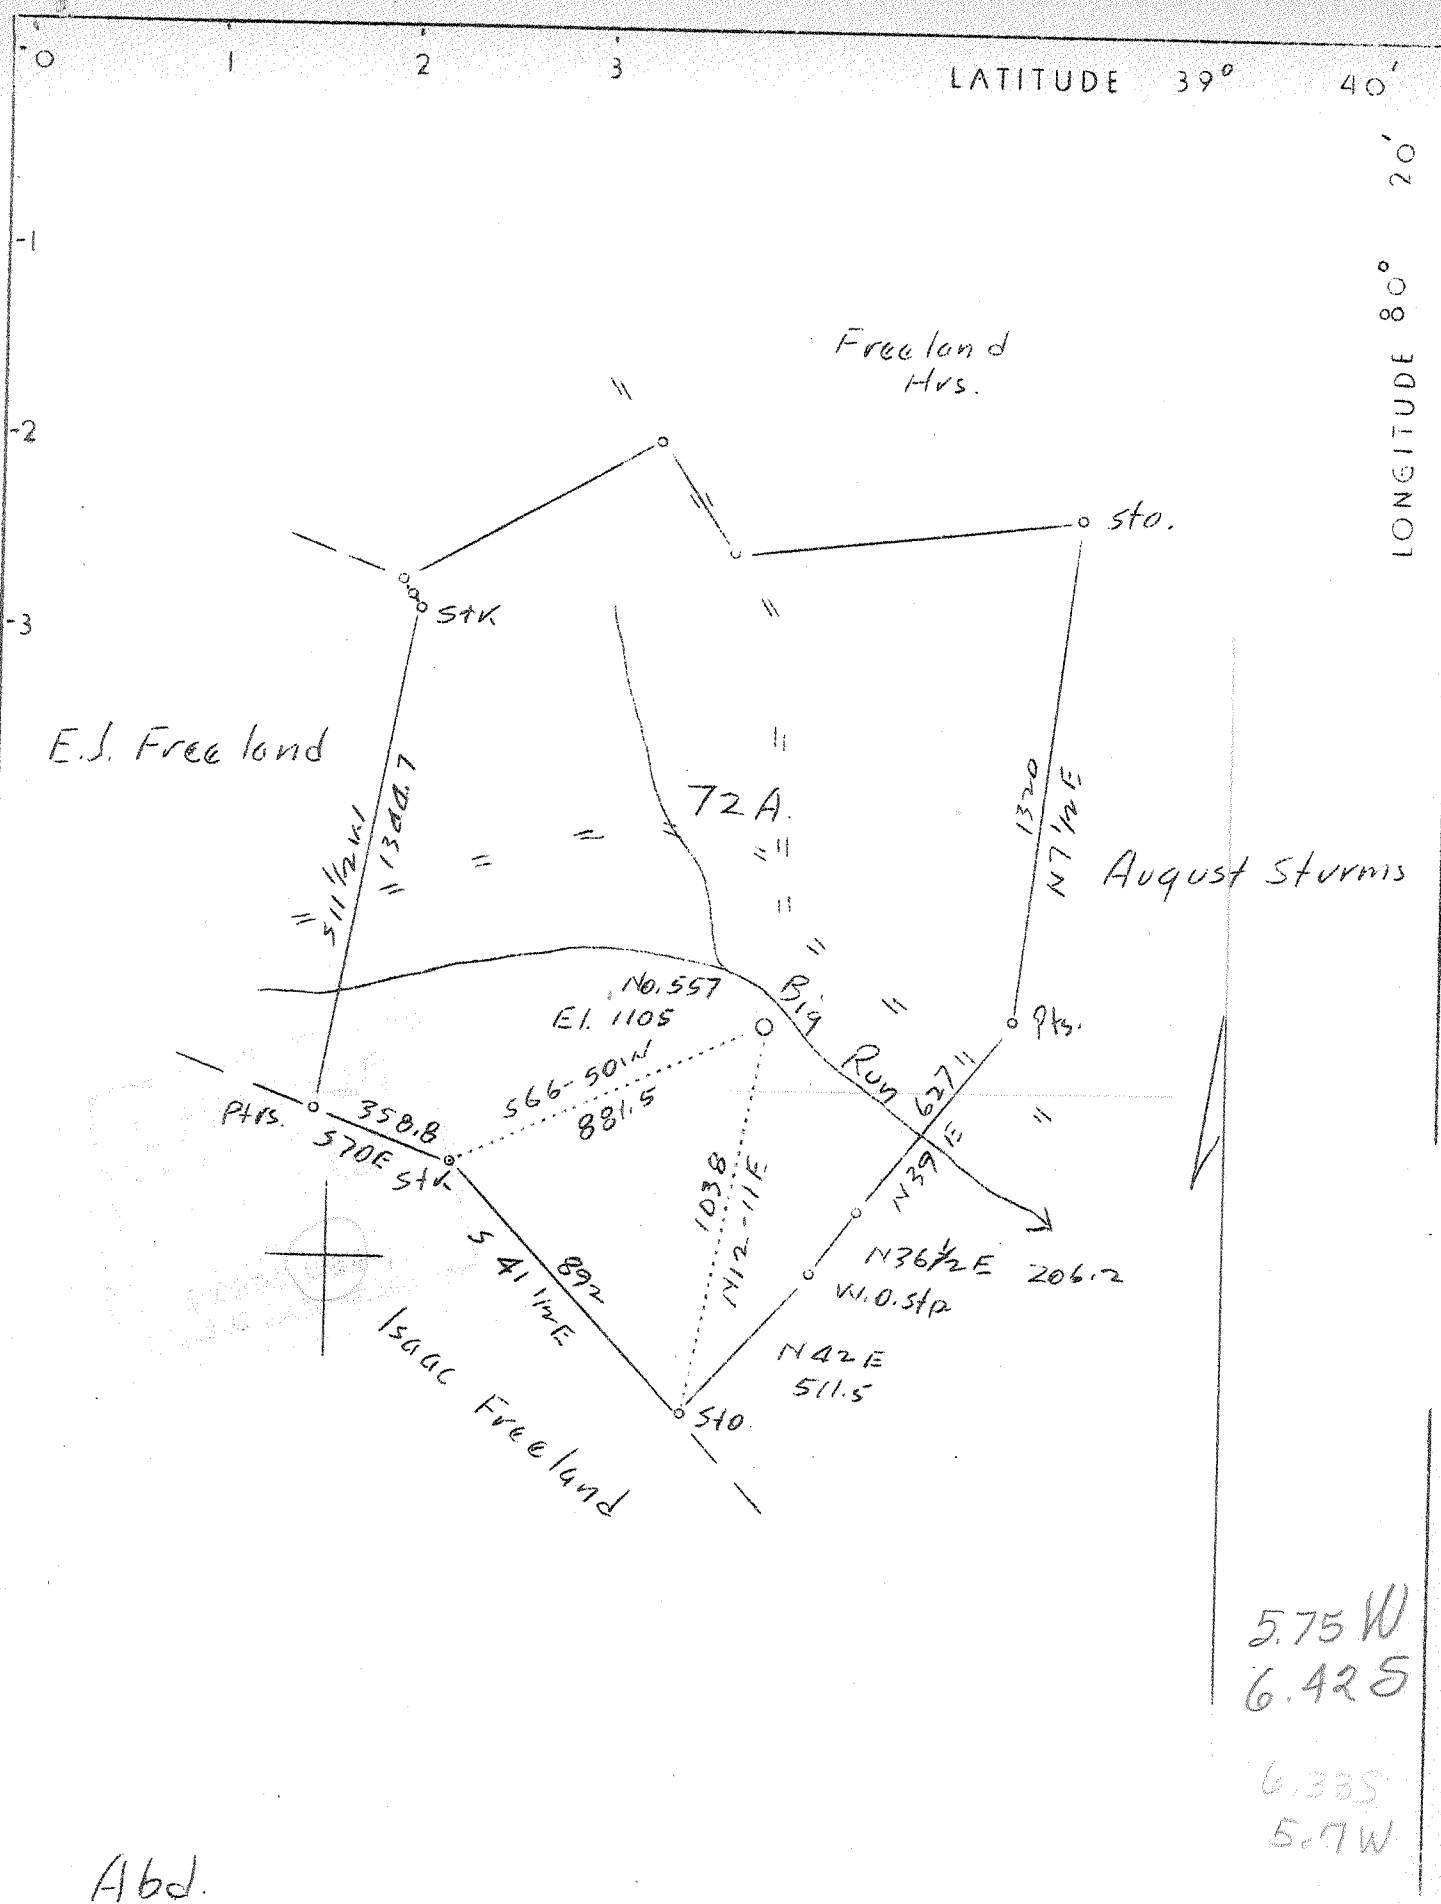

5.75 W
 6.425
 6.335
 5.7 W

Abd.

Company	G.L. Phillips
Address	Blacksville, W. Va.
Farm	Daniel Freeland
Tract 1	Acres 72 Lease No.
Well (Farm) No.	7 Serial No. 557
Elevation (Spirit Level)	1105'
Quadrangle	Mannington <i>SW</i>
County	Marion District Mannington
Engineer	A.L. Headley
Engineer's Registration No.	
File No.	Drawing No.
Date	11-6-1937 Scale 1"-500'

STATE OF WEST VIRGINIA
 Department of Mines
 OIL AND GAS DIVISION
 CHARLESTON

WELL LOCATION MAP
 File No. MAR-185A

+ Denotes location of well on United States Topographic Maps, scale 1 to 62,500, latitude and longitude lines being represented by border lines as shown.
 — Denotes one inch spaces on border line of original tracing.