


LATITUDE 39° 30'

LONGITUDE 80° 15'

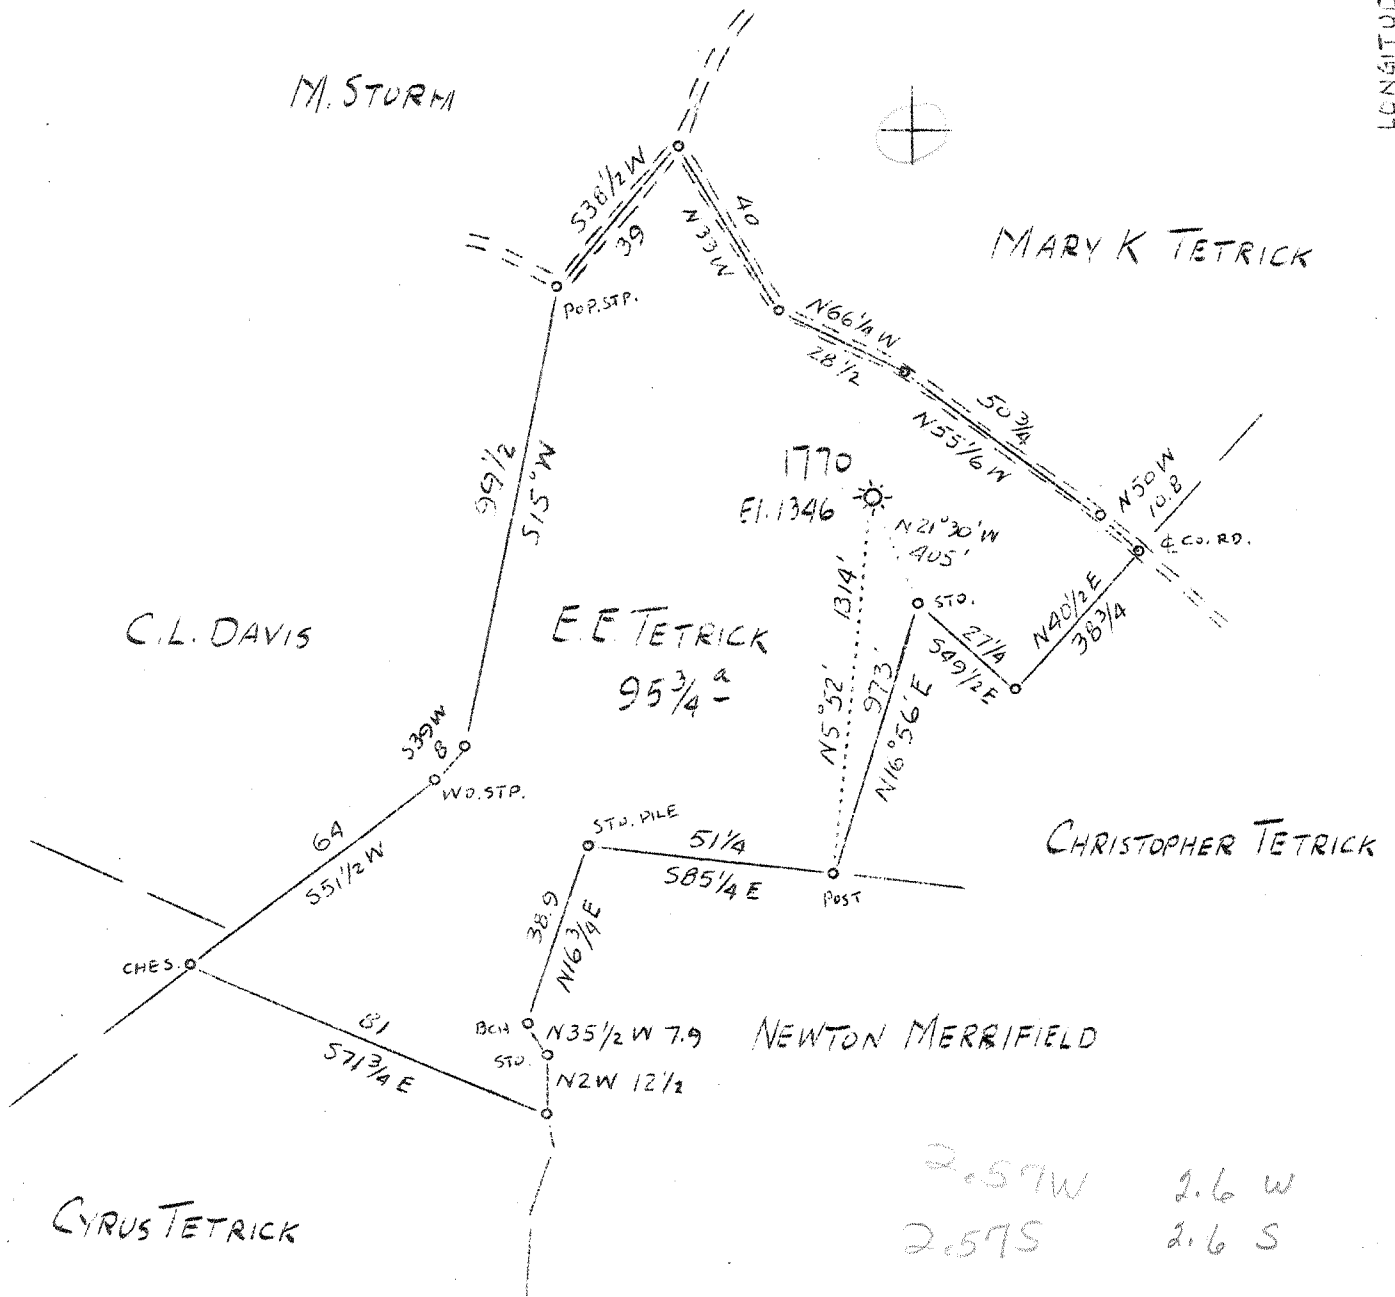

ABANDONMENT

F.B. 665 P.7 N1E 18 Sh. 30

Company	Hope Natural Gas Co.,
Address	Clarksburg, W. Va.
Farm	E. E. Tetrick
Acres	97
Lease No.	975
Well (farm No.)	3
Serial No.	1770
Elevation (SP)	1346
Quadrangle	Clarksburg N.E
County	Marion
District	Lincoln
Engineer	W. M. Bowers
Eng. Reg. No.	900
Date	August 23, 1938
Scale	1" = 40 poles

STATE OF WEST VIRGINIA
 Department of Mines
 OIL & GAS DIVISION
 Charleston

WELL LOCATION MAP

File No. MAR-199 A

x Denotes location of well on U. S. Topographic Maps, scale 1 to 62,500, latitude and longitude lines being represented by border lines as shown.

- Denotes one inch spaces on border line of original tracing.