


LATITUDE 39 32 30

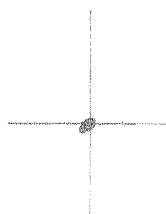

1.27s

2.09w

LONGITUDE 80 12 30

7'5 OGIS topo location

7.5' loc \_\_\_\_\_  
\_\_\_\_\_

15' loc \_\_\_\_\_  
(calc.) \_\_\_\_\_

Company \_\_\_\_\_ (1798)

Farm HAMILTON-HARDESTY 1


Quad GRANT TOWN

County MARION

District LINCOLN

WELL LOCATION MAP

File No. 30337

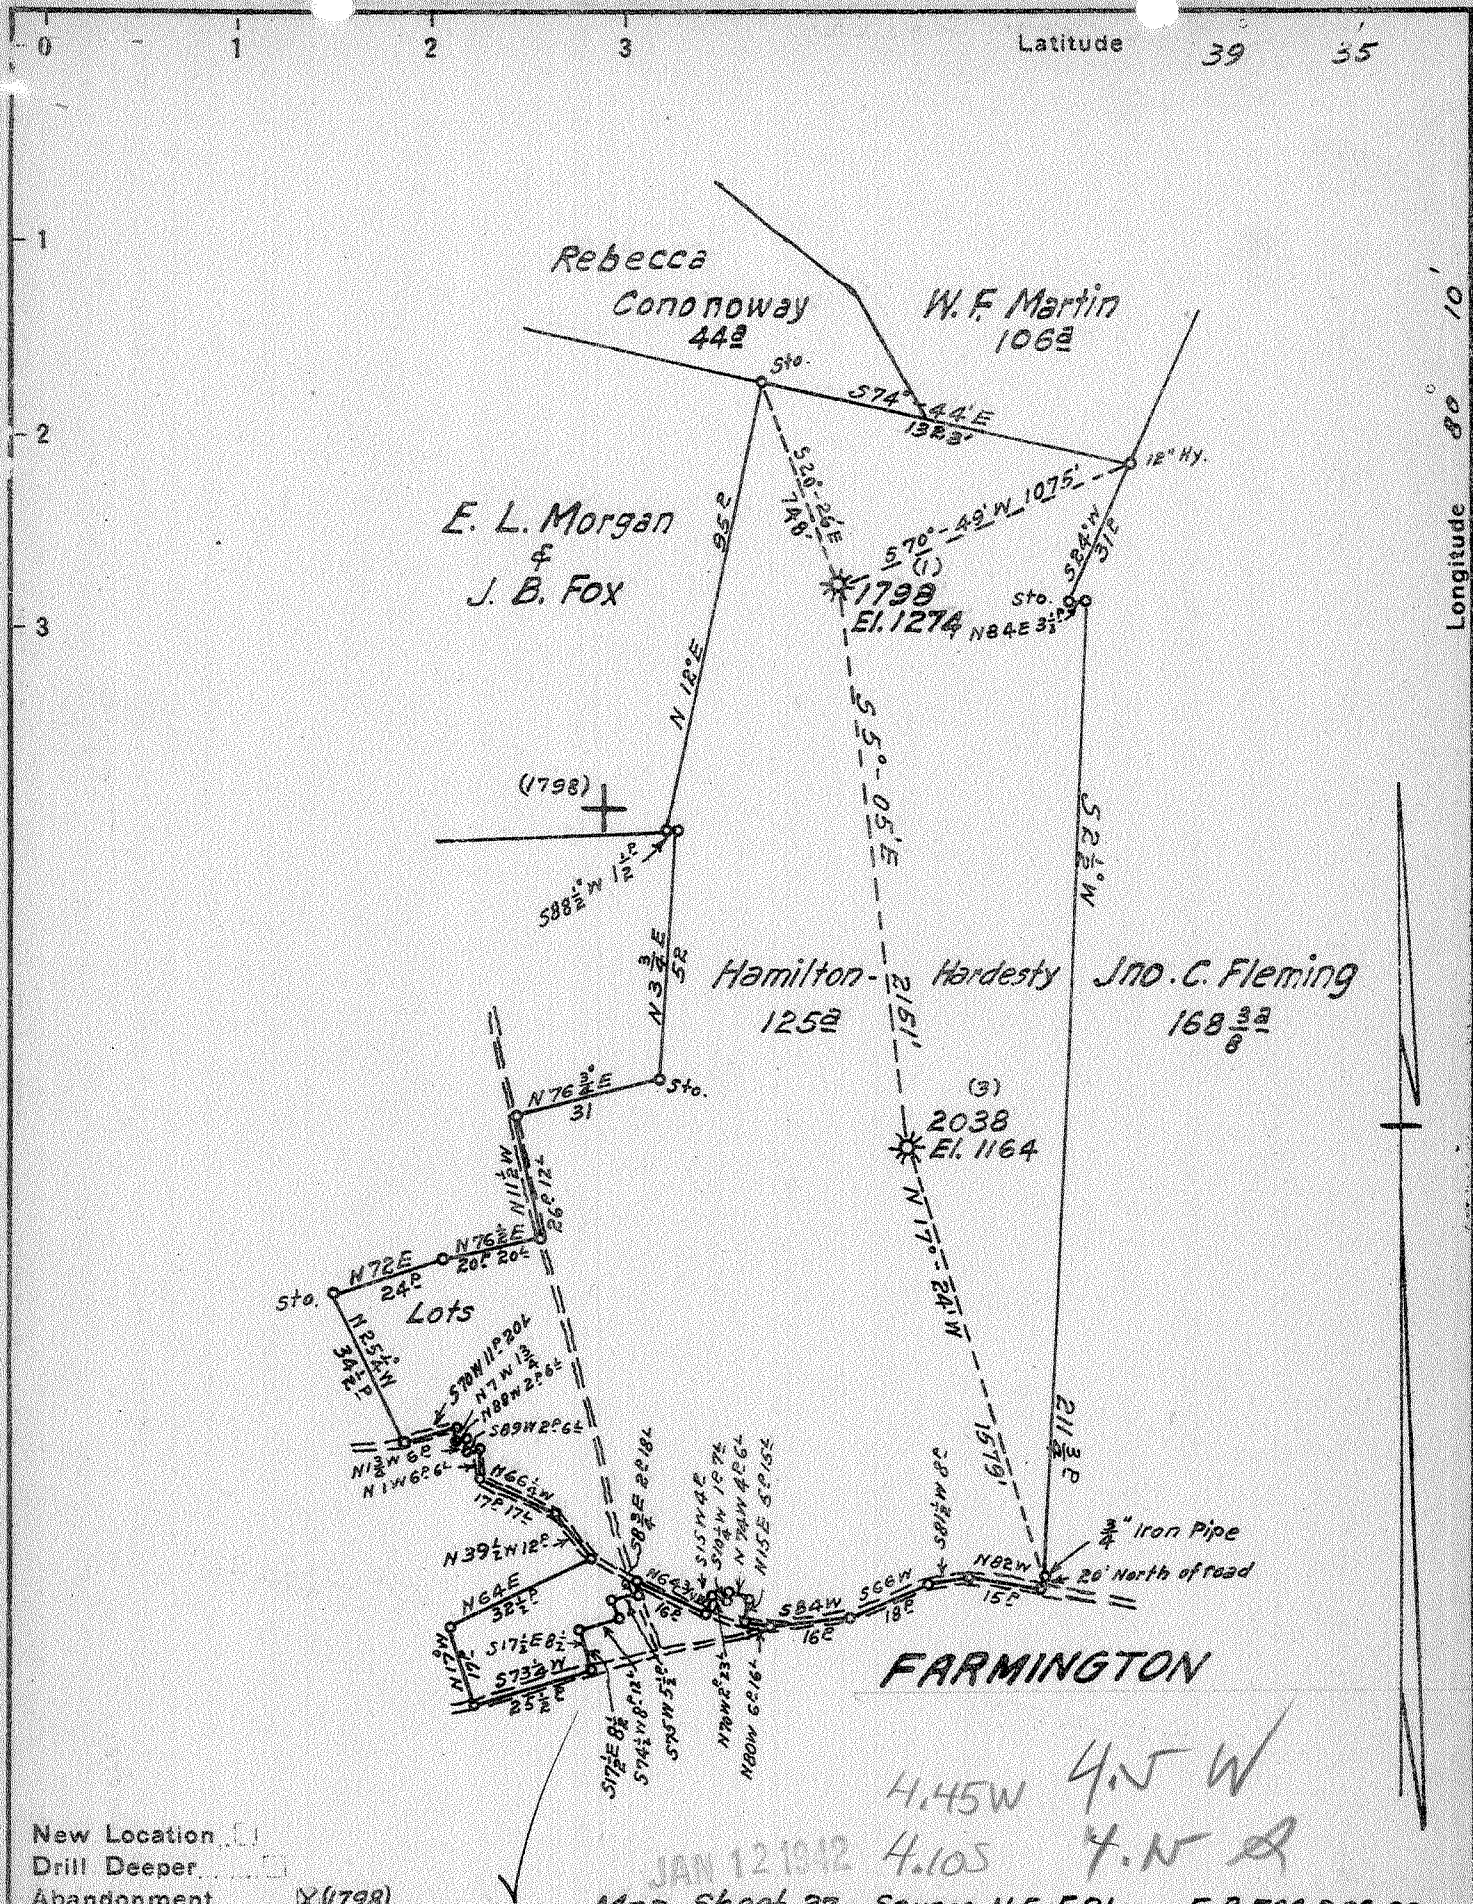

New Location   
 Drill Deeper   
 Abandonment  (1798)

JAN 12 1942  
 Map Sheet 27 - Square N 5 E R 1 - F B 706 P 38-39

Company Hope Natural Gas Co.  
 Address Clarksburg, W. Va.  
 Farm Hamilton - Hardesty  
 Tract Acres 125 Lease No. 20735  
 Well (Farm) No. 143 Serial No. 1798, 2038  
 Elevation (Spirit Level) 1274-1164  
 Quadrangle Blacksville  
 County Marion District Lindola  
 Engineer Wm Bowers  
 Engineer's Registration No. 900  
 File No. \_\_\_\_\_ Drawing No. \_\_\_\_\_  
 Date Jan. 6 1942 Scale Scale 1" = 40'

STATE OF WEST VIRGINIA  
 DEPARTMENT OF MINES  
 OIL AND GAS DIVISION  
 CHARLESTON

**WELL LOCATION MAP**  
 FILE NO. MAR-337-A

①  
 † Denotes location of well on United States Topographic Maps, scale 1 to 62,500, latitude and longitude lines being represented by border lines as shown.  
 - Denotes one inch spaces on border line of original tracing.

STATE OF WEST VIRGINIA  
DEPARTMENT OF MINES  
OIL AND GAS DIVISION

440

WELL RECORD

Permit No. 337-A

Oil or Gas Well Gas  
(Kind)

Company Hope Natural Gas Company  
 Address Clarksburg, W. Va.  
 Farm Hamilton-Merdesty Acres 125  
 Location (waters).....  
 Well No. 1998 Elev. 1274  
 District Lincoln County Lincoln  
 The surface of tract is owned in fee by Charles Flores  
Box 355 Address Farmington, W. Va.  
 Mineral rights are owned by.....  
 Address.....  
 Drilling commenced No record  
 Drilling completed No record Prior to 1911  
 Date shot 4-25-41 Depth of shot 5th sand  
 Open Flow /10ths Water in.....Inch  
 /10ths Merc. in.....Inch  
 Volume.....Cu. Ft.  
 Rock Pressure.....lbs.....hrs.  
 Oil.....bbls., 1st 24 hrs.  
 Fresh water None recorded feet.....feet  
 Salt water None recorded feet.....feet

Casing and Tubing	Used in Drilling	Left in Well	Packers
Size			Kind of Packer.....
16.....			
13.....			
10.....	No record		Size of.....
8 1/4.....	No record		
6 5/8.....	1939	1930	Depth set.....
5 3/16.....			
3.....	4" 1908	1908	Perf. top.....
2.....	3001	Pulled	Perf. bottom.....
Liners Used			Perf. top.....
			Perf. bottom.....

CASING CEMENTED.....SIZE.....No. Ft.....Date  
No record of being cemented  
 COAL WAS ENCOUNTERED AT 593 FEET Est. 72 INCHES  
 FEET.....INCHES.....FEET.....INCHES  
 FEET.....INCHES.....FEET.....INCHES

Formation	Color	Hard or Soft	Top	Bottom	Oil, Gas or Water	Depth Found	Remarks
Coal			593	Estimated 599			
Salt Sand			1840				
Big Lime			1860	1928			
Big Injun			1928	2063	Gas	1939	
Gantz Sand			2430	2465			
Fifty Foot Sand			2488	2546			
Thirty Foot Sand			2570	2588			
Fourth Sand			2887	2850			
Fifth Sand			2955		Gas	2955	
Original Total Depth-----			3001				
2 string of tools lost in hole and bad cave at 2175.							
Present depth-----			2175				

