


Latitude

Longitude

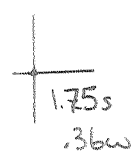

Topo Location

7.5' Loc. _____ 15' Loc. _____
 _____ (calc.) _____

Company _____

Farm _____


15' Quad _____
(sec.)

7.5' Quad Grant Town

District Paw Paw

WELL LOCATION PLAT

County 049 Permit 30370

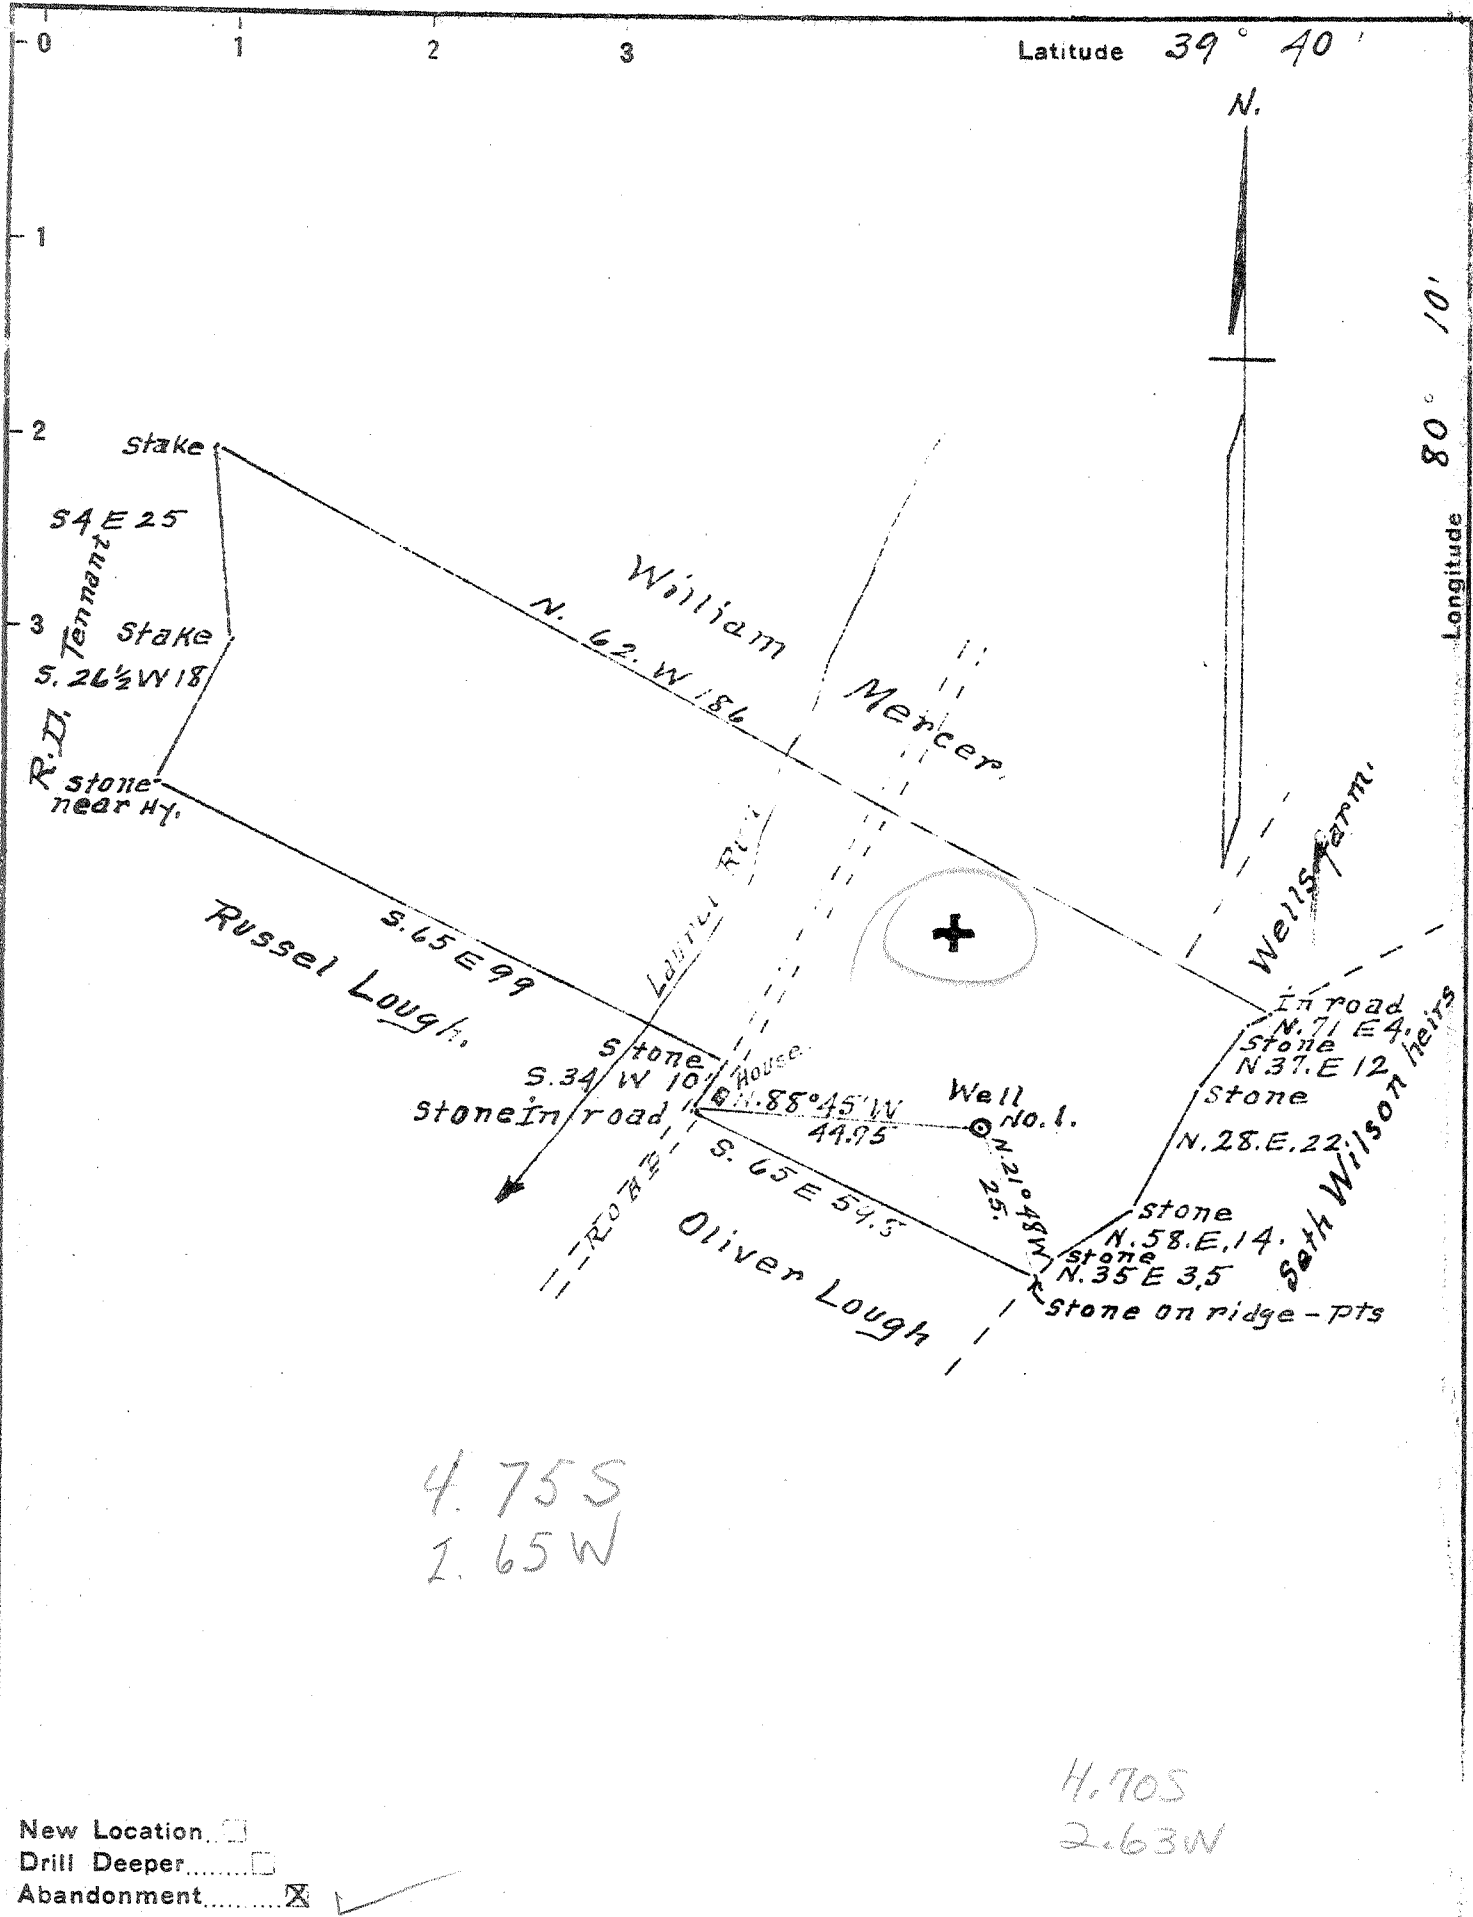

Company Harry L. Tennant
 Address Wadestown W. Va.
 Farm Russell Lough.
 Tract one Acres 46 1/2 Lease No. _____
 Well (Farm) No. one Serial No. _____
 Elevation (Spirit Level) 1236'
 Quadrangle Blacksville.
 County Marion District Paw Paw
 Engineer A. L. Headley.
 Engineer's Registration No. _____
 File No. _____ Drawing No. _____
 Date 2-12-1943 Scale 1 inch = 30 poles

STATE OF WEST VIRGINIA
 DEPARTMENT OF MINES
 OIL AND GAS DIVISION
 CHARLESTON

WELL LOCATION MAP
 FILE NO. MAR-370-A

+ Denotes location of well on United States Topographic Maps, scale 1 to 62,500, latitude and longitude lines being represented by border lines as shown.

- Denotes one inch spaces on border line of original tracing.