

New Location
 Drill Deeper
 Abandonment

2.945
 3.71 W
 3.77 W
 3.0 P
 MAR - 1 1944

Map Sheet 30 Squares S1 E 21 F B 568 P 9

Company HOPE NATURAL GAS CO.
 Address CLARKSBURG, W. VA.
 Farm GEO. W. KOON
 Tract _____ Acres 64 Lease No. 5158
 Well (Farm) No. 1 Serial No. 1907
 Elevation (Spirit Level) 991
 Quadrangle FAIRMONT
 County MARION District LINCOLN
 Engineer W. N. Bowers
 Engineer's Registration No. 980
 File No. _____ Drawing No. _____
 Date FEB 4 1944

STATE OF WEST VIRGINIA
 DEPARTMENT OF MINES
 OIL AND GAS DIVISION
 CHARLESTON

WELL LOCATION MAP
 FILE NO. MAR - 395-A

+ Denotes location of well on United States Topographic Maps, scale 1 to 62,500, latitude and longitude lines being represented by border lines as shown.
 - Denotes one inch spaces on border line of original tracing.



465

STATE OF WEST VIRGINIA
DEPARTMENT OF MINES
OIL AND GAS DIVISION

Permit No. 395-A

WELL RECORD

Oil or Gas Well
(KIND)


Company Hope Natural Gas Company
Address 445 West Main St. Clarksburg, W. Va.
Farm G.W. Koon Acres 120
Location (waters) _____
Well No. 1907 Elev. 1177
District Lincoln County Marion
The surface of tract is owned in fee by _____
Address _____
Mineral rights are owned by _____
Address _____
Drilling commenced August 1, 1910
Drilling completed September 23, 1910
Date Shot _____ From _____ To _____
With _____
Open Flow _____ /10ths Water in _____ Inch
_____ /10ths Merc. in _____ Inch
Volume _____ Cu. Ft.
Rock Pressure _____ lbs. _____ hrs.
Oil _____ bbls., 1st 24 hrs.
Fresh water _____ feet _____ feet
Salt water 1020 feet _____ feet

Casing and Tubing	Used in Drilling	Left in Well	Packers
Size			
16			Kind of Packer
13			
10	131	131	Size of
8 1/2	1126	Pulled	
6 5/8	1482	1482	Depth set
5 3/16	2384	Pulled	
3			Perf. top
2	1604	Pulled	Perf. bottom
Liners Used			Perf. top
			Perf. bottom

CASING CEMENTED 10 SIZE 131 No. Ft. 1910 Date _____

COAL WAS ENCOUNTERED AT 100 FEET 96" INCHES
_____ FEET _____ INCHES _____ FEET _____ INCHES
_____ FEET _____ INCHES _____ FEET _____ INCHES

Formation	Color	Hard or Soft	Top	Bottom	Oil, Gas or Water	Depth Found	Remarks
Pittsburgh	Coal		100	108			
Little Dunkard			520	551			
Big Dunkard			625	662			
Gas sand			920	960			
First Salt			1005	1100	water	1020	
Second Salt			1110	1150			
Pencil cave			1385	1395			
Big Lime			1395	1470			
Big Injun			1470	1624	show gas	1489	
Fifty Foot			2000	2051			
Thirty Foot			2070	2100			
Gordon Stray			2312	2327			
Gordon sand			2362	2372			
Fourth sand			2445	2460			
Fifth sand			2491	2522	gas	2493- 2518	
Bayard sand			2617	2624			
Total depth				2675			
In 1917 hole was filled back to				1589			

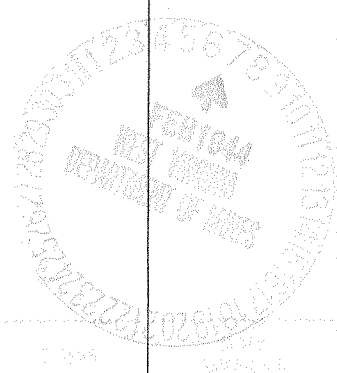

MAR 30 1944

