


956
629
J. A. PRICE

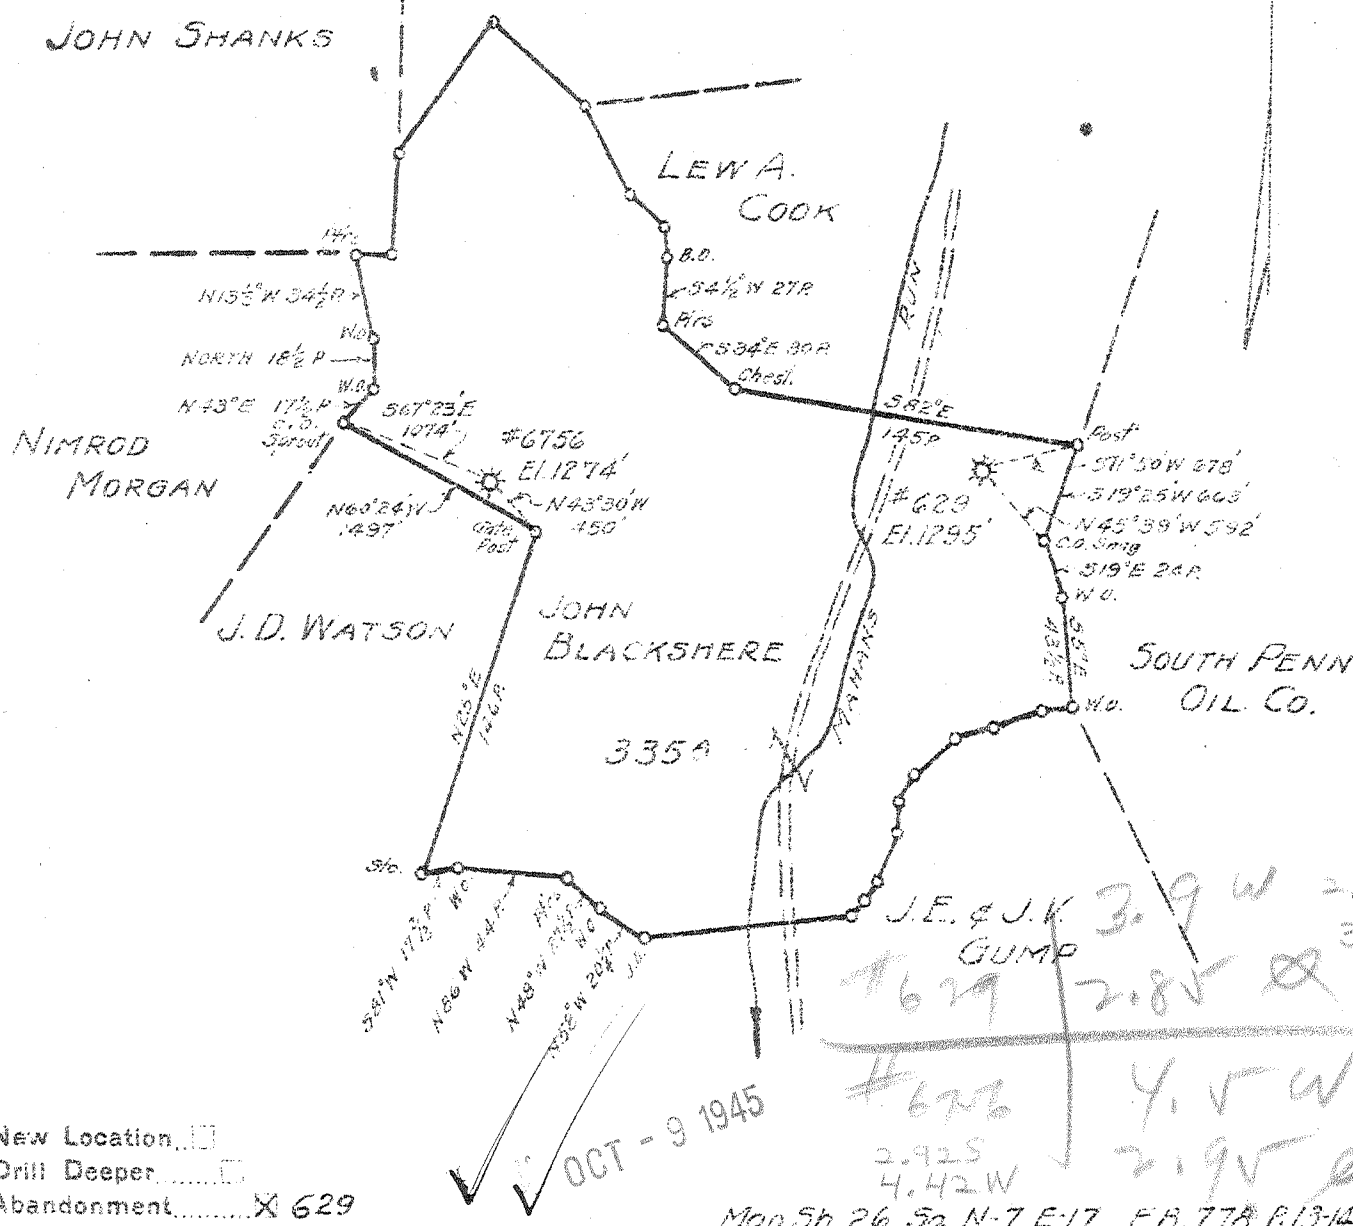

New Location

Drill Deeper

Abandonment 629

OCT - 9 1945

Map Sh. 26 Sq. N-7 E-17 F.B. 778 R. 13-14 & 15

Company HOPE NATURAL GAS CO.

Address CLARKSBURG, W. VA.

Farm JOHN BLACKSHERE

Tract _____ Acres 335 Lease No. 692

Well (Farm) No. 629 Serial No. AS SHOWN

Elevation (Spirit Level) AS SHOWN

Quadrangle MANNINGTON

County MARION District MANNINGTON

Engineer Tom Bowers

Engineer's Registration No. 900

File No. _____ Drawing No. _____

Date 9-25-45 Scale 1" = 80'

STATE OF WEST VIRGINIA
DEPARTMENT OF MINES
OIL AND GAS DIVISION
CHARLESTON

WELL LOCATION MAP
FILE NO. MAR-433-A

+ Denotes location of well on United States Topographic Maps, scale 1 to 62,500, latitude and longitude lines being represented by border lines as shown.

- Denotes one inch spaces on map or original tracing.



507

STATE OF WEST VIRGINIA
DEPARTMENT OF MINES
OIL AND GAS DIVISION

WELL RECORD

Permit No. 433-A

Oil or Gas Well (KIND)

Company Hope Natural Gas Company.
 Address 445 west Main St. Clarksburg, W. Va.
 Farm John Blackshere Acres 335
 Location (waters) _____
 Well No. 629 Elev. 1295
 District Mannington County Marion
 The surface of tract is owned in fee by _____
 Address _____
 Mineral rights are owned by _____
 Address _____
 Drilling commenced April 4, .904
 Drilling completed June 3, 1904
 Date Shot _____ From _____ To _____
 With _____
 Open Flow _____ /10ths Water in _____ Inch
 _____ /10ths Merc. in _____ Inch
 Volume _____ Cu. Ft.
 Rock Pressure _____ lbs. _____ hrs.
 Oil _____ bbls., 1st 24 hrs.
 Fresh water none recorded feet _____ feet
 Salt water none recorded feet _____ feet

Casing and Tubing	Used in Drilling	Left in Well	Packers
Size			
16			Kind of Packer
13			
10	240	Pulled	Size of
8 1/4	1248	Pulled	
6 5/8	2053	2053	Depth set
5 3/16	2262	2262	
3	2615	Pulled	Perf. top
2			Perf. bottom
Liners Used			Perf. top
			Perf. bottom

CASING CEMENTED Not cemented SIZE _____ No. Ft. _____ Date _____

COAL WAS ENCOUNTERED AT 630 FEET ? INCHES
738 FEET ? INCHES FEET INCHES
 FEET INCHES FEET INCHES

Formation	Color	Hard or Soft	Top	Bottom	Oil, Gas or Water	Depth Found	Remarks
Mapletwon Coal			630	636	Est.		
Pittsburgh Coal			738	746	Est.		
Little Dunkard			1045	1076	oil	1056	
Big Dunkard			1244	1320			
Gas sand			1430	1544			
First Salt			1680	1735			
Maxon			1985	1997			
Pencil cave			2020	2024			
Big Lime			2024	2075			
Big Injun			2075	2210			
Fifty foot			2645	2685	gas	2609	
Gordon Stray			2996	3016			
Gordon			3028	3058			
Fourth			3070	3110			
Fifth			3167	3173	gas	3170	
Total depth				3191			
			Filled back in 1-19	to			
				2647			

