

LATITUDE 39 32 30

08 12 30

LONGITUDE

→ 7.5' loc
CNG prop map
(bk 8/1/94)

7'5 OGIS topo location

7.5' loc	<u>2.15S</u>	15' loc	<u>5.03S</u>
	<u>2.16W</u>	(calc.)	<u>4.38W</u>

Company _____ 2027

Farm JAMES BURNS


Quad Blacksville SW
Granttown

County MARLOW

District LINCOLN

WELL LOCATION MAP

File No. 30470

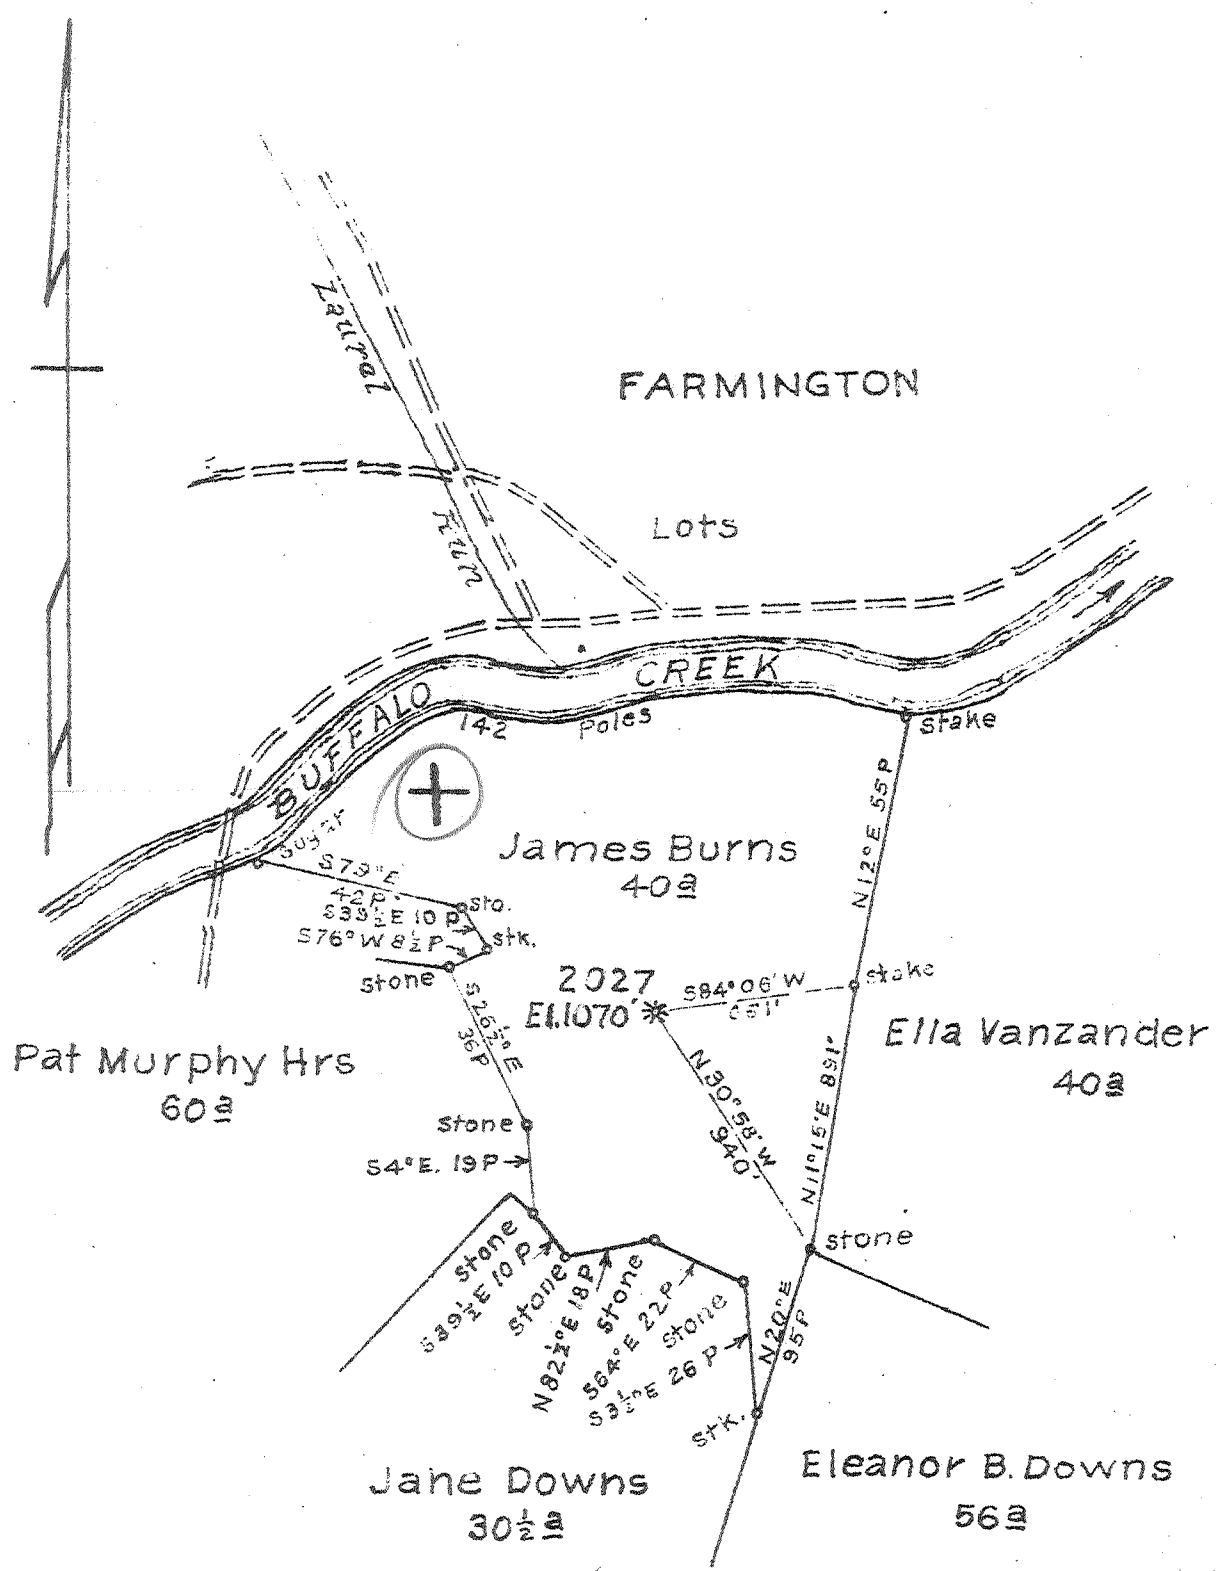

5.025
 4.48W
 JUN 16 1947

View W
 JF/R

New Location
 Drill Deeper
 Abandonment X

Map Sh. 27 N 4 E 20-21 FB 861 P. 19-20

Company	Hope Natural Gas Co.
Address	Clarksburg, W.Va.
Farm	James Burns
Tract	Acres 40
Lease No.	21222
Well (Farm) No.	Serial No. 2027
Elevation (Spirit Level)	1070'
Quadrangle	Blacksville
County	Marion
District	Lincoln
Engineer	W.M. Bowers
Engineer's Registration No.	900
File No.	Drawing No.
Date	6-3-47
Scale	1" = 40 P.

STATE OF WEST VIRGINIA
 DEPARTMENT OF MINES
 OIL AND GAS DIVISION
 CHARLESTON

WELL LOCATION MAP
 FILE NO. MAR-470-A

+ Denotes location of well on United States Topographic Maps, scale 1 to 62,500, latitude and longitude lines being represented by border lines as shown.

- Denotes one inch spaces on border line of original tracing.



STATE OF WEST VIRGINIA
DEPARTMENT OF MINES
OIL AND GAS DIVISION

576

WELL RECORD

Oil or Gas Well (KIND)

Permit No. 470-A

Company Hope Natural Gas Company.
Address 445 West Main St. Clarksburg, W. Va.
Farm James Burns Acres 40
Location (waters) _____
Well No. 2027 Elev. 1070
District Lincoln County Marion
The surface of tract is owned in fee by _____
Address _____
Mineral rights are owned by _____
Address _____
Drilling commenced December 24, 1910
Drilling completed February 24, 1911
Date Shot _____ From _____ To _____
With _____

Casing and Tubing	Used in Drilling	Left in Well	Packers
Size			Kind of Packer
16			
13			
10	435	435	Size of
8 3/4	1423	Pulled	
6 5/8	1759	1759	Depth set
5 3/16	2605	2605	
3			Perf. top
2	2893	Pulled	Perf. bottom
Liners Used			Perf. top
			Perf. bottom

Open Flow _____ /10ths Water in _____ Inch
_____ /10ths Merc. in _____ Inch
Volume _____ Cu. Ft.
Rock Pressure _____ lbs. _____ hrs.
Oil _____ bbls., 1st 24 hrs.
Fresh water none recorded feet _____ feet
Salt water none recorded feet _____ feet

CASING CEMENTED 10 SIZE 435 No. Ft. 1911 Date _____
COAL WAS ENCOUNTERED AT 392 FEET 96 INCHES
_____ FEET _____ INCHES _____ FEET _____ INCHES
_____ FEET _____ INCHES _____ FEET _____ INCHES

Formation	Color	Hard or Soft	Top	Bottom	Oil, Gas or Water	Depth Found	Remarks
Pittsburgh Coal			392	400			
Little Dunkard			830	865			
Big Dunkard			975	1000			
Gas sand			1070	1175			
First Salt			1250	1300			
Second Salt			1329	1445			
Little Lime			1653	1663			
Pencil cave			1663	1675			
Big Lime			1675	1743			
Big Injun			1743	1853			
Squaw			1743	1853			
Gantz			2235	2285			
Fifty foot			2315	2370			
Thirty foot			2405	2422			
Gordon stray			2580	2600			
Gordon			2613	2640			
Fourth			2654	2670			
Fifth			2757		gas	2760 2792	
Total depth				2867			

