

Latitude

Longitude

A hand-drawn crosshair with the following handwritten text: '2.18s' to the right of the vertical line and '1.55w' below the horizontal line.

Topo Location

7.5' Loc. _____ 15' Loc. _____
(calc.) _____

Company _____

Farm _____


15' Quad _____
(sec.)

7.5' Quad Grant Town

District Paw Paw

WELL LOCATION PLAT

County 049 Permit 30481

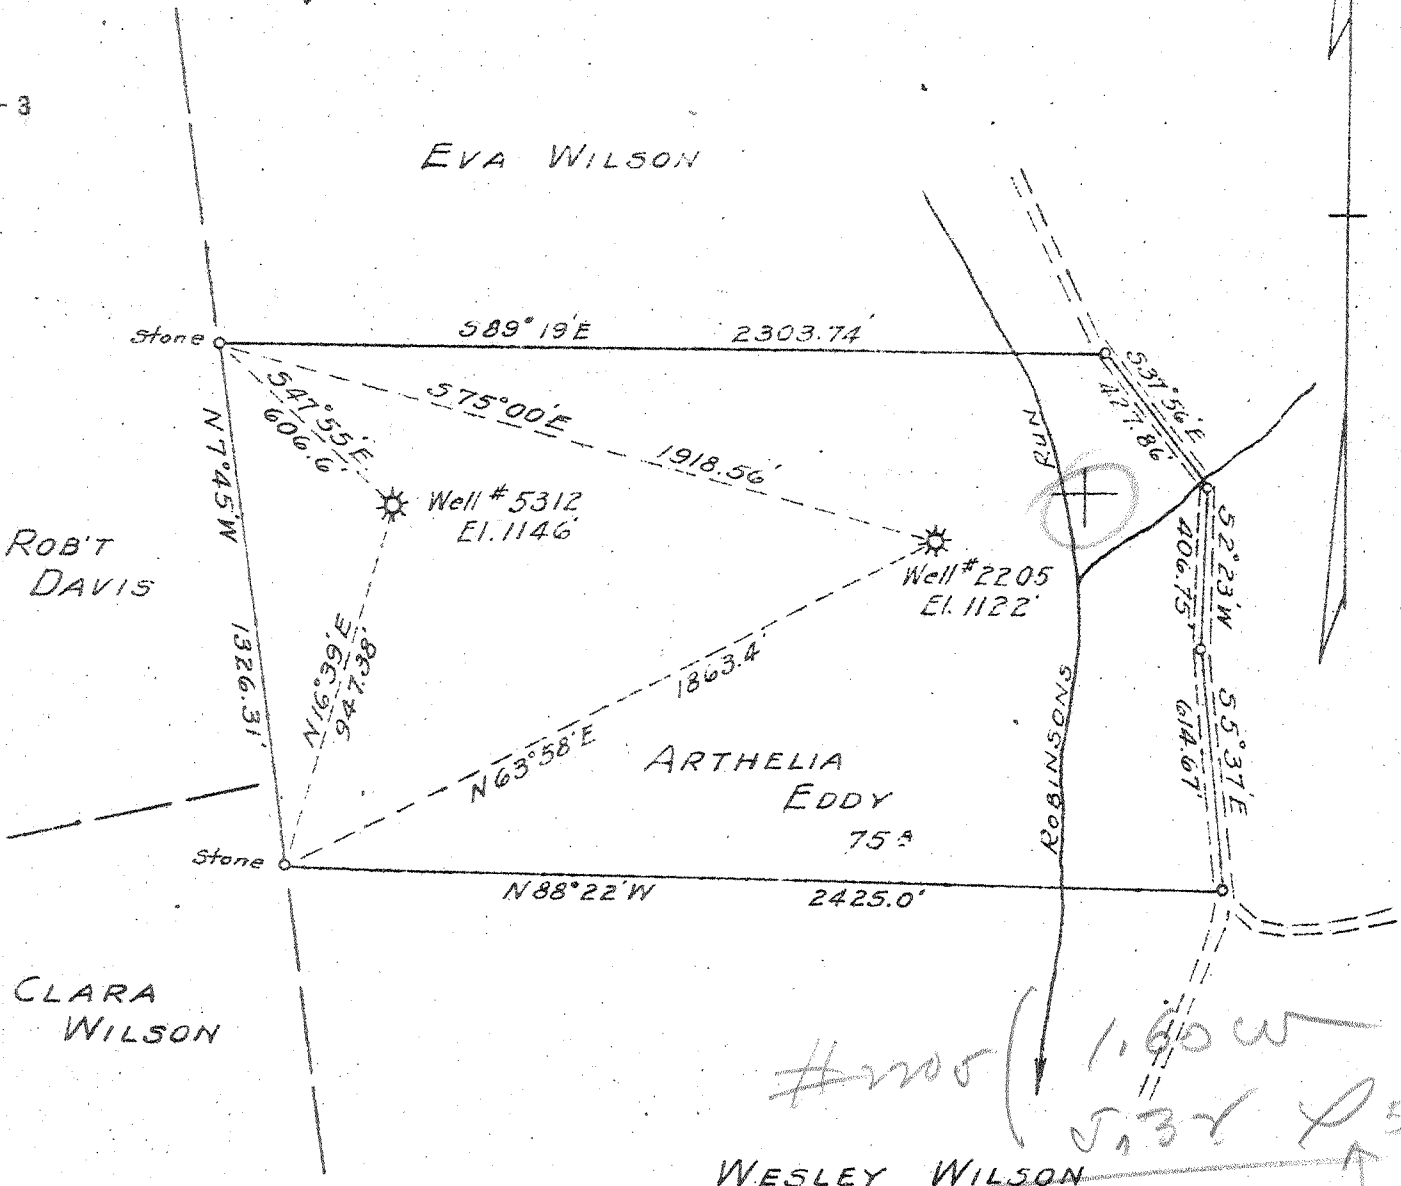

New Location
 Drill Deeper
 Abandonment 5312

OCT 14 1947

Map Sh. 16 Sq. N-10 E-23 F.B. 77A P. 23

Company HOPE NATURAL GAS CO.
 Address CLARKSBURG, W. VA.
 Farm ARTHELIA EDDY
 Tract _____ Acres 75 Lease No. 20651
 Well (Farm) No. _____ Serial No. AS SHOWN
 Elevation (Spirit Level) AS SHOWN
 Quadrangle BLACKSVILLE
 County MARION District PAW PAW
 Engineer Wm Powers
 Engineer's Registration No. 900
 File No. _____ Drawing No. _____
 Date 5-25-45 Scale 1" = 500'

STATE OF WEST VIRGINIA
 DEPARTMENT OF MINES
 OIL AND GAS DIVISION
 CHARLESTON

WELL LOCATION MAP

FILE NO. ~~MAR-420-A-#5312~~
 MAR-481-A-#2205

+ Denotes location of well on United States Topographic Maps, scale 1 to 62,500, latitude and longitude lines being represented by border lines as shown.

- Denotes one inch spaces on border line of original tracing.

ARTHELIA EDDY No. 5312 - HOPE N.G. Co. MAR-481A 2427



STATE OF WEST VIRGINIA
DEPARTMENT OF MINES
OIL AND GAS DIVISION

560

WELL RECORD

Permit No. 481-A ~~Oil~~ or Gas Well _____ (KIND)

Company Hope Natural Gas Company.
Address 445 West Main St. Clarksburg, W. Va.
Farm Arthelia Eddy Acres 75
Location (waters) _____
Well No. 2205 Elev. 1122
District Paw Paw County Marion
The surface of tract is owned in fee by _____
Address _____
Mineral rights are owned by _____
Address _____
Drilling commenced April 28, 1911
Drilling completed June 7, 1911
Date Shot _____ From _____ To _____
With _____
Open Flow _____ /10ths Water in _____ Inch
_____ /10ths Merc. in _____ Inch
Volume _____ Cu. Ft.
Rock Pressure _____ lbs. _____ hrs.
Oil _____ bbls., 1st 24 hrs.
Fresh water 58 feet _____ feet
Salt water 1366 feet _____ feet

Casing and Tubing	Used in Drilling	Left in Well	Packers
Size			
16			Kind of Packer _____
13			
10	480	480	Size of _____
8 1/4	1444	1444	
6 1/2	1703	1703	Depth set _____
5 3/16	1710	1710	
3			Perf. top _____
2			Perf. bottom _____
Liners Used			Perf. top _____
			Perf. bottom _____

CASING CEMENTED _____ SIZE _____ No. Ft. _____ Date _____

COAL WAS ENCOUNTERED AT 358 FEET 60 INCHES
441 FEET 96 INCHES FEET INCHES
FEET INCHES FEET INCHES

Formation	Color	Hard or Soft	Top	Bottom	Oil, Gas or Water	Depth Found	Remarks
Mapleton Coal			358	363	water	58	
Pittsburgh Coal			441	449			
Little Dunkard			810	830			
Big Dunkard			895	1008			
Gas sand			1080	1110			
First Salt			1255	1275			
Second Salt			1348	1445	water	1366	
Maxon			1350	1580			
Little Lime			1661	1671			
Pencil cave			1671	1677			
Big Lime			1677	1731			
Big Injun			1731	?	gas	1744 1755	
Berea			1978	2020			
Fifty foot			2289	2400			
Thirty foot			2432	2456	gas	2437	
Gordon			2630	2636			
Fourth			2632	2717			
Fifth			2811	2859	gas	2850	
Bayard			2926	2929			
Total depth				2942			

