

Pittsburgh Coal: The Union Trust Co. of Pittsburgh, Pa. Trustee.
 (Deed Book 126, p 85. Parcel # 304) Pittsburgh Pa.

Surface: V. Clark Hall. R.F.D # 4. Mannington. W.Va.

0.70S
 1.97W
 N 3 E 1A

New Location
 Drill Deeper
 Abandonment

Company Road Supply Co.
 Address Salem W.Va.
 Farm J.N. Hall
 Tract _____ Acres 81 Lease No. _____
 Well (Farm) No. 1 Serial No. _____
 Elevation (Spirit Level) Floor - 1480.61
Ground - 1478.51
 Quadrangle Clarksburg
 County Marion District Mannington
 Engineer E.C. Tobler
 Engineer's Registration No. _____
 File No. _____ Drawing No. _____
 Date Jan. 14th 1947 Scale 1" = 400'

STATE OF WEST VIRGINIA
 DEPARTMENT OF MINES
 OIL AND GAS DIVISION
 CHARLESTON

WELL LOCATION MAP
 FILE NO. MAR-486-A

+ Denotes location of well on United States Topographic Maps, scale 1 to 62,500, latitude and longitude lines being represented by border lines as shown.

- Denotes one inch spaces on border line of original tracing.



STATE OF WEST VIRGINIA
DEPARTMENT OF MINES
OIL AND GAS DIVISION

562

WELL RECORD

Permit No. 456-A

Oil or Gas Well (X)


Company Read Supply Company
Address 184 East Main St., Salem, W. Va.
Farm J. N. Hall Acres 81
Location (waters) _____
Well No. 1 Elev. 1478.51
District Marrington County Marion
The surface of tract is owned in fee by V. Clark Hall
R. F. D. #4 Address Marrington, W. Va.
Mineral rights are owned by The Union Trust Co., of
Pittsburgh, Pa. Trst Address Pittsburgh, Pa.
Drilling commenced _____
Drilling completed May 5, 1902
Date Shot _____ From _____ To _____
With _____

Casing and Tubing	Used in Drilling	Left in Well	Packers
Size			Kind of Packer
16			
18			Size of
10			
8 1/2			Depth set
6	2160'	2160'	
5 3/16	2242'	2242'	
3			Perf. top
2	2340'	2340'	Perf. bottom
Liners Used			Perf. top
			Perf. bottom

Open Flow _____ /10ths Water in _____ Inch
_____ /10ths Merc. in _____ Inch
Volume _____ Cu. Ft.
Rock Pressure _____ lbs. _____ hrs.
Oil _____ bbls., 1st 24 hrs.
Fresh water _____ feet _____ feet
Salt water _____ feet _____ feet

CASING CEMENTED No _____ SIZE _____ No. Ft. _____ Date _____
COAL WAS ENCOUNTERED AT 880 FEET 84 INCHES
_____ FEET _____ INCHES _____ FEET _____ INCHES
_____ FEET _____ INCHES _____ FEET _____ INCHES

Formation	Color	Hard or Soft	Top	Bottom	Oil, Gas or Water	Depth Found	Remarks
Well purchased by South Penn Natural Gas Co., from Hartman Oil Co.							
Pittsburgh Coal			880'	887'			
Big Injun Sand			2245				
1st Pay			2321	2330			
Total Depth				2340			
This is all the record we have on this well.							

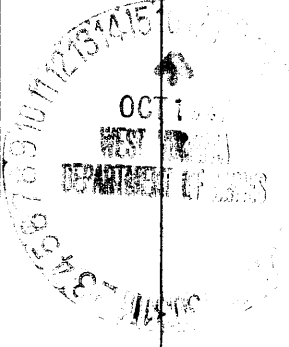

Formation	Color	Hard or Soft	Top	Bottom	Oil, Gas or Water	Depth Found	Remarks

Date October 7, 1947

APPROVED Raad Supply Company, Owner

By J. M. Raad - Manager, Owner
(Title)
S. M.