

Elevations: * B.F. Blackshere #25 { Floor - 974.55 ; Ground - 972.35 ; 47 B.F. Blackshere { 985.13 ; 983.03

Surface, Coal, Oil & Gas: Harry Blackshere, Mannington, W.Va. 3.7 W
 4.02 S
 3.64 W #47
 4.15 S
 3.57 W #25
 7.63 W
 MAY - 4 1948
 On 400' map # 2858. N 5 E 17

New Location
 Drill Deeper
 Abandonment

Company Road Supply Co.
 Address Salem, W.Va
 Farm B.F. Blackshere
 Tract Acres 465 1/2 Lease No. _____
 Well (Farm) No. 25 & 47 Serial No. _____
 Elevation (Spirit Level) See above
 Quadrangle MANNINGTON
 County Moxie District Mannington
 Engineer E.C. Tabler
 Engineer's Registration No. _____
 File No. _____ Drawing No. _____
 Date April 6th 1948 Scale 1" = 800 Feet

STATE OF WEST VIRGINIA
 DEPARTMENT OF MINES
 OIL AND GAS DIVISION
 CHARLESTON

WELL LOCATION MAP
 FILE NO. MAR-508-A-#47
MAR-509-A-#25

+ Denotes location of well on United States Topographic Maps, scale 1 to 62,500, latitude and longitude lines being represented by border lines as shown.

- Denotes one inch spaces on border line of original tracing.



STATE OF WEST VIRGINIA
DEPARTMENT OF MINES
OIL AND GAS DIVISION

602

WELL RECORD

Permit No. 509, A Oil or Gas Well X (KIND)


Company Raad Supply Company
Address 184 East Main St., Salem, W. Va.
Farm B. F. Blackshere Acres 465 1/2
Location (waters) Mahan's Run
Well No. 25 Elev. 972.35
District Mannington County Marion
The surface of tract is owned in fee by Mr. Harry Blackshere
Address Mannington, W. Va.
Mineral rights are owned by Harry Blackshere
Address Mannington, W. Va.

Casing and Tubing	Used in Drilling	Left in Well	Packers
Size			Kind of Packer
16			
13			
10	148'	148'	Size of
8 1/4	893'	893'	
6 5/8	1376'	1376'	Depth set
5 3/16	2275'	2275'	
3			Perf. top
2	2812'	2812'	Perf. bottom
Liners Used	4" x 4 1/2" =	346'	Perf. top
			Perf. bottom

Drilling commenced _____
Drilling completed October 24, 1895
Date Shot _____ From _____ To _____
With _____
Open Flow _____ /10ths Water in _____ Inch
_____ /10ths Merc. in _____ Inch
Volume _____ Cu. Ft.
Rock Pressure _____ lbs. _____ hrs.
Oil _____ bbls., 1st 24 hrs.
Fresh water _____ feet _____ feet
Salt water _____ feet _____ feet

CASING CEMENTED No SIZE _____ No. Ft. _____ Date _____
COAL WAS ENCOUNTERED AT 358 FEET ? INCHES
_____ FEET _____ INCHES FEET _____ INCHES
_____ FEET _____ INCHES FEET _____ INCHES

Formation	Color	Hard or Soft	Top	Bottom	Oil, Gas or Water	Depth Found	Remarks
Conductor				14'			
Pittsburgh	<u>Coal</u>		358'				
Dunkard			890	950			
Big Injun			1717'				
1st Pay			1803				
2nd Pay			1812				
Thirty Foot			2282	2325			
Gordon Stray			2425	2475			
Gordon			2593	2615			
Fourth			2615	2648			
Fifth			2772	2780			
Gas			2775	2777			
Total Depth				2812			

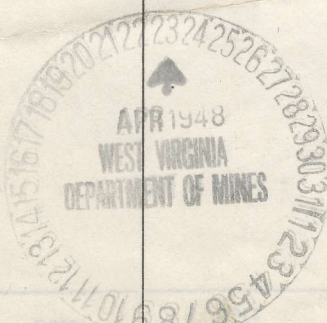

SEP 23 1948



ENGINEER'S CERTIFICATE

I, the undersigned, hereby certify that this map is correct and to the best of my knowledge and belief as to the oil and gas section of the mining laws of West Virginia.

[Handwritten Signature]

Witness me a Notary Public on the 6th day of February, 1931
 My office expires on the 30th day of March, 1932.

JOHN P. WHELAN, NOTARY PUBLIC