


Latitude 3, 35'

Longitude 80° 20'

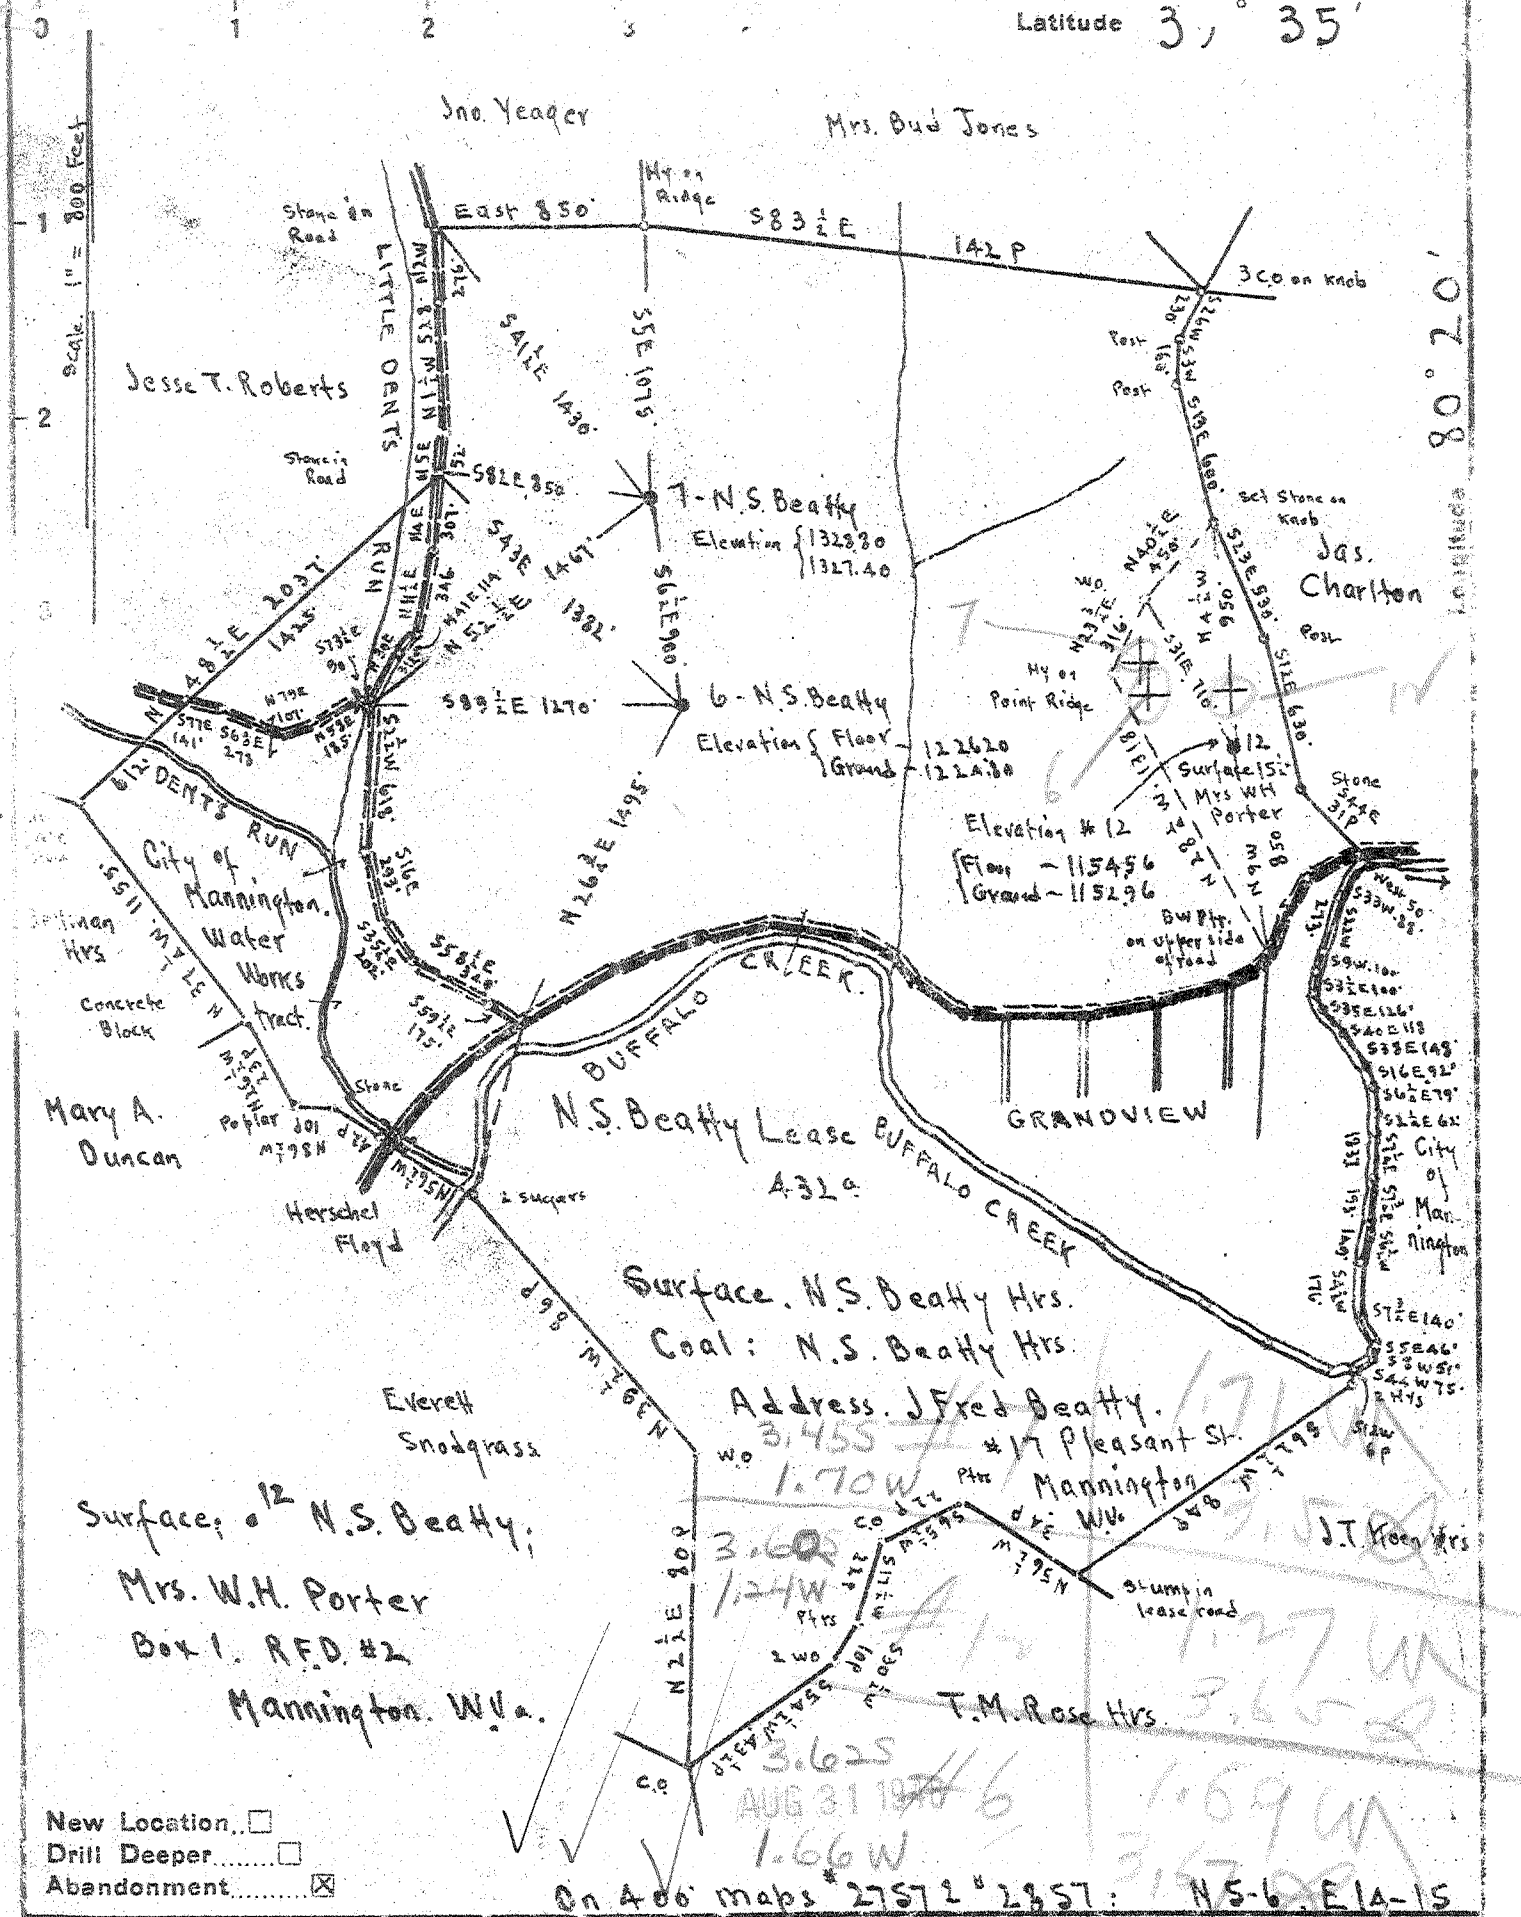

- New Location...
- Drill Deeper...
- Abandonment...

On A-00 maps 27572" 2857: N5-6-E1A-15

Company Road Supply Co.
 Address Salem W.Va.
 Farm N.S. Beatty
 Tract Acres 432 Lease No. _____
 Well (Farm) No. 6, 7, & 12 Serial No. _____
 Elevation (Spirit Level) See above at Wells
 Quadrangle MANNINGTON 30
 County Marion District Mannington
 Engineer E.C. Tabler
 Engineer's Registration No. _____
 File No. _____ Drawing No. _____
 Date April 5th 1948 Scale 1" = 800 Feet

STATE OF WEST VIRGINIA
 DEPARTMENT OF MINES
 OIL AND GAS DIVISION
 CHARLESTON

WELL LOCATION MAP
 FILE NO. MAR-530-A-#6
MAR-531-A-#7
MAR-532-A-#12

+ Denotes location of well on United States Topographic Maps, scale 1 to 62,500, latitude and longitude lines being represented by border lines as shown.

- Denotes one inch spaces on border line of original tracing.

N.S. BEATTY NOS. 6, 7, & 12 - ROAD SUPPLY CO. - MAR-530-1-2-A



STATE OF WEST VIRGINIA
DEPARTMENT OF MINES
OIL AND GAS DIVISION

1611

Permit No. 591-A

WELL RECORD

Oil or Gas Well _____ (KIND)

Company Read Supply Company
Address 184 East Main St., Salem, W. Va.
Farm N. S. Beatty Acres 432
Location (waters) Dents Run
Well No. 7 Elev. 1327.40
District Mannington County Marion
The surface of tract is owned in fee by N. S. Beatty Hrs.
Addr: J. Fred Beatty, 17 Pleasant St.,
Mannington, W. Va.
Mineral rights are owned by SAME AS FOR SURFACE.
Address _____

Drilling commenced _____
Drilling completed September 16, 1944
Date Shot _____ From _____ To _____
With _____
Open Flow _____ /10ths Water in _____ Inch
_____ /10ths Merc. in _____ Inch
Volume _____ Cu. Ft.
Rock Pressure _____ lbs. _____ hrs.
Oil _____ bbls., 1st 24 hrs.
Fresh water _____ feet _____ feet
Salt water _____ feet _____ feet

Casing and Tubing	Used in Drilling	Left in Well	Packers
Size			
16			Kind of Packer
13			
10	932'	932'	Size of
8 1/4	1380'	1380'	
6 1/2	2315'	2315'	Depth set
5 3/16	2814'	2814'	
3			Perf. top
2	3096'	3096'	Perf. bottom
Liners Used			Perf. top
			Perf. bottom

CASING CEMENTED No SIZE _____ No. Ft. _____ Date _____
COAL WAS ENCOUNTERED AT 862 FEET 96 INCHES
765 FEET 46 INCHES FEET INCHES
FEET INCHES FEET INCHES

Formation	Color	Hard or Soft	Top	Bottom	Oil, Gas or Water	Depth Found	Remarks
Conductor				16'			
Mapletown Coal			769'	765			
Pittsburgh Coal			854	862			
Dunkard			1422	1465			
Big Lime			2112	2195			
Pencil Cave			2095	2112			
Big Injun			219 5	2315			
Thirty Foot			2881	2904			
Gordon Stray Sand			3020	3060			
Gordon Sand			3070	3096			
1st Pay			3080				
Total Depth				3096			

