


Latitude $+39^{\circ} 35'$

Longitude $80^{\circ} 00'$

Scale 1" = 400 Feet

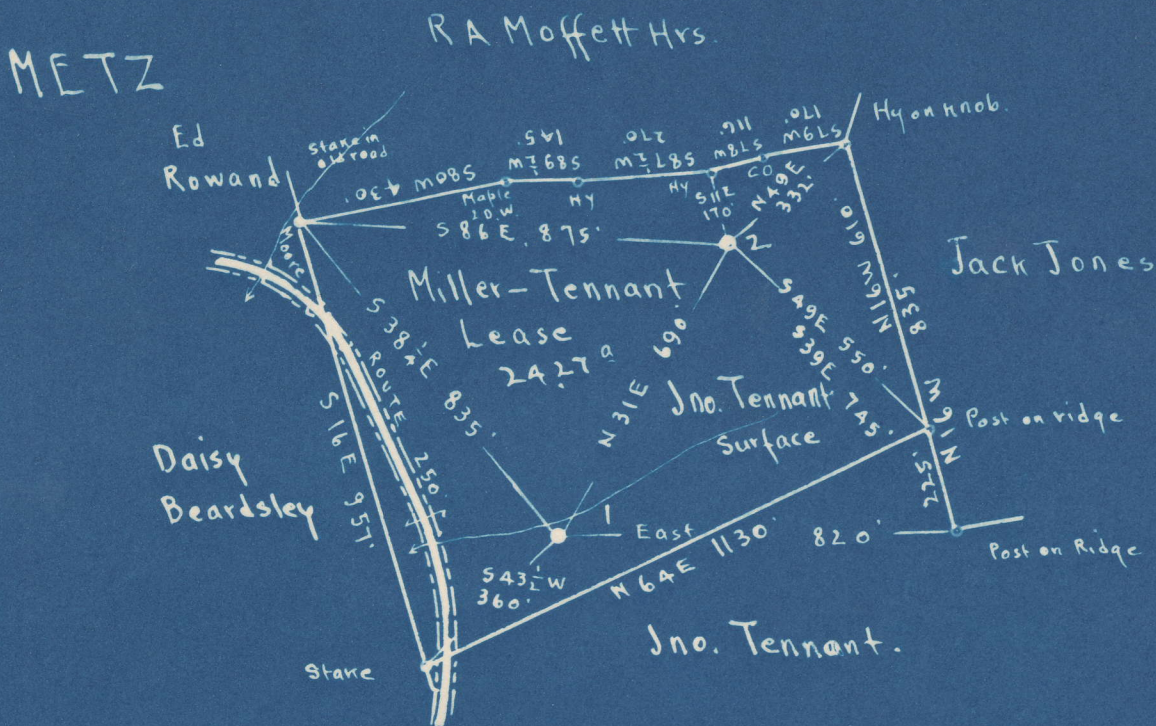

	0.33S
	1.58W
#1	0.34 S
	1.60 W
#2	0.28 S
	1.51 W

Surface: Jno. Tennant, Shinnston, W.Va. 0.28S
1.49W
 Coal: The Union Trust Co. of Pittsburgh, Pa. Trustee.

- New Location
- Drill Deeper
- Abandonment

On 400' map # 2657.

N 9 E 15

Company The Tri-State Pipe Co.
 Address Bellaire, Ohio
 Farm Miller-Tennant
 Tract Acres 2427 Lease No. SE
 Well (Farm) No. 1 & 2 Serial No. 1 Floor 1045.76 G. 1044.78
 Elevation (Spirit Level) 2 " 1283.34 G. 1281.34
 Quadrangle MANNINGTON SE
 County Marion District Mannington
 Engineer E.C. Tabler
 Engineer's Registration No. _____
 File No. _____ Drawing No. _____
 Date March 27th 1948 Scale 1" = 400 Feet

STATE OF WEST VIRGINIA
 DEPARTMENT OF MINES
 OIL AND GAS DIVISION
 CHARLESTON

WELL LOCATION MAP

FILE NO. MAR-574-A-#1
MAR-575-A-#2

+ Denotes location of well on United States Topographic Maps, scale 1 to 62,500, latitude and longitude lines being represented by border lines as shown.

- Denotes one inch spaces on border line of original tracing.

Mannington District, Marion County, W. Va.

By The Tri-State Pipe Co., Bellaire, Ohio.

Abandoned under permit Mar-.....-A7

On 24.27 acres.

Elevation, 1044.78' L.

Surface owned by John Tennant, Shinnston, W. Va., and minerals by

The Union Trust Co. of Pittsburgh, Pa., Trustee.

Drilling completed Sept. 5, 1925.

8 $\frac{1}{2}$ " casing, 1267'; 6 $\frac{3}{4}$ " , 2070'; 5 $\frac{1}{2}$ " , 2080'; 2" tubing, 2171'; all left in.

Casing not cemented.

Coal was encountered at 725-735'.

Oil well. Abandonment reported to Dept. of Mines Nov. 16, 1948.

Record to RCT from Mrs. Griffith Feb. 3, 1949. Old File No. 652.

	Top.	Bottom.
Conductor	0	16
Pittsburgh Coal	725	735
Little Dunkard Sand	1075	1110
Big Dunkard Sand	1244	1257
Salt Sand (water, 1490')	1400	1605
Little lime	1957	1962
Pencil Cave	1962	1967
Big lime	1967	2029
Big Injun Sand (water, 2034') (oil and water, 2150')	2029	2195
Total depth		2171' (2195')



STATE OF WEST VIRGINIA
DEPARTMENT OF MINES
OIL AND GAS DIVISION

652

WELL RECORD

Permit No. AB 574-A

Oil or Gas Well X
(KIND)


Company The Tri-State Pipe Co.,
Address Bellaire, Ohio
Farm Miller-Tennant Acres 24.27
Location (waters) _____
Well No. 1 Elev. 1044.78
District Mannington County Marion
The surface of tract is owned in fee by John Tennant
Address Shinnston, W. Va.
Mineral rights are owned by The Union Trust Co.,
of Pittsburgh, Pa. Address Trustee
Drilling commenced _____
Drilling completed September 5, 1925
Date Shot _____ From _____ To _____
With _____
Open Flow _____ /10ths Water in _____ Inch
_____ /10ths Merc. in _____ Inch
Volume _____ Cu. Ft.
Rock Pressure _____ lbs. _____ hrs.
Oil _____ bbls., 1st 24 hrs.
Fresh water _____ feet _____ feet
Salt water _____ feet _____ feet

Casing and Tubing	Used in Drilling	Left in Well	Packers
Size			Kind of Packer
16			
13			
10			Size of
8 1/4	1267'	1267'	Depth set
6 3/8	2070'	2070'	
5 3/16	2080'	2080'	Perf. top
3			Perf. bottom
2	2171'	2171'	Perf. top
Liners Used			Perf. bottom


CASING CEMENTED No _____ SIZE _____ No. Ft. _____ Date _____

COAL WAS ENCOUNTERED AT 735 FEET 120 INCHES
_____ FEET _____ INCHES FEET _____ INCHES
_____ FEET _____ INCHES FEET _____ INCHES

Formation	Color	Hard or Soft	Top	Bottom	Oil, Gas or Water	Depth Found	Remarks
Conductor				16			
Pittsburgh Coal			725	735			
Little Dunkard			1075	1110			
Big Dunkard			1244	1257			
Salt Sand			1400	1605			
Water			1490		Water		
Little Line			1957	1962			
Pencil Cave			1962	1967			
Big Line			1967	2029			
Big Injun			2029	2195			
Water			2034		Water		
Oil and water			2150		Oil & water		
Total Depth				2171			

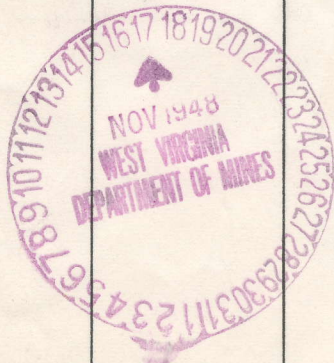

Formation	Color	Hard or Soft	Top	Bottom	Oil, Gas or Water	Depth Found	Remarks
			1720	1720			
			1730	1730			
			1740	1740			
			2300	2300			

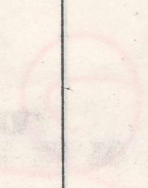

DEPARTMENT OF MINES
STATE OF WEST VIRGINIA

Date Nov 16, 1948

APPROVED Tri-State Pipe Co, Owner

By J. M. Rood, Contractor
Jm (Title)