

JOSEPH HANCOCK NO. 12 WELL.

592A

Hannington District, Marion County, W. Va.
 by The Tri-State Pipe Co., Bellaire, Ohio.

Abandoned under permit No.-17

On 250 acres, on Harrison Fork.

Elevation, 1157.17' L.

Surface owned by Ray Starkey, R. F. No. 1, Hannington, W. Va., and
 minerals by State of West Virginia.

Drilling completed Jan. 27, 1919.

10" casing, 365'; 8", 1507'; 6", 2133'; 2" tubing, 3215'; all left in.
 Casing not cemented.

Coal was encountered at 910-912 and 1008-1015'.

Oil well. Abandonment reported to Dept. of Mines Dec. 8, 1948.

Record to ROR from Mrs. Griffith Feb. 17, 1949. Old File No. 655.

	Top.	Bottom.
Conductor	0	15
Waylston (Sewickley) Coal	910	912
Pittsburgh Coal	1008	1015
Little Burkard Sand	1425	1450
Big Burkard Sand	1460	1475
Gas Sand	1580	1740
Gas Sand	1750	1794
Pencil Cove	2212	2218
Big Mine	2218	2236
Big Injun Sand	2306	2450
Fifty-foot Sand (gas, 2945')	2942	2992
Thirty-foot Sand	3023	3048
Stray Sand	3125	3175
Fourth Sand	3212	3215
Total depth		3215



655

STATE OF WEST VIRGINIA
DEPARTMENT OF MINES
OIL AND GAS DIVISION

WELL RECORD

Permit No. 59-A

Oil or Gas Well _____
(KIND)


Company The Tri-State Pipe Company
Address Bellaire, Ohio
Farm Joseph Hayhurst Acres 250
Location (waters) Warrior Fork
Well No. 12 Elev. 1187.17
District Mannington County Marion
The surface of tract is owned in fee by Ray Starkey
R. F. D. #1 Address Mannington, W. Va.
Mineral rights are owned by State of W. Va.
Address _____

Casing and Tubing	Used in Drilling	Left in Well	Packers
Size			Kind of Packer
16			
18			
10	385'	385'	Size of
8 1/4	1507'	1507'	
6 5/8	2150'	2150'	Depth set
5 3/16			
3			Perf. top
2	3215'	3215'	Perf. bottom
Liners Used			Perf. top
			Perf. bottom

Drilling commenced _____
Drilling completed January 27, 1919
Date Shot _____ From _____ To _____
With _____
Open Flow _____ /10ths Water in _____ Inch
_____ /10ths Merc. in _____ Inch
Volume _____ Cu. Ft.
Rock Pressure _____ lbs. _____ hrs.
Oil _____ bbls., 1st 24 hrs.
Fresh water _____ feet _____ feet
Salt water _____ feet _____ feet

CASING CEMENTED No SIZE _____ No. Ft. _____ Date _____
COAL WAS ENCOUNTERED AT 913 FEET 36 INCHES
1015 FEET 34 INCHES FEET INCHES
FEET INCHES FEET INCHES

Formation	Color	Hard or Soft	Top	Bottom	Oil, Gas or Water	Depth Found	Remarks
Conductor				15'			
Mapletown Coal			910	913			
Pittsburgh Coal			1008	1015			
Little Dunkard			1425	1450			
Big Dunkard			1480	1515			
Gas Sand			1680	1740			
Gas Sand			1750	1794			
Pencil Cave			2212	2218			
Big Lime			2218	2296			
Big Injun			2296	2450			
Fifty Foot			2942	2952			
Gas			2945				
Thirty Foot			3023	3043			
Stray Sand			3125	3175			
Fourth			3212	3215			
Total Depth				3215			

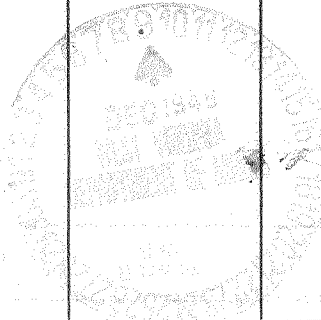

FEB 17 1919

