

| | | | |
|-------|---|------|-------|
| 664-A | S | 3.88 | 3.84S |
| #1 | W | 1.07 | 1.06W |
| 666-A | S | 3.89 | 3.84S |
| #2 | W | 0.89 | 0.87W |
| 667-A | S | 3.79 | 3.74S |
| #3 | W | 1.13 | 1.15W |

NOTE: Title to the surface of the Elias Wilson farm is now vested in Harry Miller, of Metz, W.Va., having been acquired by deed from Marion Meredith, Deputy Comm'r for Forfeited and Delinquent Lands, dated June 30, 1949, and recorded in the office of the Marion County Clerk, in Deed Book No. 477, at page 549.

Coal owned by the Little Kanawha Syndicate. Address - Charleston National Bank, Trustee, P.O. Box 368, Fairmont, W.Va.

New Location..
 Drill Deeper.....
 Abandonment.....

Company THE INTERSTATE PIPE & SUPPLY CO.
 Address 4th & Church Streets, Marietta, Ohio.
 Farm Elias Wilson
 Tract _____ Acres 48.5 Lease No. _____
 Well (Farm) No. 1, 2 and 3 Serial No. _____
 Elevation (Spirit Level) No. 1: 1130, No. 2: 1442, No. 3: 1326
 Quadrangle Mannington
 County Marion District Mannington
 Engineer M. S. Hoeltz
 Engineer's Registration No. 1227
 File No. _____ Drawing No. _____
 Date May, 1950 Scale 1" = 400'

STATE OF WEST VIRGINIA
 DEPARTMENT OF MINES
 OIL AND GAS DIVISION
 CHARLESTON

WELL LOCATION MAP
 MAR-664-A-1
 FILE NO. MAR-666-A-2
 MAR-667-A-3

+ Denotes location of well on United States Topographic Maps, scale 1 to 62,500, latitude and longitude lines being represented by border lines as shown.

- Denotes one inch spaces on border line of original tracing.

Nannington District, Marion County, W. Va.

By The Interstate Pipe & Supply Co., Box 548, Marietta, Ohio.

Abandoned under permit Mar-.....-A?

On 48.5 acres, on Messer Run.

Elevation, 1442' L.

Surface owned by Harry Miller, Nets, W. Va., and minerals by
Little Kanawha Syndicate, Charleston National Bank, Trustee,
Box 368, Fairmont, W. Va.

Drilling commenced Jan. 1, 1920; completed March 20, 1920.

Shot in 1920 and 1930.

10" casing, 286'; 8 1/2", 1718'; 6 1/2", 2400'; 5 1/2", 3180'; all left in.

Coal was encountered at 1125-1130 and 1238-1245'.

Oil and gas well. Record to Dept. of Mines dated May 29, 1950.

Record to RCT from Mrs. Griffith Nov. 18, 1950. Old File No. 763.

| | Top. | Bottom. |
|--------------------------------|------|---------|
| Sewickley Coal | 1125 | - 1130 |
| Pittsburgh Coal | 1238 | - 1245 |
| Little Dunkard Sand | 1640 | - 1670 |
| Big Dunkard Sand | 1715 | - 1795 |
| Gas Sand | 1815 | - 1885 |
| First Salt Sand | 1945 | - 1995 |
| Second Salt Sand | 2000 | - 2030 |
| Third Salt Sand (water, 2185') | 2140 | - 2224 |
| Maxton Sand | 2335 | - 2370 |
| Little Line | 2450 | - 2460 |
| Pencil Cove | 2460 | - 2465 |
| Big Line | 2465 | - 2514 |
| Big Injun Sand | 2514 | - 2681 |
| Fifty-foot Sand | 3162 | - 3228 |
| Thirty-foot Sand | 3252 | - 3272 |
| Gordon Stray Sand (gas, 3386') | 3385 | - |
| (oil, 3393') oil, 3398-3400') | | |
| Total depth | | 3406 |



STATE OF WEST VIRGINIA
DEPARTMENT OF MINES
OIL AND GAS DIVISION

763

Linsberg

WELL RECORD

Permit No. MAR-1066-A


Oil or Gas Well Oil & Gas
(KIND)

Company The Interstate Pipe & Supply Company
 Address P. O. Box 548, Marietta, Ohio
 Farm Elias Wilson Acres 48.5
 Location (waters) Messer Run
 Well No. 2 Elev. 1442
 District Mannington County Marion
 The surface of tract is owned in fee by Harry Miller
 Address Metz, W. Va.
 Mineral rights are owned by Little Kanawha Syndicate
Charleston Nat'l Bank, Trustee Address Fairmont, W. Va.
 Box 308
 Drilling commenced January 1, 1920
 Drilling completed March 20, 1920
 Date Shot 1920-1930 From _____ To _____
 With _____
 Open Flow _____ /10ths Water in _____ Inch
 _____ /10ths Merc. in _____ Inch
 Volume _____ Cu. Ft.
 Rock Pressure _____ lbs. _____ hrs.
 Oil _____ bbls., 1st 24 hrs.
 Fresh water _____ feet _____ feet
 Salt water _____ feet _____ feet

| Casing and Tubing | Used in Drilling | Left in Well | Packers |
|-------------------|------------------|--------------|----------------|
| Size | | | |
| 16 | | | Kind of Packer |
| 13 | | | |
| 10 | 286' | 286' | Size of |
| 8 1/4 | 1718' | 1718' | |
| 6 5/8 | 2480' | 2480' | Depth set |
| 5 3/16 | 3180' | 3180' | |
| 3 | | | Perf. top |
| 2 | | | Perf. bottom |
| Liners Used | | | Perf. top |
| | | | Perf. bottom |

CASING CEMENTED _____ SIZE _____ No. Ft. _____ Date _____
 COAL WAS ENCOUNTERED AT 1125 FEET 60 INCHES
1238' FEET 84 INCHES FEET INCHES
 FEET INCHES FEET INCHES

| Formation | Color | Hard or Soft | Top | Bottom | Oil, Gas or Water | Depth Found | Remarks |
|---------------------|-------|--------------|-------|--------|-------------------|-------------|---------|
| Native Coal | | | 1125 | 1130 | | | |
| Pittsburgh Coal | | | 1238' | 1245' | | | |
| Little Dunkard Sand | | | 1640 | 1670 | | | |
| Big Dunkard Sand | | | 1715 | 1795 | | | |
| Gas Sand | | | 1815 | 1885 | | | |
| First Salt Sand | | | 1945 | 1995 | | | |
| Second Salt Sand | | | 2000 | 2030 | | | |
| Third Salt Sand | | | 2140 | 2224 | | | |
| Water | | | 2185 | | | | |
| Maxon Sand | | | 2335 | 2370 | | | |
| Little Lime | | | 2450 | 2460 | | | |
| Pencil Cave | | | 2460 | 2465 | | | |
| Big Lime | | | 2465 | 2514 | | | |
| Big Injun Sand | | | 2514 | 2681 | | | |
| Fifty Foot Sand | | | 3162 | 3228 | | | |
| Thirty Foot Sand | | | 3252 | 3272 | | | |
| Gordon Stray Sand | | | 3385 | | | | |
| Gas | | | 3386 | | | | |
| Gordon Sand Oil | | | 3393 | | | | |
| 2'nd Oil | | | 3398 | 3400 | | | |
| Total Depth | | | | 3406 | | | |

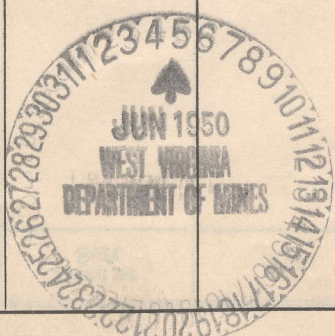

(Over) NOV 18 1950

