


Latitude

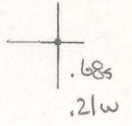

Longitude

Topo Location

7.5' Loc. _____ 15' Loc. _____
 _____ (calc.) _____

Company _____

Farm _____


15' Quad _____
(sec.)

7.5' Quad Shumston

District Lincoln

WELL LOCATION PLAT

County 049 Permit 30684

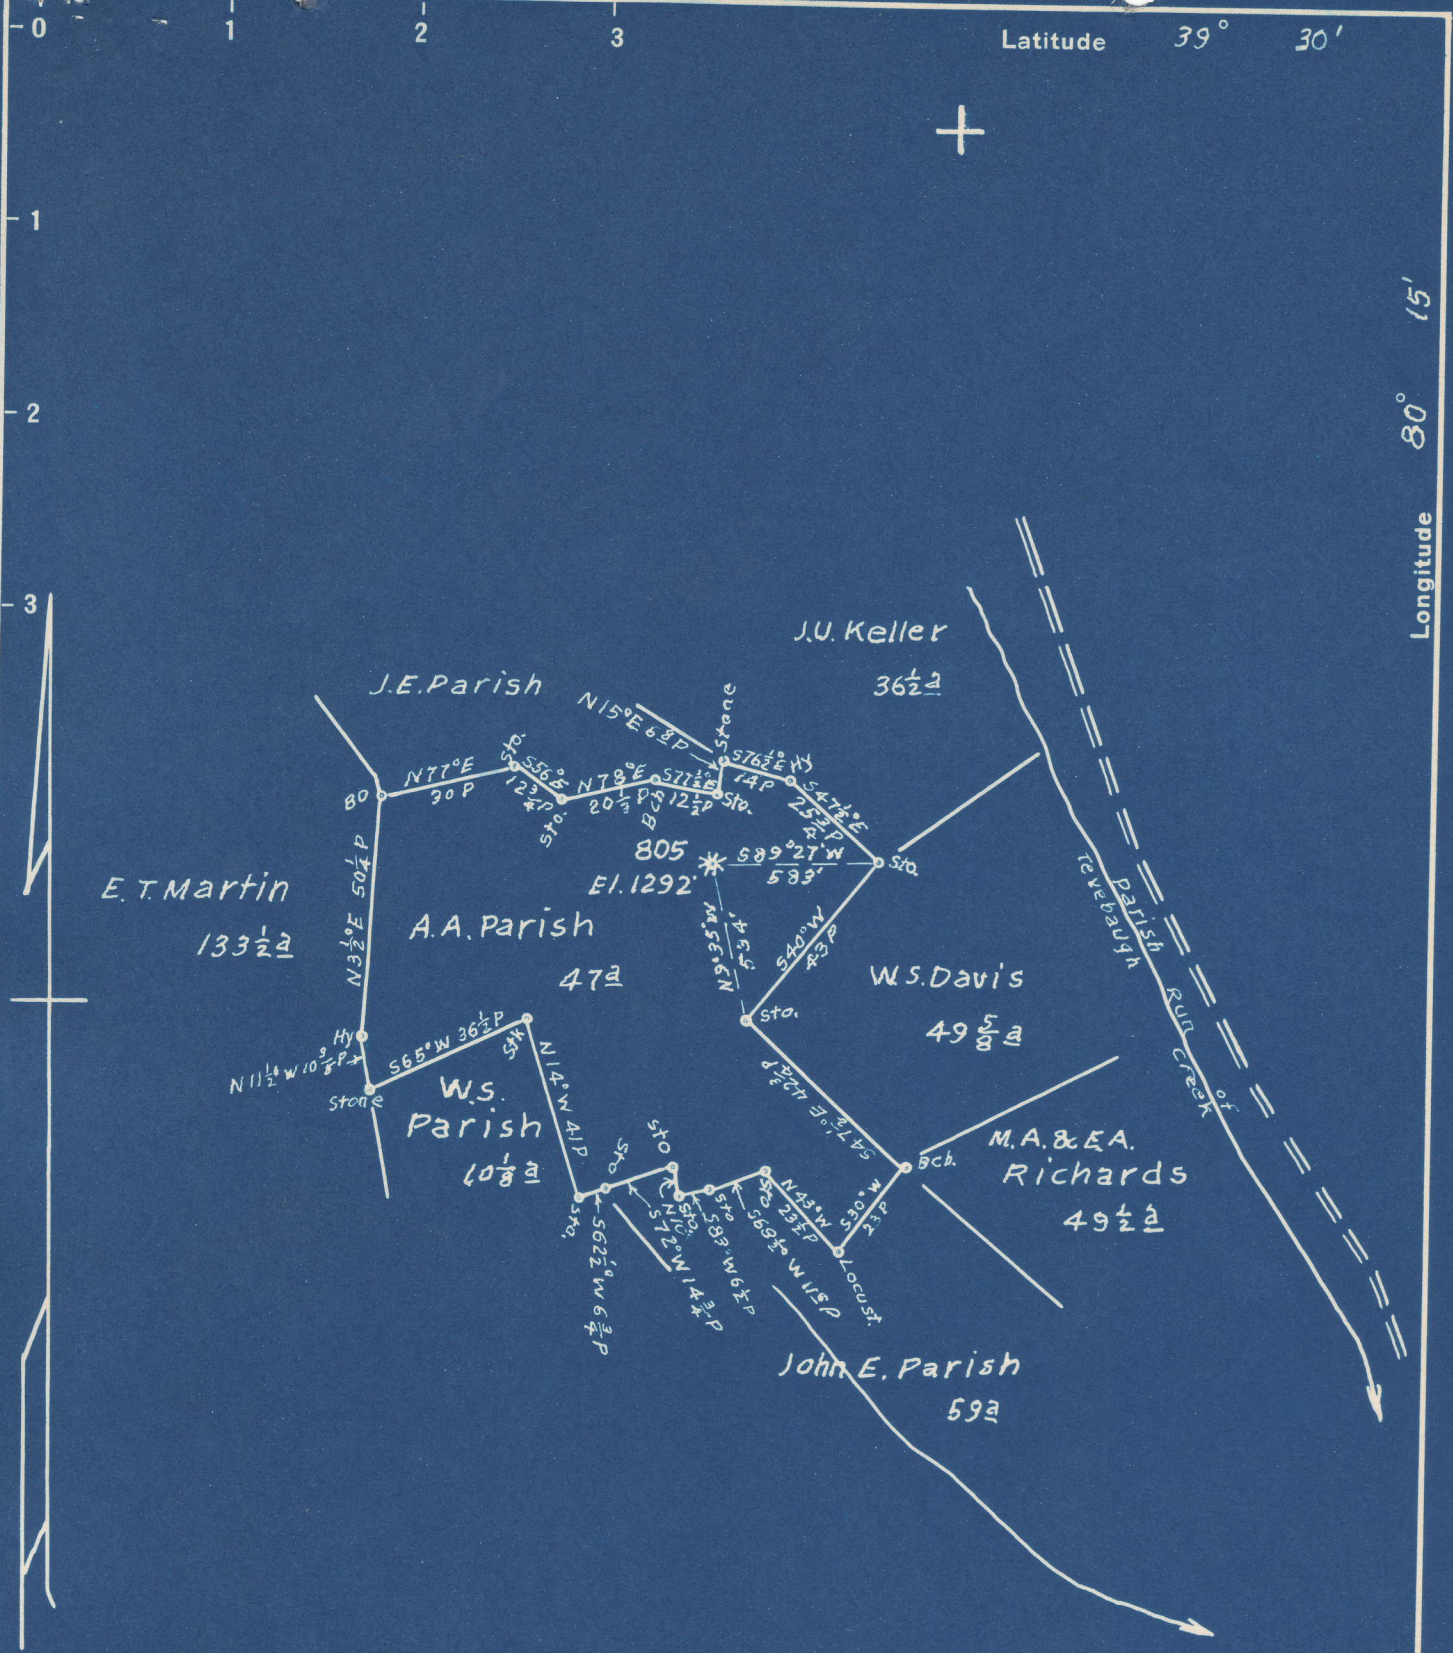

0.64 S
2.50 W

S 0.63
W 2.52

New Location
 Drill Deeper
 Abandonment

Map Sh 30 N 3 E 18 FB. 571 P 16-17 + 48

Company Hope Natural Gas Co.
 Address Clarksburg, W. Va.
 Farm A. A. Parish
 Tract _____ Acres 47 Lease No. 4972
 Well (Farm) No. _____ Serial No. 805
 Elevation (Spirit Level) 1292'
 Quadrangle Clarksburg
 County Marion District Lincoln
 Engineer W.M. Bowers
 Engineer's Registration No. 900 NE
 File No. _____ Drawing No. _____
 Date 10-31-50 Scale 1"=40P

STATE OF WEST VIRGINIA
 DEPARTMENT OF MINES
 OIL AND GAS DIVISION
 CHARLESTON

WELL LOCATION MAP
 FILE NO. MAR-684-A

+ Denotes location of well on United States Topographic Maps, scale 1 to 62,500, latitude and longitude lines being represented by border lines as shown.
 - Denotes one inch spaces on border line of original tracing.



STATE OF WEST VIRGINIA
DEPARTMENT OF MINES
OIL AND GAS DIVISION

767

#635 MMT Co Rip

Ab 684A

WELL RECORD

Permit No. _____ Oil or Gas Well _____ (KIND)

Company Hope Natural Gas Company
Address 445 West Main St., Clarksburg, W.Va.
Farm A. A. Parish Acres 47
Location (waters) _____
Well No. 805 Elev. _____
District Mannington County Marion 1292
The surface of tract is owned in fee by Glen Parish
Address R.1, Farmington, W.Va.
Mineral rights are owned by Consolidation Coal Co.
Address Fairmont, W.Va.
Drilling commenced Dec. 9, 1905
Drilling completed Mar. 28, 1906
Date Shot 8-22-11 From 2994 To 3001 1/2
With 15-Qts.
Open Flow _____ /10ths Water in _____ Inch
_____ /10ths Merc. in _____ Inch
Volume _____ Cu. Ft.
Rock Pressure _____ lbs. _____ hrs.
Oil None _____ bbls., 1st 24 hrs.
Fresh water None rec. _____ feet _____ feet
Salt water " _____ feet _____ feet

Casing and Tubing	Used in Drilling	Left in Well	Packers
Size			Kind of Packer
16			
13			
10	519	0	Size of
8 1/4	1628	1628	
6 5/8	1950	1950	Depth set
5 3/16	2865	2865	
3			Perf. top
2	3070	3070	Perf. bottom
Liners Used			Perf. top
			Perf. bottom

CASING CEMENTED not SIZE _____ No. Ft. _____ Date _____
COAL WAS ENCOUNTERED AT 600 FEET 96 INCHES
_____ FEET _____ INCHES _____ FEET _____ INCHES
_____ FEET _____ INCHES _____ FEET _____ INCHES

Formation	Color	Hard or Soft	Top	Bottom	Oil, Gas or Water	Depth Found	Remarks
Pgh. Coal			600	608			
Dunkard			1000	1240			
Salt Sand			1515	1675			
INJUN			1971	2105	Gas	2062	
FIFTY FOOT			2520	2600	Gas	2528	
Stray			2795	2830			
Gordon			2836	2850			
Fourth			2875	2890			
FIFTH			2993	3005	Gas	2995-3001	
			Total Depth	3055			

