

New Location
 Drill Deed
 Abandonment 3556

Map Sh 16 NB E 20 FB 336 P 20


| | |
|------------------|----------------------|
| Company | Hope Natural Gas Co. |
| Address | Clarksburg, W.Va. |
| Farm | O.L. Smith |
| Tract | Acres 109 |
| Lease No. | 61858 |
| Well / Lease No. | As Shown |

STATE OF WEST VIRGINIA
 DEPARTMENT OF MINES
 OIL AND GAS DIVISION
 CHARLESTON

WELL LOCATION MAP

39° 35' 00"

LATITUDE 39 35

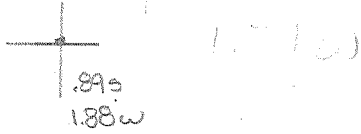

80° 05' 00"

LONGITUDE 80 05

7'5 OGIS topo location

| | |
|----------------|---------------|
| 7.5' loc _____ | 15' loc _____ |
| _____ | (calc.) _____ |

Company _____ 9556

Farm O.L. SMITH

Quad RIVESVILLE

County MORGAN

District POW POW

WELL LOCATION MAP

File No. 30710

Priggen District, Marion County, W. Va.

By Hope Natural Gas Co., 445 W. Main St., Clarksburg, W. Va.

Abandoned under permit Mar-.....-A?

On 100 acres.

Elevation, 1187' L.

Drilling commenced June 30, 1910; completed Nov. 27, 1910.

No water recorded.

10",.....? (pulled); 8",.....? (pulled); 6", 1823'; 2" tubing, 1845'.

Casing not cemented.

Coal was encountered at 371-376 and 470-477'.

Gas well. Record to Dept. of Mines dated April 10, 1951.

Record to NST from Mrs. Griffith June 28, 1951. Old File No. 796.

| | Top. | Bottom. |
|-----------------------------|--------|---------|
| Mapletown (Sewickley) Coal | 371 - | 376 |
| Pittsburgh Coal | 470 - | 477 |
| Salt Sand | 1364 - | 1457 |
| Big Lime | 1735 - | 1823 |
| Big Injun Sand (gas, 1910') | 1823 - | 1956 |
| Gantz Sand | 2320 - | 2395 |
| Fifty-foot Sand | 2400 - | 2442 |
| Fifth Sand | 2844 - | 2891 |
| Total depth | | 3045 |



STATE OF WEST VIRGINIA
DEPARTMENT OF MINES
OIL AND GAS DIVISION

1916

WELL RECORD

Permit No. MAR-710-A

Oil or Gas Well _____
(KIND)

Company Hope Natural Gas Company.
Address 445 West Main St., Clarksburg, W. Va.
Farm O.L. Smith Acres 100
Location (waters) _____
Well No. 9556 M.P. 280 Elev. 1187
District Paw Paw County Marion
The surface of tract is owned in fee by _____
Address _____
Mineral rights are owned by _____
Address _____
Drilling commenced June 30, 1910
Drilling completed November 27, 1910
Date Shot _____ From _____ To _____
With _____
Open Flow _____ /10ths Water in _____ Inch
_____ /10ths Merc. in _____ Inch
Volume _____ Cu. Ft.
Rock Pressure _____ lbs. _____ hrs.
Oil _____ bbls., 1st 24 hrs.
Fresh water none recorded feet _____ feet
Salt water none recorded feet _____ feet

| Casing and Tubing | Used in Drilling | Left in Well | Packers |
|-------------------|------------------|--------------|----------------|
| Size | | | Kind of Packer |
| 16 | | | |
| 13 | | | |
| 10 | ?? | Pulled | Size of |
| 8 1/4 | ?? | Pulled | |
| 6 5/8 | 1823 | 1823 | Depth set |
| 5 3/16 | | | |
| 3 | | | Perf. top |
| 2 | 1845 | 1845 | Perf. bottom |
| Liners Used | | | Perf. top |
| | | | Perf. bottom |

CASING CEMENTED _____ SIZE _____ No. Ft. _____ Date _____

COAL WAS ENCOUNTERED AT 371 FEET 60 INCHES
470 FEET 84 INCHES FEET INCHES
FEET INCHES FEET INCHES

| Formation | Color | Hard or Soft | Top | Bottom | Oil, Gas or Water | Depth Found | Remarks |
|-----------------|-------|--------------|------|--------|-------------------|-------------|---------|
| Maplewood Coal | | | 371 | 376 | (C) | | |
| Pittsburgh Coal | | | 470 | 477 | | | |
| Salt sand | | | 1364 | 1457 | | | |
| Big Lime | | | 1735 | 1823 | | | |
| Big Injun | | | 1823 | 1956 | gas | 1910 | |
| Gantz | | | 2320 | 2395 | | | |
| Fifty foot | | | 2400 | 2442 | | | |
| Fifth | | | 2844 | 2891 | | | |
| Total depth | | | | 3045 | | | |

