

Surface owned by B.F. Huey.
 Address: Mr. B.F. Huey, 110. Monroe St. Mannington, W. Va.
 Coal owned by The Charleston National Bank, Trustee.
 Address: Bernard G. Sampson, Ingr. P.O. Box No. 368, Fairmont, W. Va.

- New Location
- Drill Deeper
- Abandonment


On 800' Map N50E, Sq. N4E14.

Company Road Supply Co.
 Address Salem, W. Va.
 Farm J. W. Conaway
 Tract _____ Acres 98 Lease No. _____
 Well (Farm) No. 4 Serial No. _____

STATE OF WEST VIRGINIA
 DEPARTMENT OF MINES
 OIL AND GAS DIVISION
 CHARLESTON
 WELL LOCATION MAP

LATITUDE 39 32 30

LONGITUDE 88 20

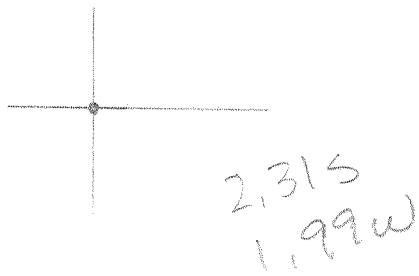

7'5 OGIS topo location

7.5' loc _____ 15' loc _____
 (calc.) _____

Company _____

Farm J W CONAWAY 4

Quad MANNINGTON

County MIRROUN

District MANNINGTON

WELL LOCATION MAP

File No. 30711

171-8

Hannington District, Marion County, W. Va.
 By Road Supply Co., 184 N. Main St., Salem, W. Va.
 Abandoned under permit No.-----A?
 On 99 acres.
 Elevation,⁺ l.
 Drilling completed Aug. 25, 1894.
 10" casing, 590'; 8", 1365'; 6", 2105'; 5", 2296'; 2" tubing,
 3057'; 4" x 4" liner, 680'; all left in.
 Casing not cemented.
 Coal was encountered at 725-729 and 823-833'.
 Oil well. Record to Dept. of Mines stamped June 28, 1951.
 Record to RCT from Mrs. Griffith June 28, 1951. Old File No. 890.

	Top.	Bottom.
Mapletown (Sewickley) Coal	725	- 729
Pittsburgh Coal	823	- 833
Danhard Sand	1255	- 1400
Big Lime	2085	- 2180
Big Injun Sand (water, 2280')	2180	- 2335
Fifty-foot Sand (gas, 2780')	2775	- 2825
Thirty-foot Sand	2865	- 2895
Gordon Sand (1st pay, 3038'; 2nd pay, 3046')	3027	-
Total depth		3057



STATE OF WEST VIRGINIA
DEPARTMENT OF MINES
OIL AND GAS DIVISION

190

WELL RECORD

Permit No. MAR-711-A

Oil or Gas Well _____
(KIND)


Company Reed Supply Company
Address 184 East Main St., Salem, W. Va.
Farm J. W. Conaway Acres 99
Location (waters) _____
Well No. 4 Elev. _____
District Mannington County Marion
The surface of tract is owned in fee by _____
Address _____
Mineral rights are owned by _____
Address _____
Drilling commenced _____
Drilling completed August 25, 1894
Date Shot _____ From _____ To _____
With _____
Open Flow _____ /10ths Water in _____ Inch
_____ /10ths Merc. in _____ Inch
Volume _____ Cu. Ft.
Rock Pressure _____ lbs. _____ hrs.
Oil _____ bbls., 1st 24 hrs.
Fresh water _____ feet _____ feet
Salt water _____ feet _____ feet

Casing and Tubing	Used in Drilling	Left in Well	Packers
Size			
16			Kind of Packer
18			
10	590'	590'	Size of
8 1/2	1365'	1365'	
6 5/8	2105'	2105'	Depth set
5 3/16	2296'	2296'	
3			Perf. top
2	3057'	3057'	Perf. bottom
Liners Used			Perf. top
4 1/2" x 4"	688'	688'	Perf. bottom

CASING CEMENTED no SIZE _____ No. Ft. _____ Date _____

COAL WAS ENCOUNTERED AT 729 FEET 48 INCHES
933 FEET 120 INCHES FEET INCHES
FEET INCHES FEET INCHES

Formation	Color	Hard or Soft	Top	Bottom	Oil, Gas or Water	Depth Found	Remarks
Mapletown Coal			725	729			
Pittsburgh Coal			823	833			
Dunkard Sand			1355	1400			
Big Lime			2085	2180			
Big Injun Sand			2180	2335			
Water			2280		Water		
Fifty Foot Sand			2775	2825			
Gas			2780		Gas		
Thirty Foot Sand			2865	2895			
Gordon Sand			3027				
1st Pay			3038				
2nd Pay			3046				
Total Depth				3057			

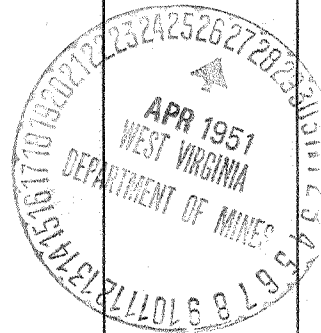

JUN 28 1951