

New Location   
 Drill Deeper   
 Abandonment


Map 56.27 N 7 E 22 FB 1009 P 4-5

Company Hope Natural Gas Co  
 Address Clarksburg, W.Va.  
 Farm John Veach  
 Tract \_\_\_\_\_ Acres 117 Lease No. 61810

STATE OF WEST VIRGINIA  
 DEPARTMENT OF MINES  
 OIL AND GAS DIVISION  
 CHARLESTON

LATITUDE 39 35

LONGITUDE 86 12 30

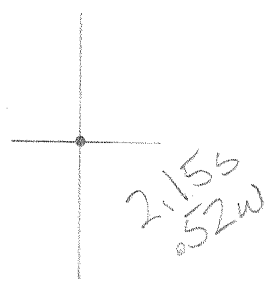

7'5 OGIS topo location

7.5' loc \_\_\_\_\_ 15' loc \_\_\_\_\_  
 (calc.) \_\_\_\_\_

Company \_\_\_\_\_ 9504

Farm JOHN VEATCH

Quad GRANT TOWN

County MARION

District LINCOLN

WELL LOCATION MAP

File No. 36717

Lincoln District, Marion County, W. Va.  
 By Hope Natural Gas Co., 445 W. Main St., Clarksburg, W. Va.  
 Abandoned under permit Mar-.....-A?  
 On 117 acres.

Elevation, 1224' E.

Drilling commenced June 14, 1916; completed Aug. 27, 1916.

No water recorded.

10" casing, 635'; 8 1/2" , 1406'; 6 3/4" , 1880'; 5 1/2" , 2800'; 2" tubing, 3031';  
 all left in.

10" casing cemented, 635', in 1916.

Coal was encountered at 480-487 and 585-593'.

Gas well. Record to Dept. of Mines dated May 8, 1951.

Record to RCF from Mrs. Griffith Aug. 17, 1951. Old File No. 806.

	Top.	Bottom.
Mapletown (Sewickley) Coal	480	- 487
Pittsburgh Coal	585	- 593
Little Dunkard Sand	1100	- 1155
Gas Sand (gas, 1290')	1280	- 1366
Second Salt Sand	1526	- 1610
Maxton Sand	1730	- 1770
Little Line	1840	- 1870
Pencil Cove	1870	- 1880
Big Line	1880	- 1935
Big Injun Sand (gas, 1985')	1935	- 2075
Gantz Sand (gas, 2462')	2450	- 2501
Fifty-foot Sand	2520	- 2565
Thirty-foot Sand	2588	- 2664
Gordon Stray Sand	2797	- 2807
Gordon Sand	2845	- 2861
Fourth Sand	2892	- 2914
Fifth Sand (gas, 2990')	2985	- 3002
Total depth		3101



STATE OF WEST VIRGINIA  
DEPARTMENT OF MINES  
OIL AND GAS DIVISION

806

WELL RECORD

Permit No. MAR-717-A

~~Oil~~ Gas Well (KIND)


Company Hope Natural Gas Company.  
 Address 445 West Main St., Clarksburg, W. Va.  
 Farm John Veach Acres 117  
 Location (waters) \_\_\_\_\_  
 Well No. 9504 M.P. 74 Elev. 1284  
 District Lincoln County Marion  
 The surface of tract is owned in fee by \_\_\_\_\_  
 Address \_\_\_\_\_  
 Mineral rights are owned by \_\_\_\_\_  
 Address \_\_\_\_\_  
 Drilling commenced June 14, 1916  
 Drilling completed Aug. 27, 1916  
 Date Shot \_\_\_\_\_ From \_\_\_\_\_ To \_\_\_\_\_  
 With \_\_\_\_\_  
 Open Flow \_\_\_\_\_ /10ths Water in \_\_\_\_\_ Inch  
 \_\_\_\_\_ /10ths Merc. in \_\_\_\_\_ Inch  
 Volume \_\_\_\_\_ Cu. Ft.  
 Rock Pressure \_\_\_\_\_ lbs. \_\_\_\_\_ hrs.  
 Oil \_\_\_\_\_ bbls., 1st 24 hrs.  
 Fresh water none recorded feet \_\_\_\_\_ feet  
 Salt water none recorded feet \_\_\_\_\_ feet

Casing and Tubing	Used in Drilling	Left in Well	Packers
Size			
16			Kind of Packer
13			
10	635	635	Size of
8 3/4	1406	660	
6 3/8	1880	1880	Depth set
5 3/16	2800	2800	
3			Perf. top
2	3031	3031	Perf. bottom
Liners Used			Perf. top
			Perf. bottom

CASING CEMENTED 10" SIZE 635 No. Ft. 1916 Date

COAL WAS ENCOUNTERED AT 480 FEET 84 INCHES  
585 FEET 96 INCHES FEET INCHES  
 FEET INCHES FEET INCHES

Formation	Color	Hard or Soft	Top	Bottom	Oil, Gas or Water	Depth Found	Remarks
Mapletwon coal			480	487			
Pittsburgh Coal			585	593			
Little Dunkard			1100	1155			
Gas sand			1280	1366	gas	1290	
First Salt							
Second Salt			1526	1610			
Maxon			1730	1770			
Little Lime			1840	1870			
Pencil cave			1870	1880			
Big Lime			1880	1935			
Big Injun			1935	2075	gas	1985	
Ganta			2450	2501	gas	2462	
Fifty foot			2520	2565			
Thirty foot			2588	2664			
Gordon stray			2797	2807			
Gordon			2845	2861			
Fourth			2892	2914			
Fifth			2985	3002	gas	2990	
Total depth				3101			

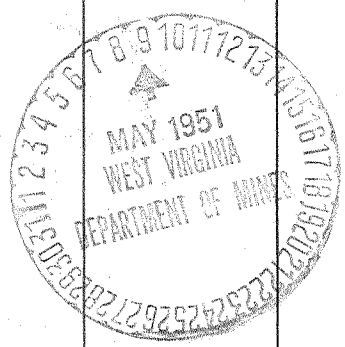

(Over) AUG 17 1951

Formation	Color	Hard or Soft	Top	Bottom	Oil, Gas or Water	Depth Found	Remarks

Date May 8, 1951, 19

APPROVED Hope Natural Gas Company, Owner

By J. H. Tolleson

(Type Name)  
