

New Location   
 Drill Desper   
 Abandonment


Sh 27 88 E 22 P 10 W P 18

Company	HOPE NATURAL GAS CO.		
Address	CLARKSBURG, W VA		
Farm	O.L. WILSON		
Tract	Acres	Lease No.	4129
Well (Farm) No.		Serial No.	2035

STATE OF WEST VIRGINIA  
 DEPARTMENT OF MINES  
 OIL AND GAS DIVISION  
 CHARLESTON

WELL LOCATION MAP

LATITUDE 39 35

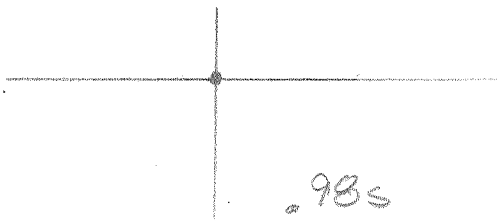

LONGITUDE 80 12 30

7'5 OGIS topo location

7.5' loc \_\_\_\_\_ 15' loc \_\_\_\_\_  
 (calc.) \_\_\_\_\_

Company 7035

Farm O L WILSON

Quad GRANT TOWN

County MARION

District MANNINGTON

WELL LOCATION MAP

File No. 30738

Haynes District, Marion County, W. Va.  
 By Hope Natural Gas Co., 445 W. Main St., Clarksburg, W. Va.  
 Abandoned under permit No. ....-A1  
 On 148 acres.

Elevation, 1420' L.

Drilling commenced May 3, 1911; completed June 20, 1911.

Fresh water at 180'.

Salt water at 1625'.

10" casing, 985' (pulled); 8" ", 1650' (pulled); 6" ", 1981'; 2" tubing, 2121'.

Casing not cemented.

Coal was encountered at 280-284, 550-556, and 650-657'.

Gas well. Record to Dept. of Mines dated July 25, 1951.

Record to 807 from Mrs. Griffith Nov. 28, 1951. Old file No. 822.

	Top.	Bottom.
(water, 180')		
Coal	280 -	284
Mapleton (Newickley) Coal	550 -	556
Pittsburgh Coal	650 -	657
Little Buckard Sand	1000 -	1040
Big Buckard Sand	1152 -	1235
Gas Sand	1350 -	1430
First Salt Sand	1465 -	1555
Second Salt Sand (water, 1625')	1585 -	1650
Little Lias	1890 -	1905
Pencil Cove	1905 -	1912
Big Lias	1912 -	1993
Big Lajun Sand (gas, 2090')	1993 -	2122
Sugar Sand	2130 -	2160
Fifty-foot Sand	2528 -	2625
Thirty-foot Sand (gas, 2665')	2660 -	2676
Gordon Stray Sand	2838 -	2852
Gordon Sand	2861 -	2864
Marth Sand	2880 -	2910
Fifth Sand (gas, 3035')	3032 -	3063
Total depth		3215
Filled back to		2121



STATE OF WEST VIRGINIA  
DEPARTMENT OF MINES  
OIL AND GAS DIVISION

*827*

Permit No. MAR-738-A

WELL RECORD

~~Oil~~ Gas Well (KIND)

Company Hope Natural Gas Company  
Address 445 West Main St. Clarksburg, W. Va.  
Farm O.L. Wilson Acres 148  
Location (waters) \_\_\_\_\_  
Well No. 2035 Elev. 1420  
District Paw Paw County Marion  
The surface of tract is owned in fee by \_\_\_\_\_  
Address \_\_\_\_\_  
Mineral rights are owned by \_\_\_\_\_  
Address \_\_\_\_\_  
Drilling commenced May 3, 1911  
Drilling completed June 20, 1911  
Date Shot \_\_\_\_\_ From \_\_\_\_\_ To \_\_\_\_\_  
With \_\_\_\_\_  
Open Flow \_\_\_\_\_ /10ths Water in \_\_\_\_\_ Inch  
\_\_\_\_\_ /10ths Merc. in \_\_\_\_\_ Inch  
Volume \_\_\_\_\_ Cu. Ft.  
Rock Pressure \_\_\_\_\_ lbs. \_\_\_\_\_ hrs.  
Oil \_\_\_\_\_ bbls., 1st 24 hrs.  
Fresh water 180 feet \_\_\_\_\_ feet  
Salt water 1625 feet \_\_\_\_\_ feet

Casing and Tubing	Used in Drilling	Left in Well	Packers
Size			Kind of Packer
16			
13			
10	985	Pulled	Size of
8 1/4	1650	Pulled	
6 5/8	1981	1981	Depth set
5 3/16			
3			Perf. top
2	2121	2121	Perf. bottom
Liners Used			Perf. top
			Perf. bottom

CASING CEMENTED not SIZE \_\_\_\_\_ No. Ft. \_\_\_\_\_ Date \_\_\_\_\_

COAL WAS ENCOUNTERED AT 280 FEET 48 INCHES  
550 FEET 72 INCHES 650 FEET 84 INCHES  
\_\_\_\_\_ FEET \_\_\_\_\_ INCHES \_\_\_\_\_ FEET \_\_\_\_\_ INCHES

Formation	Color	Hard or Soft	Top	Bottom	Oil, Gas or Water	Depth Found	Remarks
Coal			280	284	water	180	
Mapletown coal			550	556			
Pittsburgh Coal			650	657			
Little Dubkard			1000	1040			
Big Dunkard			1152	1235			
Gas sand			1350	1430			
First Salt			1465	1555			
Second Salt			1585	1650	water	1625	
Little Lime			1890	1905			
Pencil cave			1905	1912			
Big Lime			1912	1993			
Big Injun			1993	2122	gas	2090	
Squaw			2130	2160			
Fifty foot			2528	2625			
Thirty foot			2560	2676	gas	2665	
Gordon stray			2838	2852			
Gordon			2861	2864			
Fourth			2880	2910			
Fifth			3032	3063	gas	3035	
Total depth				3214			
Filled back to				2121			

