


LATITUDE 39 32 30

LONGITUDE 80 20

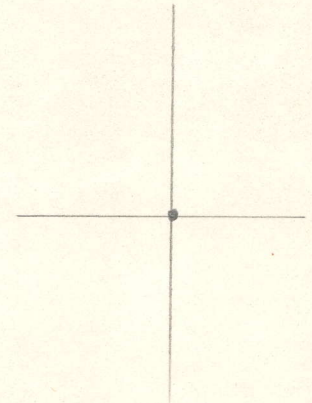

1.36s
8 37W

7'5 OGIS topo location

7.5' loc _____ 15' loc _____
 _____ (calc.) _____

Company _____

Farm WATSON - McGRAW 5


Quad MANNINGTON

County MARION

District MANNINGTON

WELL LOCATION MAP

File No. 30741

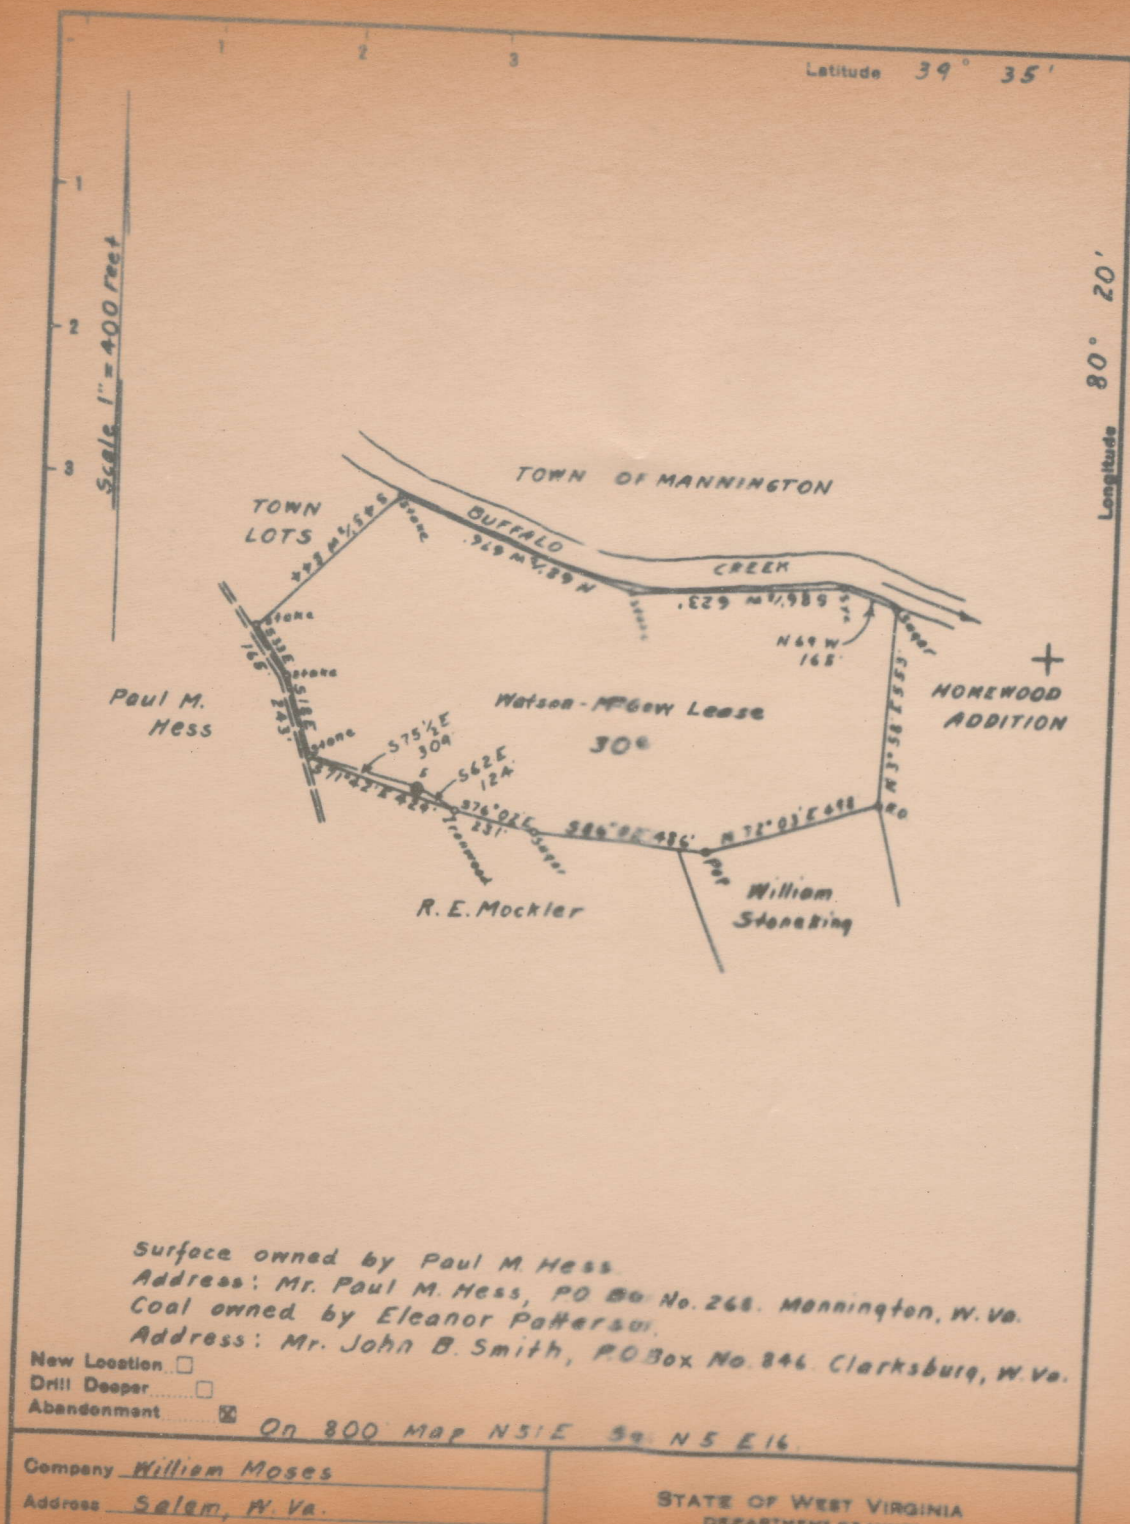



STATE OF WEST VIRGINIA
DEPARTMENT OF MINES
OIL AND GAS DIVISION

WELL RECORD

Permit No. Ma-741

Oil or Gas Well _____

Company	<u>Wm. Oses</u>	Casing and Tubing	Used in Drilling	Left in Well	Packers
Address	<u>Salem, W. Va.</u>	Size			Kind of Pack
Farm	<u>Watson McGraw</u> Acres	18			
Location (waters)		12			Size of
Well No.	<u>Five</u> Elev.	10		<u>1125</u>	
District	<u>Lannington County</u> <u>Marion</u>	8 1/4		<u>1859</u>	Depth set
The surface of tract is owned in fee by	Address	8		<u>1867</u>	Perf. top
Mineral rights are owned by	Address	2			Perf. bottom
Drilling commenced					Perf. top
Drilling completed	<u>1890</u>				Perf. bottom
Date Shot	From _____ To _____				Perf. top
With					Perf. bottom
Open Flow	/10ths Water in _____ Inch				
	/10ths Merc. in _____ Inch				
Volume	_____ Cu. Ft.				
Rock Pressure	_____ lbs. _____ hrs.				
Oil	_____ bbls., 1st 24 hrs.				
Fresh water	_____ feet _____ feet				
Salt water	_____ feet _____ feet				

CASING CEMENTED _____ SIZE _____ No. Ft. _____ Date _____

COAL WAS ENCOUNTERED AT 760 FEET 60 INCHES
 _____ FEET _____ INCHES FEET _____ INCHES
 _____ FEET _____ INCHES FEET _____ INCHES

Formation	Color	Hard or Soft	Top	Bottom	Oil, Gas or Water	Depth Found	Remarks
Pgh Coal			760	765			
Injun			1910				
Total Depth				2000			
This all the record that could be found.							

STATE OF WEST VIRGINIA
DEPARTMENT OF MINES
OIL AND GAS DIVISION

AFFIDAVIT OF PLUGGING AND FILLING WELL

AFFIDAVIT SHOULD BE MADE IN TRIPPLICATE. ONE COPY MAILED TO THE DEPARTMENT, ONE COPY TO BE RETAINED BY THE WELL OPERATOR AND THE THIRD COPY (AND EXTRA COPIES IF REQUIRED) SHOULD BE MAILED TO EACH COAL OPERATOR AT THEIR RESPECTIVE ADDRESSES.

Coal Operator or Owner: Charles Patterson
 Address: Ch. W. Watson

Name of Well Operator: W. H. Moore
 Complete Address: Seabrook, W. Va.

Well and Location: Aug 20 1957
Mannington District
Marion County

Well No. Fair
Watson - M^{rs} Kraw Farm

State Inspector Supervising Plugging: O. W. Luebeck

AFFIDAVIT

STATE OF WEST VIRGINIA.

County of Harrison } SS:

Ch. W. Watson and Geo. Moore
 being first duly sworn according to law depose and say that they are experienced in the work of plugging and filling oil and gas wells and were employed by W. H. Moore well operator, and participated in the work of plugging and filling the above well, that said work was commenced on the 27 day of Oct, 1957, and that the well was plugged and filled in the following manner:

BAND OR ZONE RECORD FORMATION	FILLING MATERIAL		PLUGS USED SIZE & KIND	CASING	
	CONTENT	FROM TO		CSG PULLED	CSG LEFT IN FOOT
Clay		744 1890		1867	3"
Concretion		1890 1880			
Clay		1880 1150		1500	5 3/8"
Concretion		1150 1140			
Clay		1140 795		700	8 1/4"
Concretion		795 740			
Clay		740 surface		125	10"
COAL BEANS			DESCRIPTION OF MONUMENT		
(NAME)	<u>Coal</u>	<u>795 740</u>	<u>erected Marker</u>		
(NAME)					
(NAME)					