

NOTE: - Well drilled by the Hope Natural Gas Co., operated by that company as Well No. 1908

- New Location
- Ditch Decoper
- Abandonment


The surface of the above tract is owned by Dr. W. C. Koon, whose post office address is Route No. 1, Fairmont, W. Va. Coal owned by the Pittsburgh Consolidation Coal Co., Fairmont, West Va. Part of Mine No. 63 territory. Well is Consolidation No. 412.

Company: VALLEY STEEL PRODUCTS CO.
 Address: St. Louis, Mo.
 Farm: W. C. Koon
 Tract: _____ Acres: 120 Lease No. _____

STATE OF WEST VIRGINIA
 DEPARTMENT OF MINES
 OIL AND GAS DIVISION
 CHARLESTON

LATITUDE 39 30

LONGITUDE 80 12 30

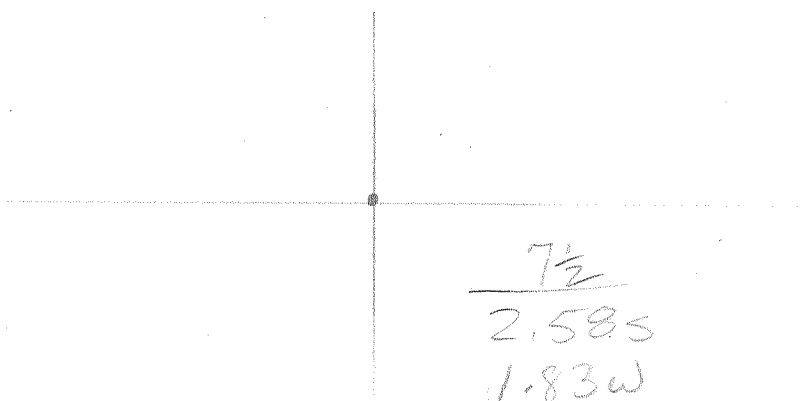

7'5 OGIS topo location

7.5' loc _____ 15' loc _____
 _____ (calc.) _____

662 or Co Repl map

Company HOPE 1908 CONSOR 412

Farm W C KOON 1

Quad FAIRMONT WEST

County MARION

District LINCOLN

WELL LOCATION MAP

File No. 30747

W. C. KOON NO. 1 WELL.
(Consolidation No. 412).
(Hope N. G. Co. No. 1908).

Lincoln District, Marion County, W. Va.
By Valley Steel Products Co., St. Louis, Mo.
Abandoned under permit Mar-.....-A?
On 120 acres, off Route No. 19.

Elevation, 1177' L.

Surface owned by Dr. W. C. Koon, R.F.D.No.1, Fairmont, W. Va.

Drilling commenced Aug. 8, 1910; completed Oct. 13, 1910.

10" casing, 359'; 8 $\frac{1}{2}$ " , 1253'; 6 $\frac{3}{4}$ " , 1691'; 4" line pipe, 243'; all left in.

Gas well. Record to Dept. of Mines stamped Sept. 12, 1951.

Record to RCT from Mrs. Griffith July 9, 1952. O. P. No. 840.

	Top.	Bottom.
Sewickley Coal	200	- 209
Pittsburgh Coal	321	- 329
Big Dunkard Sand	820	- 860
First Salt Sand	1128	- 1465
Pencil Cave	1625	- 1635
Big Lime	1635	- 1692
Big Injun Sand	1692	- 1721
Total depth		1721



STATE OF WEST VIRGINIA
DEPARTMENT OF MINES
OIL AND GAS DIVISION

82/0

Formerly Hope Natural Gas
Well No. 1908

WELL RECORD

Permit No. MAR-747-A

Oil or Gas Well _____
(KIND)

Company Valley Steel Products Company
 Address St. Louis, Mo.
 Farm W. C. Koon Acres 150
 Location (waters) off Route No. 19
 Well No. 1 (Consolidation #412) Elev. 1177'
 District Lincoln County Marion
 The surface of tract is owned in fee by Dr. W. C. Koon
RFD #1 - Fairmont Address W. Va.
 Mineral rights are owned by _____
 Address _____
 Drilling commenced 8/8/1910
 Drilling completed 10/13/1910
 Date Shot _____ From _____ To _____
 With _____
 Open Flow _____ /10ths Water in _____ Inch
 _____ /10ths Merc. in _____ Inch
 Volume _____ Cu. Ft.
 Rock Pressure _____ lbs. _____ hrs.
 Oil _____ bbls., 1st 24 hrs.
 Fresh water _____ feet _____ feet
 Salt water _____ feet _____ feet

Casing and Tubing	Used in Drilling	Left in Well	Packers
Size			
16			Kind of Packer
13			
10	350	350	Size of
8 1/4	1258	1258	
6 5/8	1691	1691	Depth set
5 3/16			
3	243' of 4" line pipe		Perf. top
2			Perf. bottom
Liners Used			Perf. top
			Perf. bottom

CASING CEMENTED _____ SIZE _____ No. Ft. _____ Date _____
 COAL WAS ENCOUNTERED AT _____ FEET _____ INCHES
 _____ FEET _____ INCHES FEET _____ INCHES
 _____ FEET _____ INCHES FEET _____ INCHES

Formation	Color	Hard or Soft	Top	Bottom	Oil, Gas or Water	Depth Found	Remarks
Bittling Coal		<i>Seamless</i>	300	300			
Bittling		<i>coal</i>	321	329			
Big Dunkard			323	360			
First Salt Sand			1128	1493			
Pencil Cove			1626	1635			
Big Line			1636	1692			
Big Injun			1692	1721			
Total Depth				1721			

