




LATITUDE 39 35

LONGITUDE 80 10

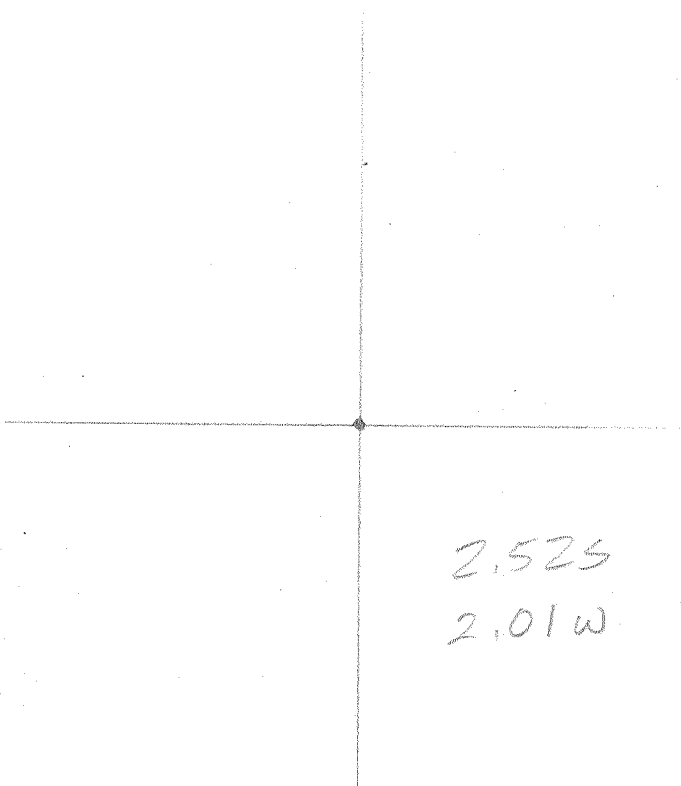

7'5 OGIS topo location

7.5' loc \_\_\_\_\_ 15' loc \_\_\_\_\_  
 (calc.) \_\_\_\_\_

Company \_\_\_\_\_ 41

Farm BLANCH AMOS 1

Quad GRANT TOWN

County MARION

District LINCOLN

WELL LOCATION MAP

File No. 30777

Lincoln District, Marion County, W. Va.  
 By Lewis Illinois Glass Co., Box 4158, Charleston, W. Va.  
 Abandoned under permit No. ....-47  
 (A).....acres.  
 Elevation, .....<sup>1</sup> ft.  
 Drilling commenced Nov. 6, 1922; completed Dec. 20, 1922.  
 Volume, 475,000 cu. ft.  
 Rock pressure, 175 lbs. in 24 hrs.  
 Water, 85'. Water, 101', 10 MIN. Water, 1480', 3 MIN.  
 Gas, 1900-1911'.  
 Conductor, 16'; 10" casing, 500'; 8", 1140'; 7" o. n., 1791';  
 2" tubing, 1914'; all left in.  
 Gas anchor packer, 6" x 2 x 16, set at 1770'.  
 Gas well. Record to Dept. of Mines stamped Aug. 14, 1952.  
 Record to RST from Mrs. Griffith Dec. 10, 1952. G.F.No.856.

	Top.	Bottom.
Sandstone (Waynesburg) Coal	50	85
Keokuk (Savinsloy) Coal	265	371
Pittsburgh Coal	480	487
Little Buckard Sand	990	1030
Big Buckard Sand	1080	1120
Gas Sand	1135	1185
First Salt Sand	1305	1310
2nd Salt Sand	1350	1480
Big lime	1755	1815
Big Injan Sand	1815	1911
Total depth		1911



756

STATE OF WEST VIRGINIA  
DEPARTMENT OF MINES  
OIL AND GAS DIVISION

WELL RECORD

Permit No. MAR-777-A

Oil or Gas Well \_\_\_\_\_  
(KIND)

Company Owens Illinois Glass Company  
 Address Box 1158 - Charleston, W. Va.  
 Farm 1, Serial 01 /A1 Acres \_\_\_\_\_  
 (Almond Area)  
 Location (waters) \_\_\_\_\_  
 Well No. 1, Serial 01 /A1 Elev. \_\_\_\_\_  
 District Lincoln County Marion  
 The surface of tract is owned in fee by \_\_\_\_\_  
 Address \_\_\_\_\_  
 Mineral rights are owned by \_\_\_\_\_  
 Address \_\_\_\_\_  
 Drilling commenced November 6, 1922  
 Drilling completed December 30, 1922  
 Date Shot From \_\_\_\_\_ To \_\_\_\_\_  
 With \_\_\_\_\_  
 Open Flow /10ths Water in \_\_\_\_\_ Inch  
 /10ths Merc. in \_\_\_\_\_ Inch  
 Volume 175,000 Cu. Ft.  
 Rock Pressure 1750 lbs. 24 hrs.  
 Oil \_\_\_\_\_ bbls., 1st 24 hrs.  
 Fresh water \_\_\_\_\_ feet \_\_\_\_\_ feet  
 Salt water \_\_\_\_\_ feet \_\_\_\_\_ feet

Casing and Tubing	Used in Drilling	Left in Well	Packers
Size			Kind of Packer
16			
13 Conductor		14'	Gas Anchor
10	500'	500'	Size of
8 1/2	1110'	1110'	6-5/8"x2"x16"
6 3/8 7"OD	1701'	1701'	Depth set 1770'
5 3/16			
3			Perf. top
2	1911'	1911'	Perf. bottom
Liners Used			Perf. top
			Perf. bottom

CASING CEMENTED \_\_\_\_\_ SIZE \_\_\_\_\_ No. Ft. \_\_\_\_\_ Date \_\_\_\_\_  
 COAL WAS ENCOUNTERED AT \_\_\_\_\_ FEET \_\_\_\_\_ INCHES  
 \_\_\_\_\_ FEET \_\_\_\_\_ INCHES FEET \_\_\_\_\_ INCHES  
 \_\_\_\_\_ FEET \_\_\_\_\_ INCHES FEET \_\_\_\_\_ INCHES

Formation	Color	Hard or Soft	Top	Bottom	Oil, Gas or Water	Depth Found	Remarks
Sand stone	Coal		30	65	Water 85'		
Napierstown	Coal		365	371	Water 101'	- 10 BPH	
Pittsburg	Coal		430	437			
Little Duckard	Sand		590	1090			
Big Duckard	Sand		1090	1120			
Gas sand			1135	1135			
First salt	sand		1305	1330			
2nd salt	sand		1350	1400	Water 1400'	- 3 BPH	
Big lime			1755	1815			
Hujan sand			1815	1911	Gas 1900'-1911'		
Total Depth				1911			

