


- New Location
- Drill Deeper
- Abandonment

Company WILHELM & JACKSON  
 Address HAMLIN, W. VA.  
 Farm A. F. WILLIAMS  
 Tract Acres 22 & Lease No. \_\_\_\_\_  
 Well (Farm) No. 1 Serial No. 42

STATE OF WEST VIRGINIA  
 DEPARTMENT OF MINES  
 OIL AND GAS DIVISION  
 CHARLESTON

**WELL LOCATION MAP**

LATITUDE 39 35

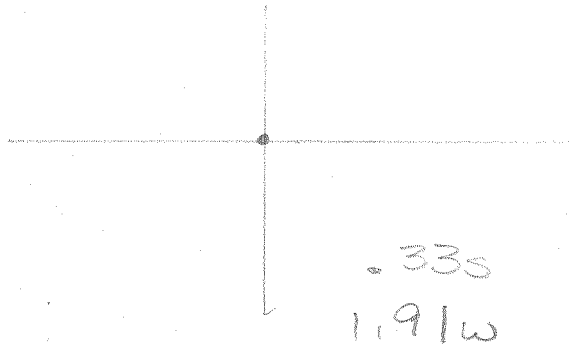

LONGITUDE 80 05

7'5 OGIS topo location

7.5' loc \_\_\_\_\_ 15' loc \_\_\_\_\_  
 \_\_\_\_\_ (calc.) \_\_\_\_\_

Company \_\_\_\_\_ 42 \_\_\_\_\_

Farm A F Williams 1

Quad RIVESVILLE

County MARION (MOW)

District POW POW (GRANT)

WELL LOCATION MAP

File No. 30778

A. F. WILLIAMS NO. 1 (42) WELL.

Powpow District, Marion County, W. Va.

By Owens Illinois Glass Co., Box 4158, Charleston, W. Va.

Abandoned under permit Mar-.....-47

On ..... acres.

Elevation, .....' l.

Drilling commenced Dec. 7, 1922; completed Jan. 24, 1923.

Volume, 550,000 cu. ft.

Rock pressure, 205 lbs. in 24 hrs.

Gas, 1350', 103 N. Gas, 1944-1995'. Gas, 2015-2022'.

Water, 1550', hole full.

13" conductor, 14'; 8" casing, 606'; 7" C. B., 1420'; 5" casing, 1863';  
all left in.

Gas well. Record to Dept. of Mines stamped Aug. 14, Sept. 2, 1952.

Record to BCT from Mrs. Griffith Dec. 2, 1952. C.F.No.855.

	Top.	Bottom.
Mapletown (Sewickley) Coal	450	- 455
Pittsburgh Coal	550	- 551
Little Dunkard Sand	920	- 935
Gas Sand	1210	- 1300
Gas Sand	1320	- 1355
Salt Sand	1475	- 1575
Little Lime	1800	- 1807
Big Lime	1812	- 1898
Big Injun Sand	1898	- 2020
Total depth		2023



STATE OF WEST VIRGINIA  
DEPARTMENT OF MINES  
OIL AND GAS DIVISION

9200

WELL RECORD

Permit No. MAR-778-A

Oil or Gas Well \_\_\_\_\_  
(KIND)

Company Owens Illinois Glass Company  
 Address P. O. Box 1153 - Charleston, W. Va.  
 Farm A. F. Williams Acres \_\_\_\_\_  
 Location (waters) \_\_\_\_\_  
 Well No. 1, Serial 01-42 Elev. \_\_\_\_\_  
 District Put Tab County Marion  
 The surface of tract is owned in fee by \_\_\_\_\_  
 Address \_\_\_\_\_  
 Mineral rights are owned by \_\_\_\_\_  
 Address \_\_\_\_\_  
 Drilling commenced December 7, 1922  
 Drilling completed January 24, 1923  
 Date Shot \_\_\_\_\_ From \_\_\_\_\_ To \_\_\_\_\_  
 With \_\_\_\_\_  
 Open Flow \_\_\_\_\_ /10ths Water in \_\_\_\_\_ Inch  
 \_\_\_\_\_ /10ths Merc. in \_\_\_\_\_ Inch  
 Volume 550,000 Cu. Ft.  
 Rock Pressure 2950 lbs. 24 hrs.  
 Oil \_\_\_\_\_ bbls., 1st 24 hrs.  
 Fresh water \_\_\_\_\_ feet \_\_\_\_\_ feet  
 Salt water \_\_\_\_\_ feet \_\_\_\_\_ feet

Casing and Tubing	Used in Drilling	Left in Well	Packers
Size			
16			Kind of Packer _____
13 <u>Conductor</u>		<u>14'</u>	
10			Size of _____
8 1/4	<u>626'</u>	<u>626'</u>	
6 5/8 <u>7"OD</u>	<u>1120'</u>	<u>1120'</u>	Depth set _____
5 3/16	<u>1861'</u>	<u>1861'</u>	
3			Perf. top _____
2			Perf. bottom _____
Liners Used			Perf. top _____
			Perf. bottom _____

CASING CEMENTED \_\_\_\_\_ SIZE \_\_\_\_\_ No. Ft. \_\_\_\_\_ Date \_\_\_\_\_

COAL WAS ENCOUNTERED AT \_\_\_\_\_ FEET \_\_\_\_\_ INCHES  
 \_\_\_\_\_ FEET \_\_\_\_\_ INCHES FEET \_\_\_\_\_ INCHES  
 \_\_\_\_\_ FEET \_\_\_\_\_ INCHES FEET \_\_\_\_\_ INCHES

Formation	Color	Hard or Soft	Top	Bottom	Oil, Gas or Water	Depth Found	Remarks
Mapletown Coal			450	455			
Pittsburg Coal			550	551			
Little Dunkard Sand			920	935			
Gas Sand			1210	1220	Gas 1350' - 103M		
Gas Sand			1320	1355			
Salt Sand			1475	1575	Water 1550' - hole full		
Little Live			1800	1807			
Big Live			1812	1828			
Injun Sand			1898	2020	Gas 1944' - 1995'		
Total Depth				2023	Gas 2016' - 2022'		

