


LATITUDE 39 35

LONGITUDE 80 17 30

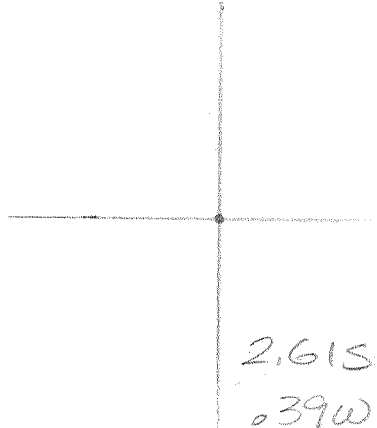

7.5 OGIS topo location

7.5' loc \_\_\_\_\_ 15' loc \_\_\_\_\_  
 (calc.) \_\_\_\_\_

Company \_\_\_\_\_

Farm J M REESE HEIDS 2

Quad MANNINGTON

County MARION

District LINCOLN

WELL LOCATION MAP

File No. 30783

J. M. RUNSE HEIRS NO. 2 WELL.

Lincoln District, Marion County, W. Va.  
 By Road Supply Co., 184 E. Main St., Salem, W. Va.  
 Abandoned under permit No. ....-A; ..... Quadrangle.  
 On 15 acres.  
 Elevation, 1297' L.  
 Surface owned by Stella W. Jones, Rt. 3, Mannington, W. Va., and  
 minerals by Jamison Coal Co., Engr. Dept., Farmington, W. Va.  
 Drilling completed Aug. 23 (1923?)  
 6 1/2" casing, 1701'; 5 1/2", 2036'; 2" tubing, 2947'; all left in.  
 Casing not cemented.  
 Coal was encountered at 295-300 and 698-706'.  
 Oil well. Record to Dept. of Mines dated Jan. 6, 1954.  
 Record to RCF from Mrs. Griffith May 10, 1954. Old file No. 886.

	Top.	Bottom.
Native coal	295	- 300
Pittsburgh Coal	698	- 706
Little Dunkard Sand	1047	- 1075
Big Dunkard Sand	1187	- 1287
Gas Sand	1428	- 1445
Salt Sands	1475	- 1690
Maxton Sand	1840	- 1860
Little Lime	1943	- 1955
Big Lime	1975	- 2033
Big Injun Sand	2033	- 2163
Squaw Sand	2172	- 2200
50-Foot Sand (gas, 2623')	2613	- 2666
30-Foot Sand	2749	- 2782
Gordon Sand (oil)	2870	- 2947 1/2
Total depth		2947 1/2



STATE OF WEST VIRGINIA  
DEPARTMENT OF MINES  
OIL AND GAS DIVISION

8886

Permit No. MAR-783-A

WELL RECORD

Oil or Gas Well \_\_\_\_\_  
(KIND)

Company Raad Supply Company  
 Address 184 East Main St., Salem, W. Va.  
 Farm J. M. Reese Heirs Acres 15  
 Location (waters) \_\_\_\_\_  
 Well No. 2 Elev. 1297  
 District Lincoln County Marion  
 The surface of tract is owned in fee by Stella E. Jones  
Rt. 3 Address Mannington, W. Va.  
 Mineral rights are owned by Jamison Coal Co.,  
Eng. Dept. Address Farmington, W. Va.  
 Drilling commenced \_\_\_\_\_  
 Drilling completed Aug 23  
 Date Shot \_\_\_\_\_ From \_\_\_\_\_ To \_\_\_\_\_  
 With \_\_\_\_\_  
 Open Flow \_\_\_\_\_ /10ths Water in \_\_\_\_\_ Inch  
 \_\_\_\_\_ /10ths Merc. in \_\_\_\_\_ Inch  
 Volume \_\_\_\_\_ Cu. Ft.  
 Rock Pressure \_\_\_\_\_ lbs. \_\_\_\_\_ hrs.  
 Oil \_\_\_\_\_ bbls., 1st 24 hrs.  
 Fresh water \_\_\_\_\_ feet \_\_\_\_\_ feet  
 Salt water \_\_\_\_\_ feet \_\_\_\_\_ feet

Casing and Tubing	Used in Drilling	Left in Well	Packers
Size			
16			Kind of Packer
13			
10			Size of
8 1/4			
6 1/2	<u>1701'</u>	<u>1701'</u>	Depth set
5 3/16	<u>2036'</u>	<u>2036'</u>	
3			Perf. top
2	<u>2947'</u>	<u>2947'</u>	Perf. bottom
Liners Used			Perf. top
			Perf. bottom

CASING CEMENTED No SIZE \_\_\_\_\_ No. Ft. \_\_\_\_\_ Date \_\_\_\_\_

COAL WAS ENCOUNTERED AT 295 FEET 60 INCHES  
698 FEET 96 INCHES FEET INCHES  
 FEET INCHES FEET INCHES

Formation	Color	Hard or Soft	Top	Bottom	Oil, Gas or Water	Depth Found	Remarks
Native Coal			295	300			
Pittsburgh Coal			698	706			
Little Dunkard			1047	1075			
Big Dunkard			1187	1287			
Gas Sand			1428	1445			
Salt Sands			1475	1690			
Maxon			1840	1860			
Little Lime			1943	1955			
Big Lime			1975	2033			
Injun			2033	2163			
Squaw			2172	2200			
50'			2613	2666	Gas	2623	
30'			2749	2782			
Gordon			2870	2947 1/2	Oil		
Total Depth				2947 1/2			

