

Latitude 30° 30'

Longitude 80° 20'

H. T. F. DAVIS
22 1/2 AC.

17 1/2 AC.

6 1/2 AC.

JACOB DAWSON
11 AC.

J. E. FISHER
30 AC.

JAS. STURM
52 1/2 AC.

RINGTOWN

JERRY F. HESS

- New Location
- Drill Dumper
- Abandonment

MA 5K 30: 3 MA 2 E 15: 18 1098 RHW


Company HOPE NATURAL GAS CO.
 Address CLARKSBURG, W. VA.
 Farm JACOB LAWSON
 Tract Acres 11 Lease No. 1033

STATE OF WEST VIRGINIA
DEPARTMENT OF MINES
OIL AND GAS DIVISION
CHARLESTON

049-
30799

LATITUDE 39 30

LONGITUDE 80 20

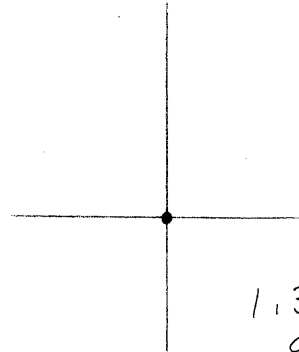

1.345
.98w

7'5 OGIS topo location

7.5' loc _____ 15' loc _____
 _____ (calc.) _____

Company _____ 9530

Farm JACOB DAWSON

Quad SHINNSTON

County MARION

District LINCOLN

WELL LOCATION MAP

File No. 30799



STATE OF WEST VIRGINIA
DEPARTMENT OF MINES
OIL AND GAS DIVISION

979

AD
Permit No. 799A

WELL RECORD

Oil or Gas Well **Gas**
(KIND)

Company Hope Natural Gas Company
Address 445 West Main Street, Clarksburg, W. Va.
Farm Jacob Dawson Acres 11
Location (waters) _____
Well No. 9530 Elev. 1124'
District Lincoln County Marion
The surface of tract is owned in fee by _____
Address _____
Mineral rights are owned by _____
Address _____
Drilling commenced No record
Drilling completed No record
Date Shot No record From _____ To _____
With _____
Open Flow _____ /10ths Water in _____ Inch
_____ /10ths Merc. in _____ Inch
Volume _____ Cu. Ft.
Rock Pressure _____ lbs. _____ hrs.
Oil None bbls., 1st 24 hrs.
Fresh water None recorded feet _____ feet
Salt water None Recorded feet _____ feet

Casing and Tubing	Used in Drilling	Left in Well	Packers
Size			
16			Kind of Packer _____
13			
10	193	193	Size of _____
8 1/4	888	888	
6 1/2	1748	1748	Depth set _____
5 3/16			
3			Perf. top _____
2		2910'	Perf. bottom _____
Liners Used			Perf. top _____
			Perf. bottom _____

CASING CEMENTED _____ SIZE _____ No. Ft. _____ Date _____
No cementing
COAL WAS ENCOUNTERED AT 335 FEET 48 INCHES
430 FEET 84 INCHES FEET INCHES
FEET INCHES FEET INCHES

Formation	Color	Hard or Soft	Top	Bottom	Oil, Gas or Water	Depth Found	Remarks
Mapletown coal			335	339	(C)		
Pittsburgh Coal			430	437			
Little Dunkard			880	900			
Gas Sand			1152	1260			
1st Salt			1286	1485			
Pencil cave			1726	1732			
BIG LIME			1732	1804			
BIG INJUN			1804	1884		Gas	1872
GORDON STRAY			2590	2645			
GORDON			2655	2665			
4th SAND			2678	2710	Gas	2685	
5th SAND			2820	2910			
Total Depth				2910'			



JACOB DAWSON NO. 9530 WELL.

Lincola District, Marion County, W. Va.
 By Hope Natural Gas Co., 445 W. Main St., Clarksburg, W. Va.
 Abandoned under permit Mar-.....-A:Quadrangle.
 On 11 acres.

Elevation, 1124' l.

No record of date of completion or shot.

No oil.

No water recorded.

10" casing, 193'; 8 $\frac{1}{2}$ " 888'; 6 $\frac{1}{2}$ " 1748'; with 2" tubing, 2910'; all left in.

No cementing.

Coal was encountered at 335-339 and 430-437'.

Gas well. Record to Dept. of Mines dated Dec. 16, 1953.

Record to RCT from Mrs. Griffith May 10, 1954. Old File No. 879.

	Top.	Bottom.
Hopletown (Sewickley) Coal	335	- 339
Pittsburgh Coal	430	- 437
Little Dunkard Sand	880	- 900
Gas Sand	1152	- 1260
1st Salt Sand	1286	- 1485
Pencil Cave	1726	- 1732
Big Line	1732	- 1804
Big Injun Sand (gas, 1872')	1804	- 1884
Gordon Stray Sand	2590	- 2645
Gordon Sand	2655	- 2665
4th Sand (gas, 2685')	2678	- 2710
5th Sand	2820	- 2910
Total depth		2910