

New Location...

Drill Deeper.....

Abandonment.....

Company South Penn Natural Gas Co.

Address Parkersburg, W. Va.

Farm Sarah Yost

Tract _____ Acres 250[±] Lease No. 6782

Well (Farm) No. 3 Serial No. _____

Elevation (Spirit Level) 1168.6 Ground

Quadrangle Mannington

County Marion District Mannington

Engineer Wm. D. Hayes

Engineer's Registration No. 1429

File No. _____ Drawing No. _____

Date Oct. 31, 1955 Scale 1" = 800'

STATE OF WEST VIRGINIA
DEPARTMENT OF MINES
OIL AND GAS DIVISION
CHARLESTON

WELL LOCATION MAP
FILE NO. MAR-822-A

⊕ Denotes location of well on United States Topographic Maps, scale 1 to 62,500, latitude and longitude lines being represented by border lines as shown.

— Denotes one inch spaces on border line of original tracing.

SARAH YOST No. 3 — SOUTH PENN N.G. CO. — MAR-822A



STATE OF WEST VIRGINIA
DEPARTMENT OF MINES
OIL AND GAS DIVISION

908

WELL RECORD

Oil or Gas Well Oil
(KIND)


Permit No. 8022
Company SOUTH PENN NATURAL GAS COMPANY
Address P. O. Box 1280, Parkersburg, W. Va.
Farm Sarah Yost (Youst) Acres 250
Location (waters) Pyle Fork
Well No. 3 Elev. 1168.6 Gr.
District Mannington County Marion
The surface of tract is owned in fee by Chas. W. Snodgrass
Address Mannington, W. Va.
Mineral rights are owned by Tony P. Underwood, et al.
Address Fairview, W. Va.
Drilling commenced May 6, 1896
Drilling completed Aug. 9, 1897
Date Shot 6-23-15 From ? To ?
With 1-9-18 30 Qts. and 40 Qts.

Casing and Tubing	Used in Drilling	Left in Well	Packers
Size			Kind of Packer
16			
13			
10	450'	450'	Size of
8 1/4	1375'	1375'	Depth set
6 5/8	1812'	1812'	
5 3/16	2250'	2250'	Perf. top
3			Perf. bottom
2			Perf. top
Liners Used			Perf. bottom
4 1/2" x 4"	777'		

Open Flow /10ths Water in _____ Inch
/10ths Merc. in _____ Inch
Volume _____ Cu. Ft.
Rock Pressure _____ lbs. _____ hrs.
Oil _____ bbls., 1st 24 hrs.
~~Water~~ water 2170' feet
Salt water _____ feet

CASING CEMENTED _____ SIZE _____ No. Ft. _____ Date _____
COAL WAS ENCOUNTERED AT 796 FEET ? INCHES
_____ FEET _____ INCHES
_____ FEET _____ INCHES

Formation	Color	Hard or Soft	Top	Bottom	Oil, Gas or Water	Depth Found	Remarks
Pittsburgh Coal			796				
Bankard Sand			1390	1450			
Gas Sand			1465	1620			
Salt Sand			1735	1800			
Sand			1810	1835			
Big Lime			2000	2100			
Big Injun			2100	2250			
					Show of water & gas	2170	
Santz			2569	2669			
Fifty Foot			2669	2725			
Thirty Foot			2840	2855			
Stray Sand			2855	2995			
Gordon			2995				
					First Pay	3009	
					Second Pay	3013	
TOTAL DEPTH				3039			
DRILLING DEEPER BEGAN - July 12, 1907 - COMPLETED JULY 28, 1907							
					Gas	3059	
Fourth Sand				3063			
TOTAL DEPTH				3083			

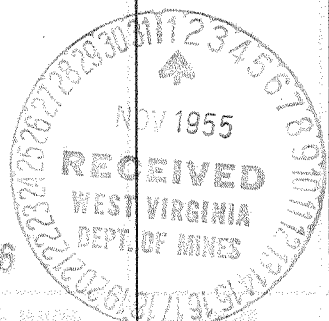

JAN 23 1956

