


Latitude 39° 35'

Longitude 80° 20'

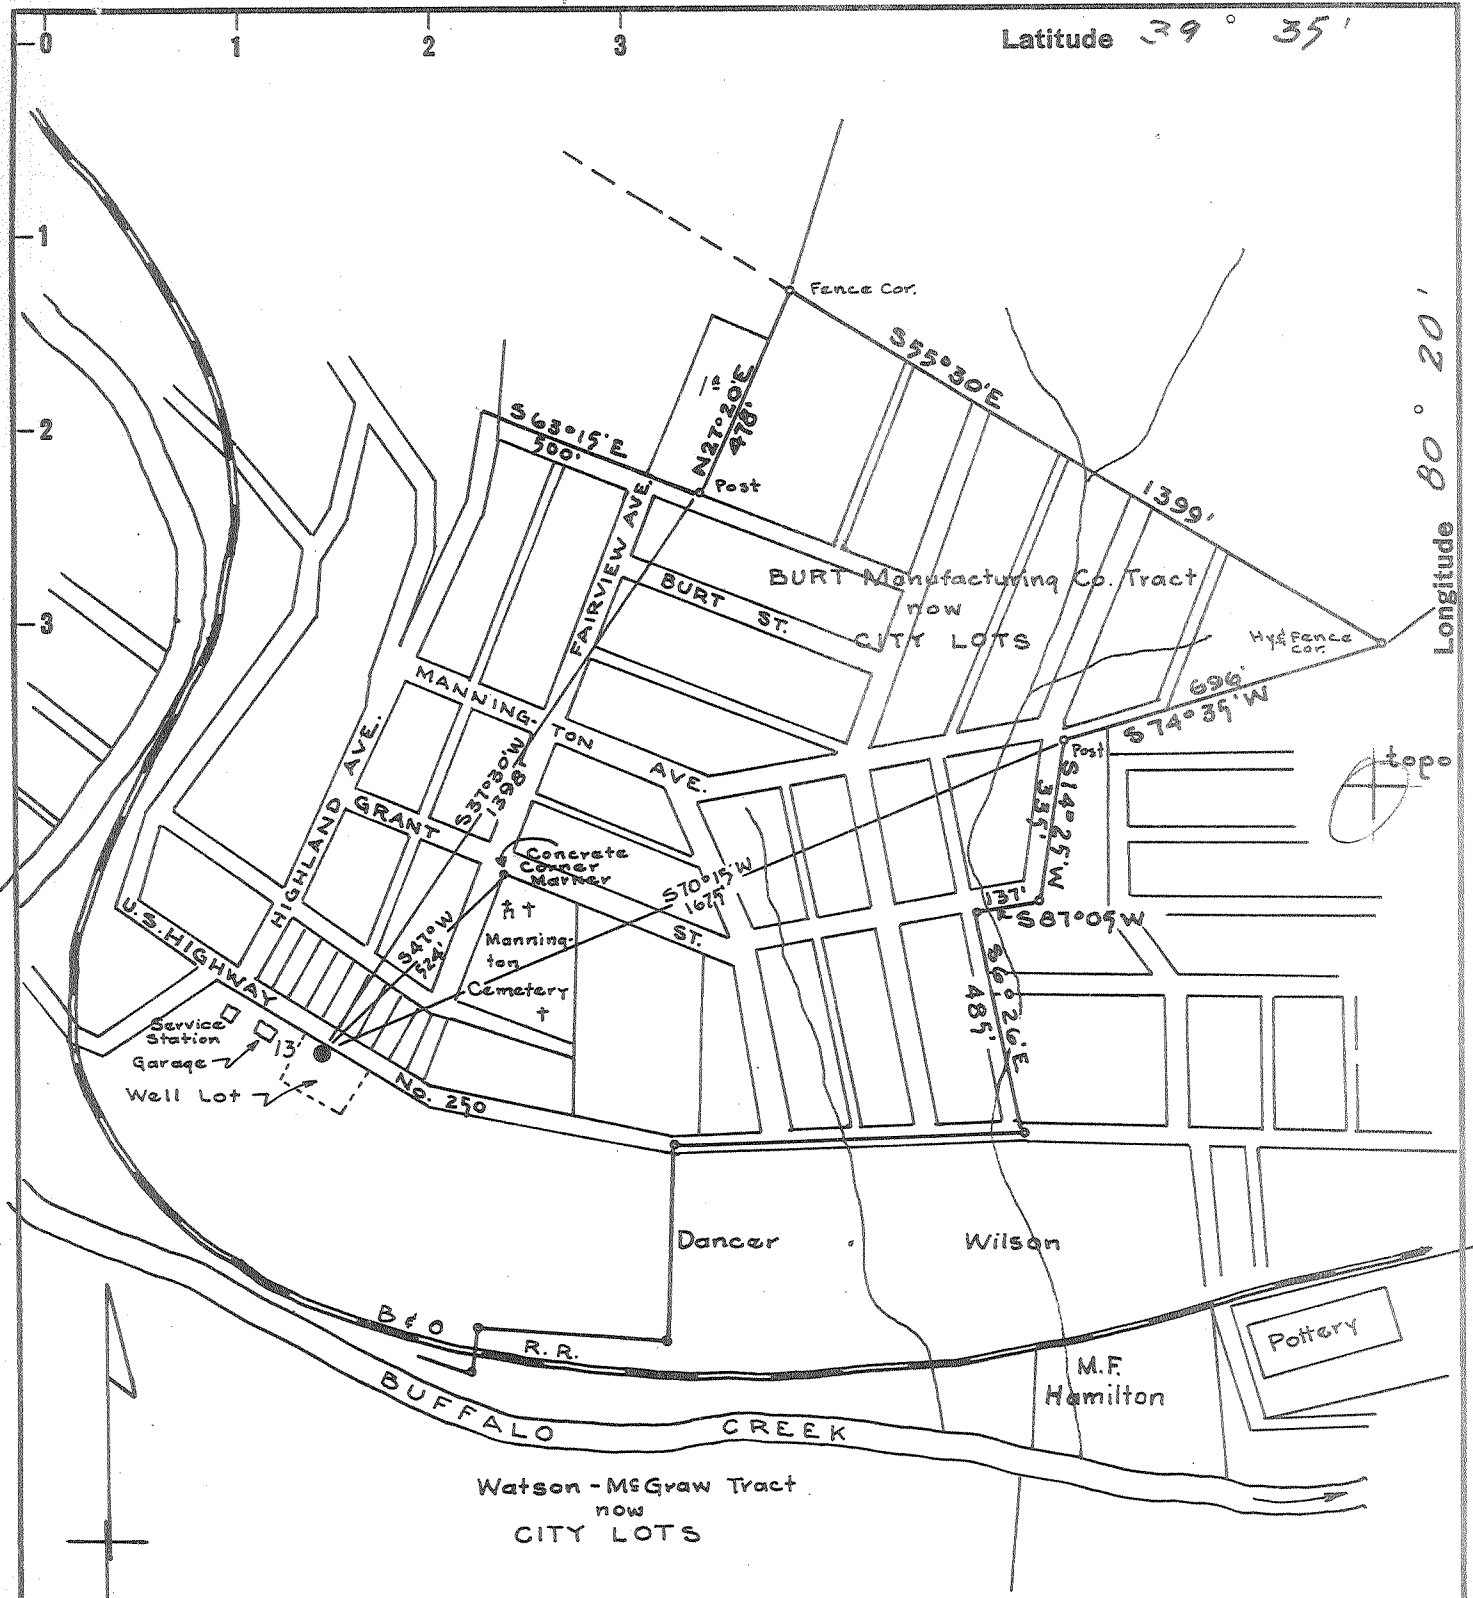

Coal & Surface: Burt Reality Co., % Ivan A. Robinson,
 Water St., Mannington, W. Va.

4.005 0.44W
 0.44W 5/05

New Location
 Drill Deeper
 Abandonment

APR 11 1960

Map N51E N5 E16

Company	SOUTH PENN OIL CO.
Address	PARKERSBURG, W.VA.
Farm	BURT MANUFACTURING CO.
Tract	Acres 83 Lease No. 57836
Well (Farm) No.	13 Serial No.
Elevation (Spirit Level)	973.72' ground
Quadrangle	MANNINGTON
County	MARION District MANNINGTON
Engineer	A.C. Hill
Engineer's Registration No.	2534
File No.	85 Drawing No.
Date	MAR. 4, 1960 Scale 1" = 400'

STATE OF WEST VIRGINIA
 DEPARTMENT OF MINES
 OIL AND GAS DIVISION
 CHARLESTON

WELL LOCATION MAP
 FILE NO. MAR-877-A

+ Denotes location of well on United States Topographic Maps, scale 1 to 62,500, latitude and longitude lines being represented by border lines as shown.

- Denotes one inch spaces on border line of original tracing.