


Latitude 39 ° 35 '

Longitude 80 ° 10 '

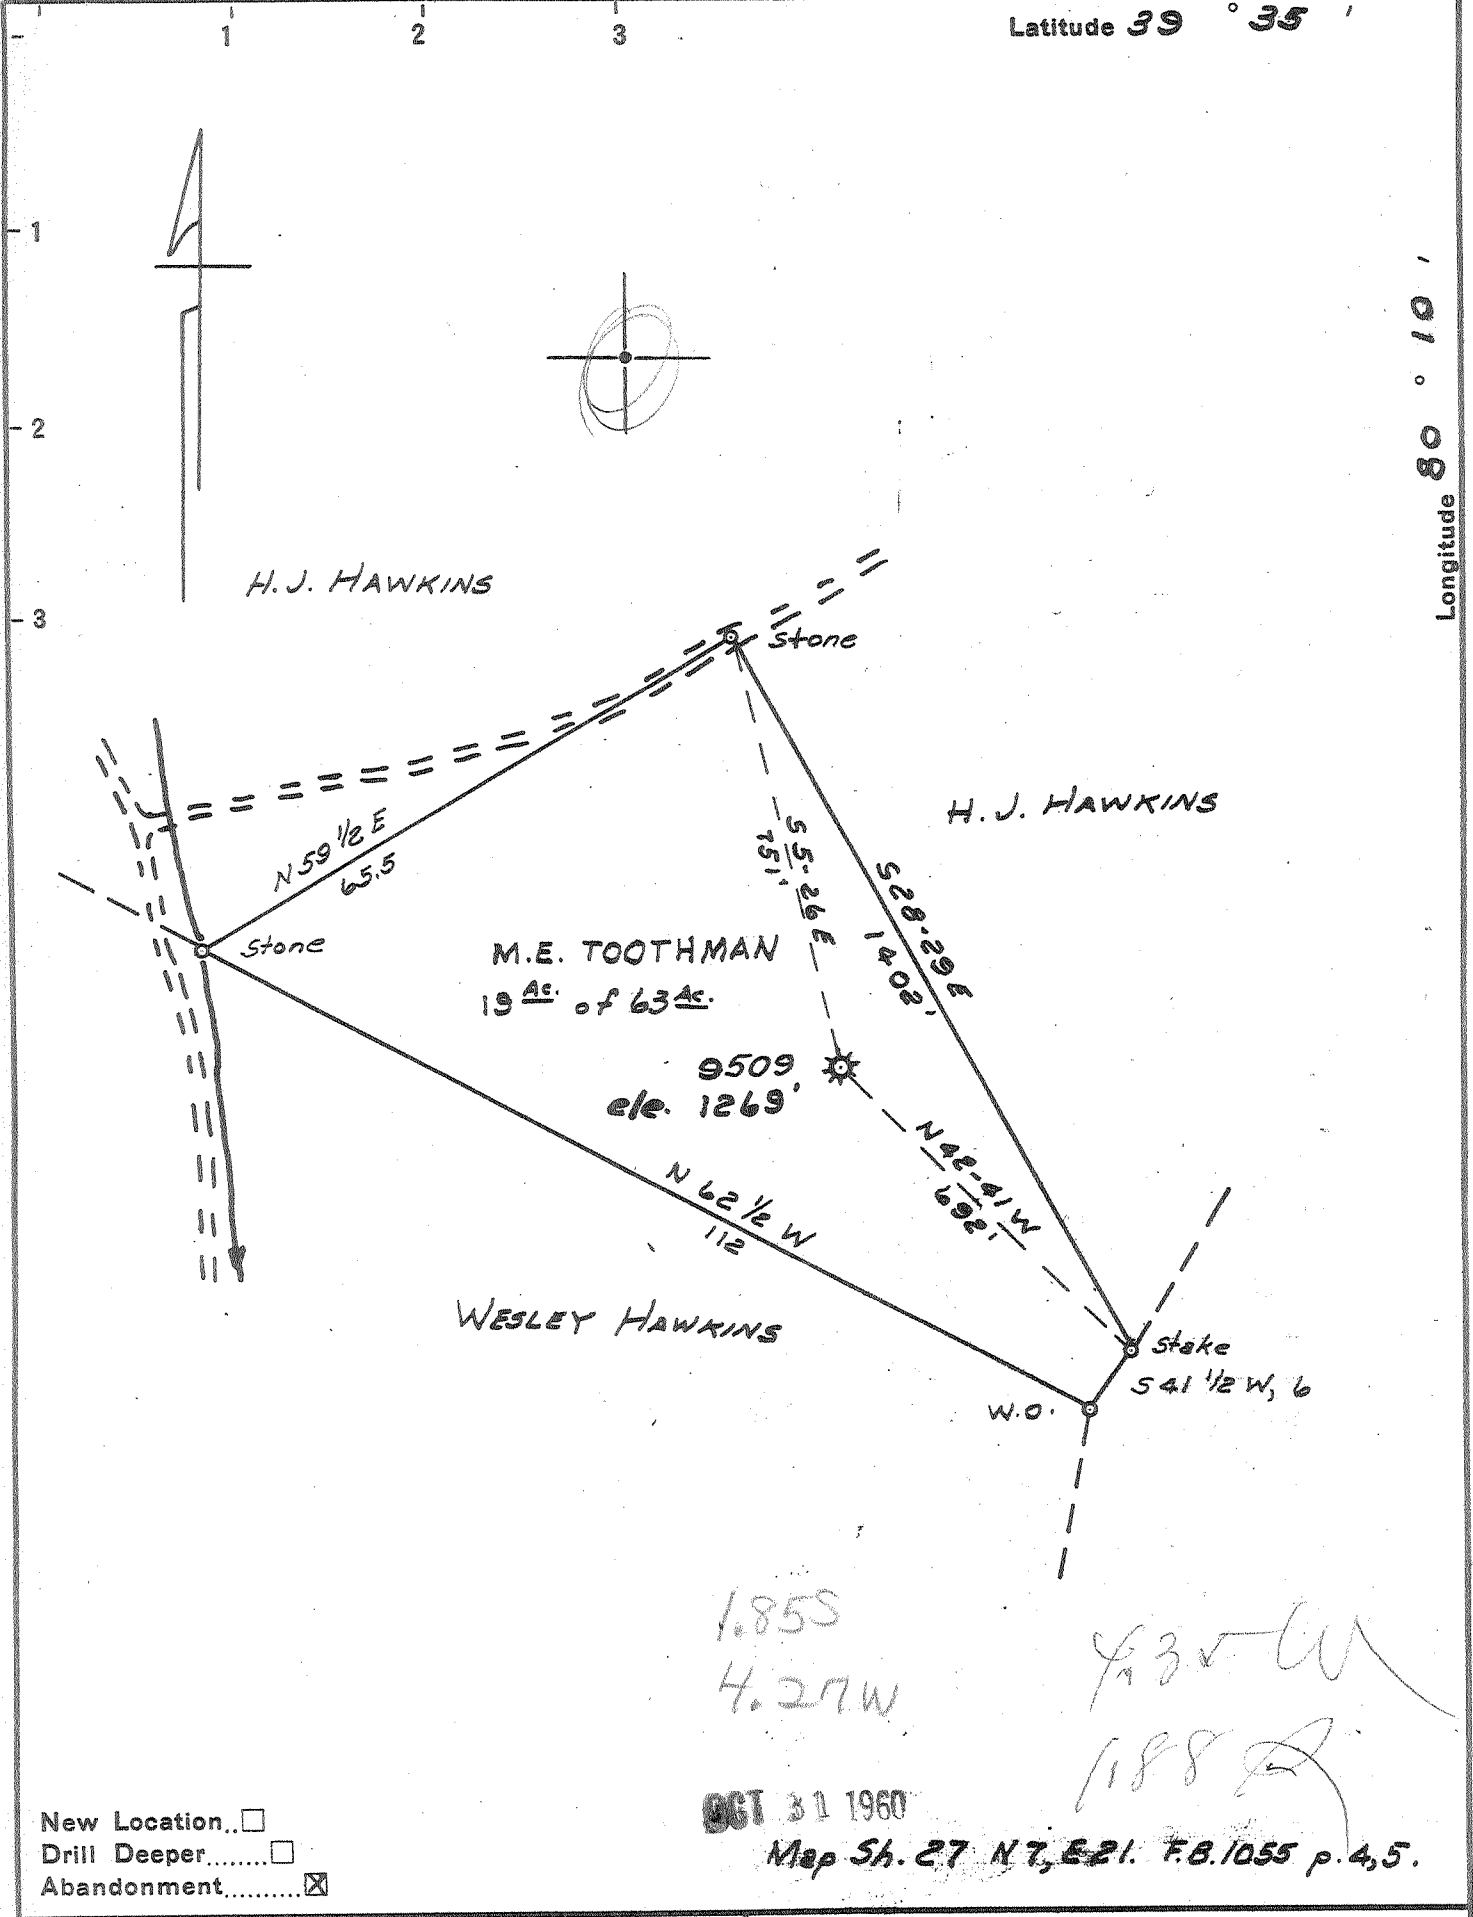

New Location...

Drill Deeper...

Abandonment...

Company HOPE NATURAL GAS CO.

Address CLARKSBURG W. VA.

Farm M.E. TOOTHMAN

Tract _____ Acres 63 Lease No. 61815

Well (Farm) No. _____ Serial No. 9509

Elevation (Spirit Level) 1269

Quadrangle BLACKSVILLE

County MARION District LINCOLN

Engineer Guy A. Bradley

Engineer's Registration No. 2425

File No. _____ Drawing No. _____

Date 10-7-60 Scale 1" = 200' as

STATE OF WEST VIRGINIA
DEPARTMENT OF MINES
OIL AND GAS DIVISION
CHARLESTON

WELL LOCATION MAP
FILE NO. MAR-888-A

+ Denotes location of well on United States Topographic Maps, scale 1 to 62,500, latitude and longitude lines being represented by border lines as shown.

- Denotes one inch spaces on border line of original tracing.

M.E. TOOTHMAN NO. 9509 - HOPE Nat. Gas Co. - MAR-888-A