Longitude

Completed 1914

TID 3190' -probaby 5th sd.

Rept mines annual Report, 1961

Topo Location

Latitude

7.5' Loc.______ 15' Loc._____ (calc.)

Company ____

Farm _____


15' Quad ______(sec.)

7.5' Quad Shunnston

District Luncoln

WELL LOCATION PLAT

County 649 Permit 30889

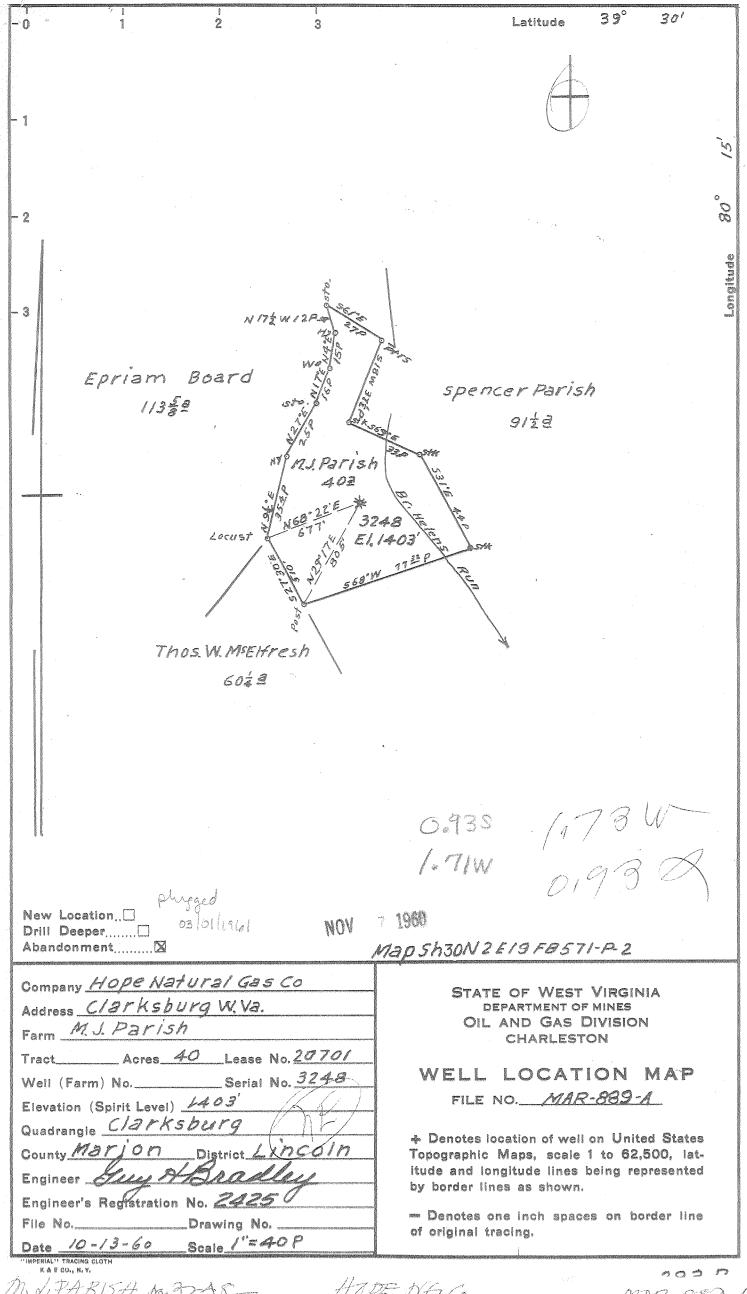

7. J. PAR15H 10-37-48-

HOPE NE, Co. _

MAR-889-A