

Company Road Supply Co
 Address Salem, West Virginia
 Farm H.C. Ogden
 Tract _____ Acres 48 Lease No. _____
 Well (Farm) No. 66 Serial No. _____
 Elevation (Spirit Level) 920
 Quadrangle Clarksburg
 County Marion District Grant
 Engineer C.C. Fittro G.E.
 Engineer's Registration No. 818
 File No. XYZ Drawing No. 81
 Date June 14, 1937 Scale 1" = 300'

STATE OF WEST VIRGINIA
 DEPARTMENT OF MINES
 OIL AND GAS DIVISION
 CHARLESTON

WELL LOCATION MAP
 FILE NO. MAR-894-A

+ Denotes location of well on United States Topographic Maps, scale 1 to 62,500, latitude and longitude lines being represented by border lines as shown.
 - Denotes one inch spaces on border line of original tracing.



STATE OF WEST VIRGINIA
DEPARTMENT OF MINES
OIL AND GAS DIVISION

933

Qual Clarksburg
894A

WELL RECORD

Permit No. 894A

Oil or Gas Well _____
(KIND)


Company Rad Supply Co.
Address 184 East Main St. - Salem, W. Va.
Farm H. C. Ogden Acres 48
Location (waters) _____
Well No. 66 (1) Elev. 920
District Grant County Marion
The surface of tract is owned in fee by H. C. Ogden Heirs
Address _____
Mineral rights are owned by Mountaineer Coal Co.
Address Fairmont, W. Va.
Drilling commenced 2-9-11
Drilling completed 5-4-11
Date Shot _____ From _____ To _____
With _____
Open Flow _____ /10ths Water in _____ Inch
_____ /10ths Merc. in _____ Inch
Volume _____ Cu. Ft.
Rock Pressure _____ lbs. _____ hrs.
Oil _____ bbls., 1st 24 hrs.
Fresh water _____ feet _____ feet
Salt water _____ feet _____ feet

Casing and Tubing	Used in Drilling	Left in Well	Packers
Size			Kind of Packer
16			
13			
10	107'		Size of
8 1/4	580'		
6 3/4	1124'		Depth set
5 3/16	1510'		
3	2470'		Perf. top
2			Perf. bottom
Liners Used			Perf. top
			Perf. bottom

CASING CEMENTED _____ SIZE _____ No. Ft. _____ Date _____

COAL WAS ENCOUNTERED AT 77 FEET 84 INCHES
_____ FEET _____ INCHES _____ FEET _____ INCHES
_____ FEET _____ INCHES _____ FEET _____ INCHES

Formation	Color	Hard or Soft	Top	Bottom	Oil, Gas or Water	Depth Found	Remarks
Pittsburgh Coal			70	77			
Big Injun Sand			1470	1545			
Gordon Stray Sand			2260	2280			
Gordon Sand			2305	2320			
Bayard Sand			2470	2518			
Total Depth			2500 2518				

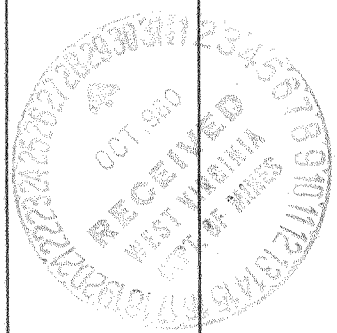

AUG 2 1961

(Over)

