


Latitude 39° 40'

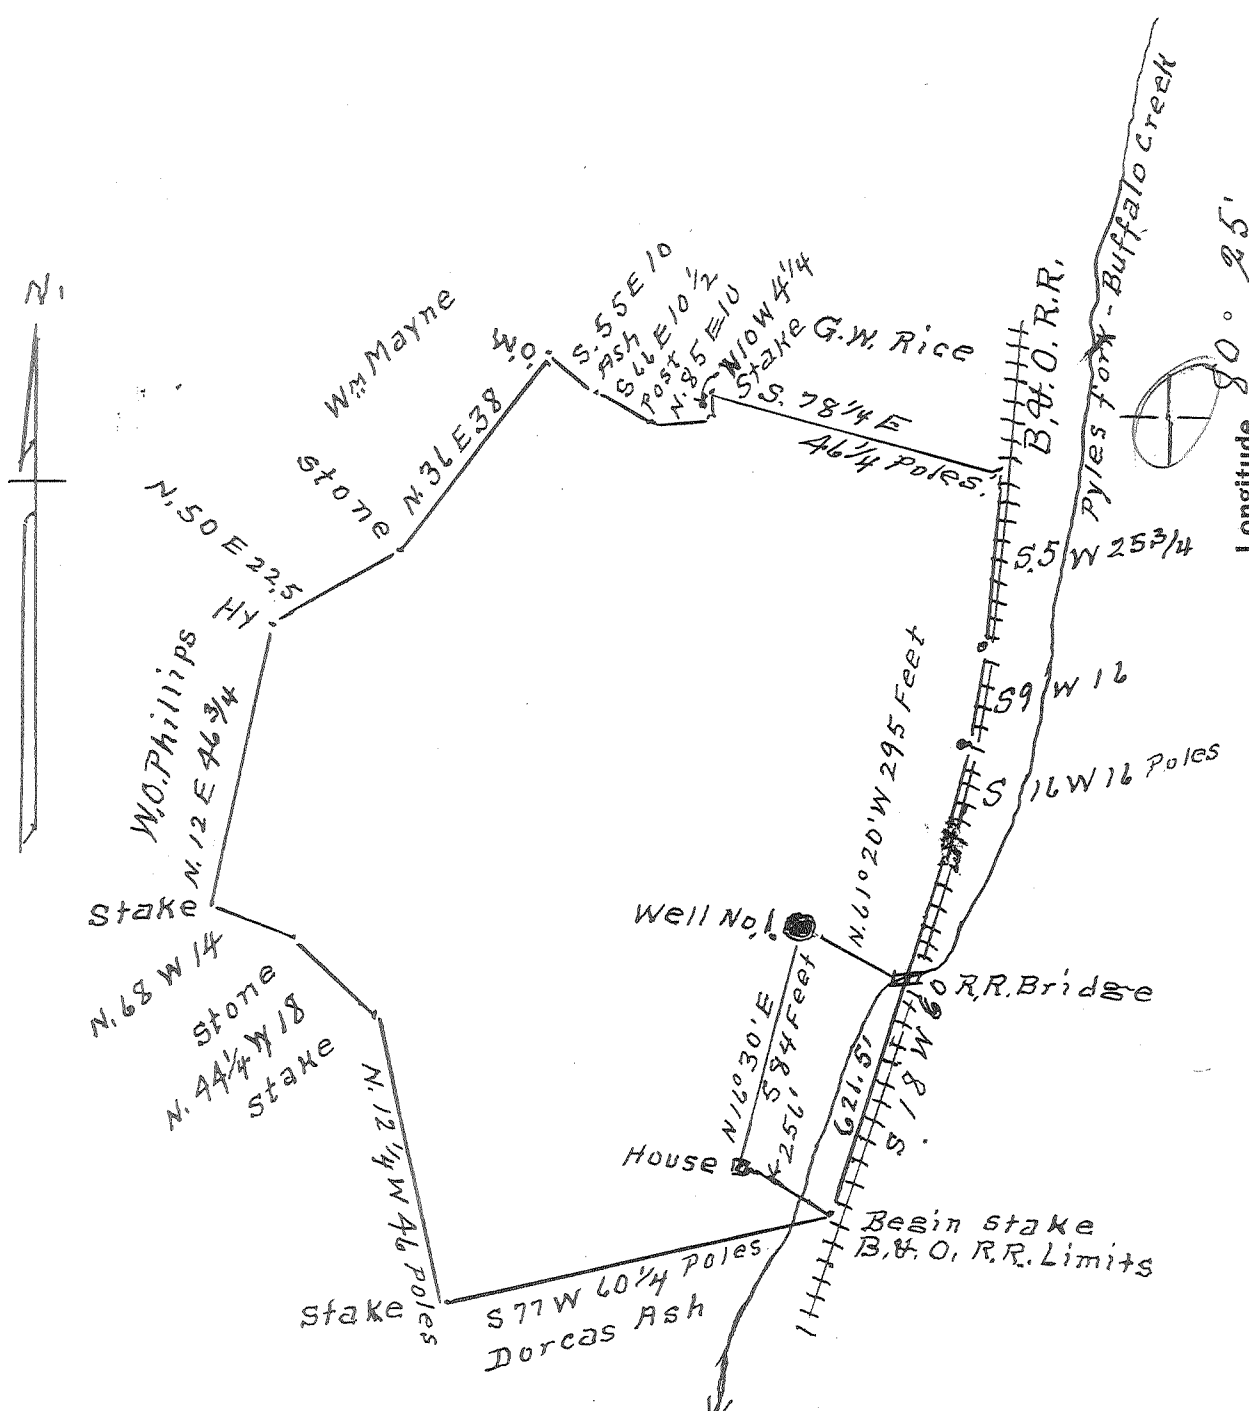

O.V.W.  
2.455  
2.15

Surface = Nellie Byard Murphy  
Cameron, W. Va.  
Coal = Little Kanawha Synd.  
% B.G. Sampson, Eng. Co.  
P.O. Box 368 Fairmont W. Va.

New Location   
Drill Deeper   
Abandonment

DEC 26 1962

Company Cecil Chisler & Son  
 Address R. #2, Fairview W. Va.  
 Farm Mary J. Wells  
 Tract 1 Acres 64 Lease No. \_\_\_\_\_  
 Well (Farm) No. ONE Serial No. \_\_\_\_\_  
 Elevation (Spirit Level) 1226.  
 Quadrangle Mannington  
 County Marion District Mannington  
 Engineer A. L. Headley  
 Engineer's Registration No. 2021  
 File No. \_\_\_\_\_ Drawing No. \_\_\_\_\_  
 Date 11-28-62 Scale 1" = 500'

STATE OF WEST VIRGINIA  
DEPARTMENT OF MINES  
OIL AND GAS DIVISION  
CHARLESTON

WELL LOCATION MAP  
FILE NO. MAR-910-A

+ Denotes location of well on United States Topographic Maps, scale 1 to 62,500, latitude and longitude lines being represented by border lines as shown.

- Denotes one inch spaces on border line of original tracing.

MARY J. WELLS TR. 1 - CECIL CHISLER & SON - MAR-910-A