

39°35'00"

Latitude

80°10'00"



Longitude

Topo Location

7.5' Loc. _____ 15' Loc. _____
 _____ (calc.) _____

Company _____

Farm _____


15' Quad _____
(sec.)

7.5' Quad Grant Town

District Paw Paw

WELL LOCATION PLAT

County 049 Permit 30916

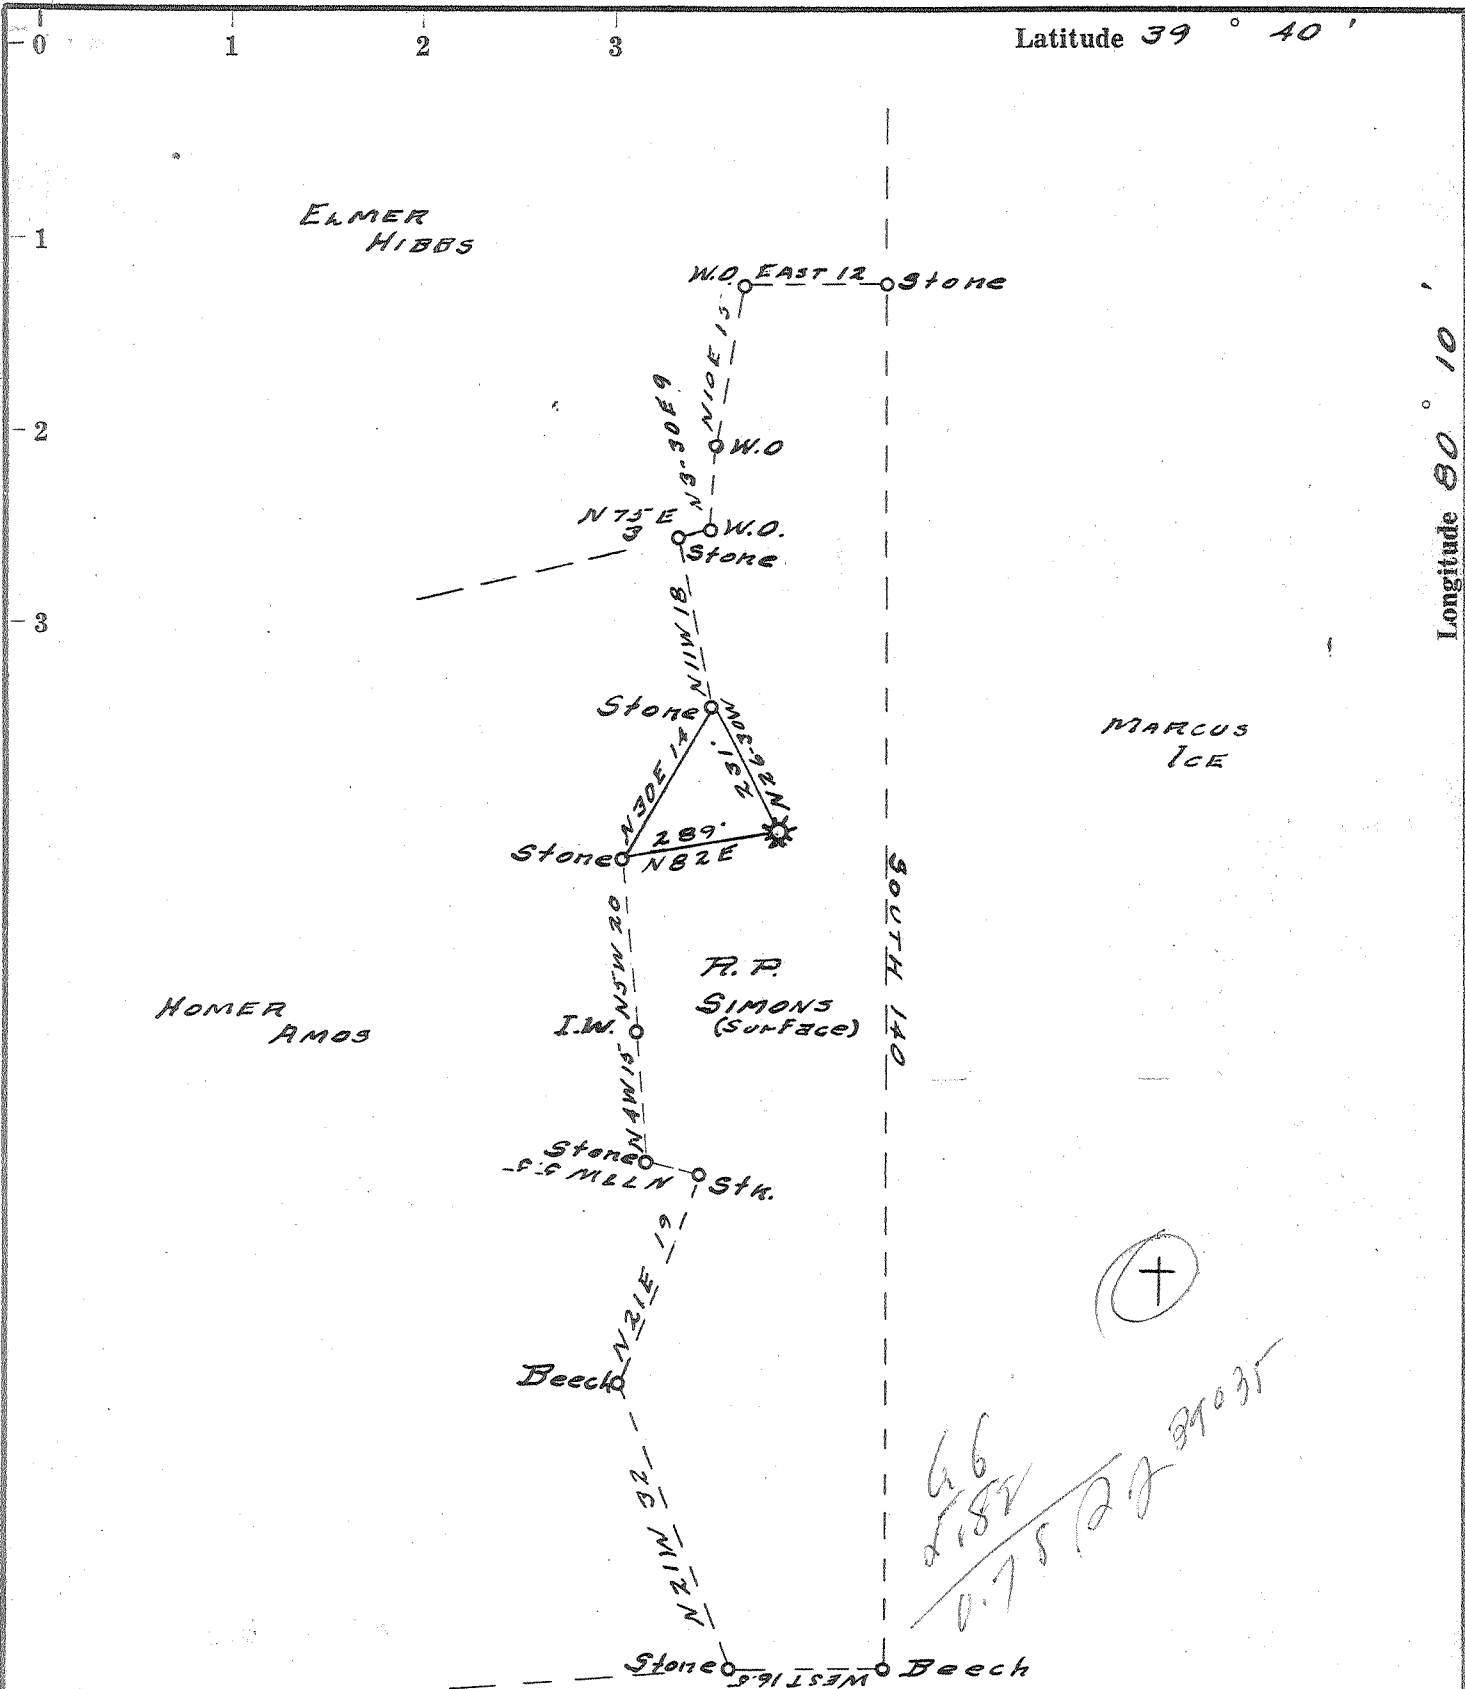

- New Location.
- Drill Deeper.
- Redrill.
- Abandonment.

Company CARNEGIE NATURAL GAS

Address MUNHALL PA.

Farm ARLENA HIBBS

Tract _____ Acres 175 Lease No. E/2881-42

Well (Farm) No. _____ Serial No. E-1409

Elevation (Spirit Level) 996

Quadrangle BLACKSVILLE S.W.

County MARION District PAW PAW

Engineer John O. Cook

Engineer's Registration No. 1250

File No. _____ Drawing No. _____

Date 8-7-63 Scale 1" = 20 Feet = 330'

SEP 16 1963

STATE OF WEST VIRGINIA
DEPARTMENT OF MINES
OIL AND GAS DIVISION
CHARLESTON

WELL LOCATION MAP

FILE NO. MAR-916-A

+ Denotes location of well on United States Topographic Maps, scale 1 to 62,500, latitude and longitude lines being represented by border lines as shown.

— Denotes one inch spaces on border line of original tracing.