


Original 261.3 Ac. tract owned by Joseph Hayhurst
 Tract-1 Roy Starkey 46.5 Acres D.B. 181 P.296
 Tract-2 Roy Starkey 56.5 Acres D.B. 181 P.296
 Tract-3 Richard Thorne 157.3 Acres D.B. 749 P.177

Coal under original 261.3 Ac. tract owned by
 Consolidation Coal Co. Inc., Monongah W. Va.
 Mountaineer Division

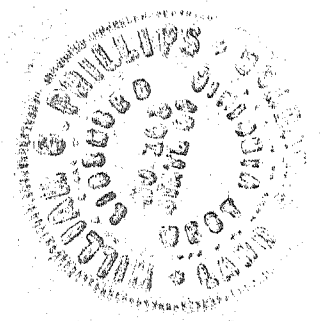

COAL OWNED BY Consolidation Coal Co. Inc., Monongah W. Va.

- NEW LOCATION
- RECONDITION
- DRILL DEEPER
- ABANDONMENT

"I, the undersigned, hereby certify that this map is correct to the best of my knowledge and belief and shows all the information required by paragraph 6 of the rules and regulations of the oil and gas section of the mining laws of West Virginia."
 Minimum degree of accuracy is one part in 2500

Signed *William G. Phillips*

issued 3-20-72

COMPANY	A. E. & M. W. BISSETT		
ADDRESS	DEEP VALLEY, PENNA.		
FARM	JOSEPH HAYHURST		
MAP	ACRES	LEASE NO.	
	261.3		
WELL (FARM) NO.	6 HAYHURST	SERIAL NO.	
ELEVATION (SPIRIT LEVEL)	1085.3		
QUADRANGLE	MANNINGTON, W.V. PA. SW		
COUNTY	MARION	DISTRICT	MANNINGTON
POINT OF PROVEN ELEVATION	INTERSECTION OF ROAD ELEV. = 1055 WARRIOR FORK		
FILE NO.	DRAWING NO.		
DATE	FEB. 15, 1972	SCALE	1" = 800'

STATE OF WEST VIRGINIA
 DEPARTMENT OF MINES
 OIL AND GAS DIVISION
 CHARLESTON
 WELL LOCATION MAP

FILE No. *Mar-954(a)*

+ DENOTES LOCATION OF WELL ON UNITED STATES TOPOGRAPHIC MAPS. SCALE 1 TO 62,500. LATITUDE AND LONGITUDE LINES BEING REPRESENTED BY BORDER LINES AS SHOWN.

- DENOTES ONE INCH SPACES ON BORDER LINE OF ORIGINAL TRACING.

MAR 27 1972

STATE OF WEST VIRGINIA
DEPARTMENT OF MINES
OIL AND GAS DIVISION

RL-7
JUN 28 1972

AFFIDAVIT OF PLUGGING AND FILLING OIL AND GAS DIVISION
WELLS IN MINES

AFFIDAVIT SHOULD BE MADE IN TRIPPLICATE, ONE COPY MAILED TO THE DEPARTMENT, ONE COPY TO BE RETAINED BY THE WELL OPERATOR AND THE THIRD COPY (AND EXTRA COPIES IF REQUIRED) SHOULD BE MAILED TO EACH COAL OPERATOR AT THEIR RESPECTIVE ADDRESSES.

MOUNTAINEER COAL Co.
COAL OPERATOR OR OWNER
Box 1632 Fairmont W. Va.
ADDRESS

A. E. & M. W. BISSETT
NAME OF WELL OPERATOR
Deep Valley Pa. 15352
COMPLETE ADDRESS

COAL OPERATOR OR OWNER
ADDRESS

6/23/72 19
WELL AND LOCATION
Mannington ~~WV~~ District

RAY STARKEY
LEASE OR PROPERTY OWNER
Mannington W. Va. R. F. D.
ADDRESS

Marion County
Well No. 6
Joseph Hayhurst Farm
Wm. Blosser

STATE INSPECTOR SUPERVISING PLUGGING

AFFIDAVIT

STATE OF WEST VIRGINIA,
County of _____ } ss:
M. W. Bissett

and A. E. Bissett

being first duly sworn according to law depose and say that they are experienced in the work of plugging and filling oil and gas wells and were employed by A. E. & M. W. Bissett, well operator, and participated in the work of plugging and filling the above well, that said work was commenced on the 5 day of April, 1972, and that the well was plugged and filled in the following manner:

SAND OR ZONE RECORD	FILLING MATERIAL	PLUGS USED		CASING	
		SIZE & KIND		CSS PULLED	CSS LEFT IN
Filled Hole With	Gell				
Cement Plug	10' at 1950	5" 1933		1933	none
Parted 7" Casing	at 1410				
Natural Fill	to 1350	7" 1935		1410	525
Cement Plug	10' at 1350	8" 1233		783	450
Parted 8" Casing	at 783				
Set vent packer	on casing at 783				
2" vent from packer	to surface.				
Cement plug	10' on top of vent packer,				
Clay from	773' to ### 10'				
Cement from	10' to surface				
COAL SEAMS		DESCRIPTION OF MONUMENT			
(NAME)		2" Casing 3" above surface			
(NAME)		cement, 2" coal vent 1' above			
(NAME)		2"			
(NAME)					

and that the work of plugging and filling said well was completed on the 23 day of June, 1972.

And further deponents saith not.

Sworn to and subscribed before me this 26 day of June, 1972.

M. W. Bissett
A. E. Bissett
Kathryn L. Poase
Notary Public.

My commission expires:
by Commission Expires July 2, 1979.

Permit No. 951 (A)

JUL 11 1972