


LATITUDE 39 35

LONGITUDE 80 17 30

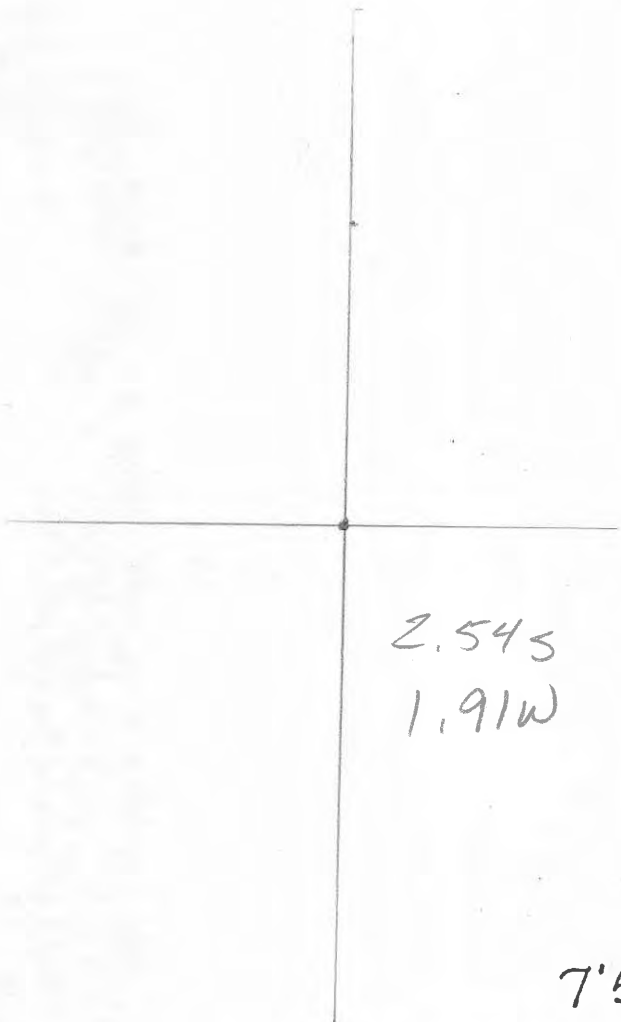

2.545

1.91W

T'S OGIS topo location

7.5' loc _____

15' loc _____
(calc.) _____

Company _____

Farm EA BLACKSHERE 7

Quad MANNINGTON

County MARION

District MANNINGTON

WELL LOCATION MAP

File No. 70033

MAR-

70033

E. A. Blackmore No. 7 Well.

Hannington District, Marion County, W. Va.

By South Penn Natural Gas Co.

On 470 acres.

Elevation: Derrick floor, 1187.70'; ground, 1185.40'.

Drilling commenced October 12, 1903; completed December 24, 1903.

7

	Top. Fathom.
Conductor	0 - 16
Pittsburgh Coal	640 - ...
Salt Sand	1950 - 1940
Big Linc	1905 - 1905
Big Injun Sand	1955 - 2005
Total depth	2039

Initial production - 7 bbls. per day.

Abandoned November 22, 1910.