


LATITUDE 39 35

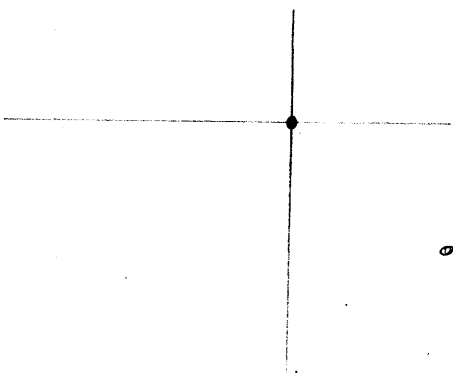

0.625
1.89

LONGITUDE 89 12 30

7'5 OGIS topo location

7.5' loc	<u>0.625</u>	15' loc	_____
	<u>1.89W</u>	(calc.)	_____

Company _____

Farm GW BROWN 1

Quad GRANT TOWN

County MARION

District PAW PAW

WELL LOCATION MAP

File No. 70037

G. W. BROWN NO. 1 WELL.

70037

No. 84 O.P.-Marion
No. 566 M-M-T Rept.,
tabulated only.

Pawpaw District, Marion County, W. Va.

By Fisher Oil Co.

On 96 acres, 2 mi. south of Fairview.

Elevation, 1185' B.

Commenced Dec. 15, 1902; completed, Feb. 19, 1903.

Got gas at 1892'; Gordon Sand, shell and slate.

E. M. Smith, contractor.

12' conductor; 10" casing, 420'; 8 $\frac{1}{2}$ " 964'; 6-5/8" 1370';

5-3/16" 1970' (pulled) (letter Mar. 3, 1904).

566 MMT
Co Rep



	Top.	Bottom.
Pittsburgh Coal		464
Big Injan Sand (top pay, 1892')		1892
Fifty-foot Sand		2365 - 2410
Gordon Sand (little gas, 2687')		2685
Fifth Sand (gas)		2838
Total depth		2929